


NOTE: SIDEWALK AND BRICK BEYOND RIGHT OF WAY TO BE CONSTRUCTED BY OTHERS WITH THE ADDISON CIRCLE APARTMENTS PRIVATE DEVELOPMENT. CONTRACTOR SHALL COORDINATE INTERFACE IN FIELD. SEE SIDEWALK DETAILS IN THIS PLAN SET.

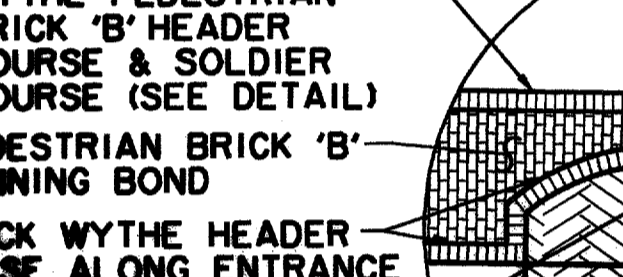

BRICK TYPES


- VEHICULAR BRICK "A" - 2 5/8"x4"x8" (COCOA)
- VEHICULAR BRICK "B" - 2 5/8"x4"x8" (K&W OLD SMOKIE)
- VEHICULAR BRICK "C" - 2 5/8"x3 1/2"x7 1/2" (ACME)
- PEDESTRIAN BRICK "A" - 2 1/4"x4"x8" (BROWN)
- PEDESTRIAN BRICK "B" - 2 1/4"x4"x8" (AUTUMN HAZE)

LEGEND

ELECTRIC	— OHE —	48" RCP	MISC.
○	LIGHT POLE	—	EX. STORM SEWER
PP	POWER POLE	—	CHAIN LINK FENCE
—	GUY WIRE	—	WOOD FENCE
TELEPHONE	— T —	—	EXISTING ASPHALT
○	TELEPHONE MANHOLE	—	EXISTING DIRT OR GRAVEL
□	TELEPHONE PEDESTAL	—	EX. CONCRETE
TS	TELEPHONE SIGN	—	TREE/TREE LINE
GM	GAS	— G —	EXISTING CURB
GS	GAS METER	—	PROP. CURB
GS	GAS SIGN	—	PROP. EDGE OF PAVEMENT NO CURB
R/R	RAILROAD SIGN	—	EX. PROPERTY LINE
○	SIGN	—	PROP. CENTERLINE
—	SURVEY	—	PROP. R.O.W.
I.R.	FOUND IRON ROD	—	PROP. INLET
□	TEMP BENCHMARK	T.P.	TOP OF PAVEMENT
—	WASTEWATER	C.R.	TOP OF CURB
○	WASTEWATER MANHOLE	C.R.	CURB RETURN
○	CLEANOUT	EX. G	EXISTING GUTTER
○	WATER	—	BORING LOCATION
FH	FIRE HYDRANT	—	B-20
WM	METER	—	
T	WATER VALVE	—	

BRICK TYPES

- VEHICULAR BRICK "A" - 2 5/8"x4"x8" (COCOA)
- VEHICULAR BRICK "B" - 2 5/8"x4"x8" (K&W OLD SMOKIE)
- VEHICULAR BRICK "C" - 2 5/8"x3 1/2"x7 1/2" (ACME)
- PEDESTRIAN BRICK "A" - 2 1/4"x4"x8" (BROWN)
- PEDESTRIAN BRICK "B" - 2 1/4"x4"x8" (AUTUMN HAZE)

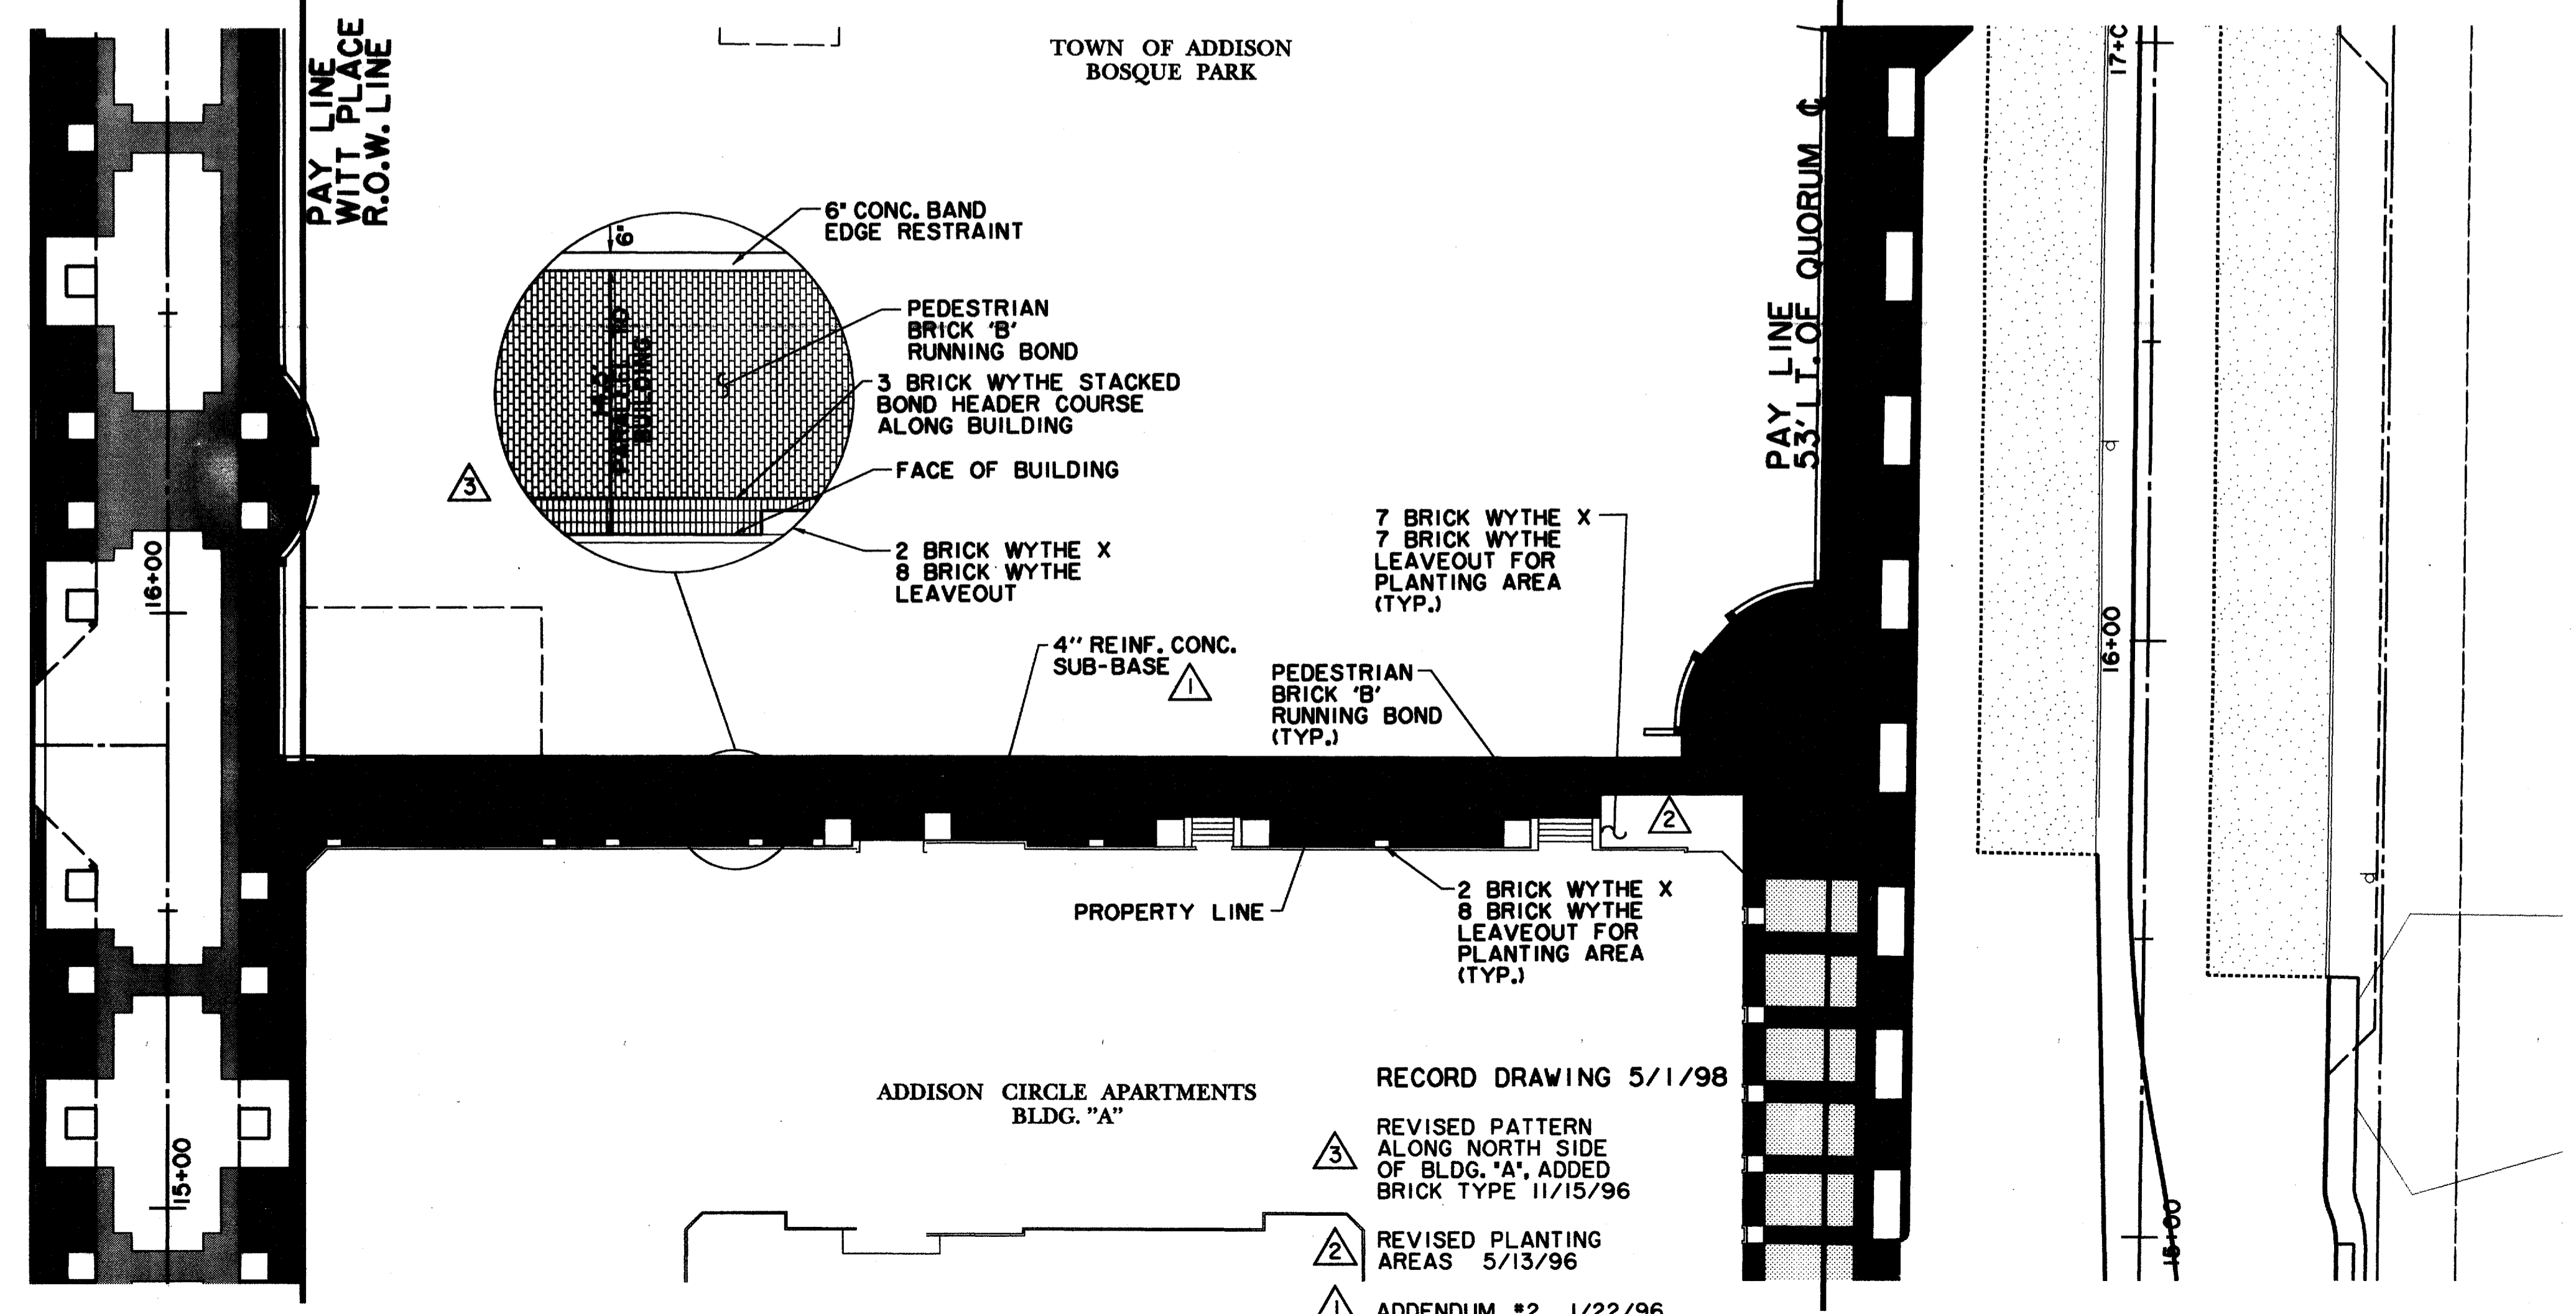

BENCHMARKS:

BM#2
 "I" CUT AT CENTER BACK OF CURB OF INLET, 200 FEET NORTH FROM THE CENTERLINE INTERSECTION OF ADDISON CIRCLE, WEST SIDE OF QUORUM DRIVE.
 ELEV. 621.68

BM#3
 "I" CUT AT CENTER BACK OF CURB OF INLET, 620 FEET NORTH FROM THE CENTERLINE INTERSECTION OF ADDISON CIRCLE, WEST SIDE OF QUORUM DRIVE.
 ELEV. 624.50

ISSUED FOR CONSTRUCTION
 MARCH 28, 1996

THE SEAL APPEARING ON THIS DOCUMENT WAS AUTHORIZED BY
 KENNETH A. ROBERTS, P.E. 55446
 ON MARCH 28, 1996.

SURFACE PATTERNING PLAN
 GOODMAN AVENUE, BEHIND BOSQUE PARK
ADDISON CIRCLE
 PHASE I PUBLIC INFRASTRUCTURE
 TOWN OF ADDISON, TEXAS

Huilt-Zollars, Inc./Engineering/Architecture
 Dallas, Fort Worth, Houston, El Paso, Phoenix, Tustin, Ontario, San Clemente

DESIGN	DRAWN	APPR.	SCALE	DATE	PROJECT NO.	NO.
HZI	HZI	KAR	1"=20'	JAN 96	1822-04	47

137

RECORD DRAWING 5/1/98

REVIS 3
 REVISED PATTERN ALONG NORTH SIDE OF BLDG. "A", ADDED BRICK TYPE 11/15/96

REVIS 2
 REVISED PLANTING AREAS 5/13/96

ADDENDUM #2 1/22/96