


TYPICAL TREE CIRCUIT
CONDUIT INSTALLATION \triangle
N.T.S.

MATCH LINE A SEE SHEET 54A

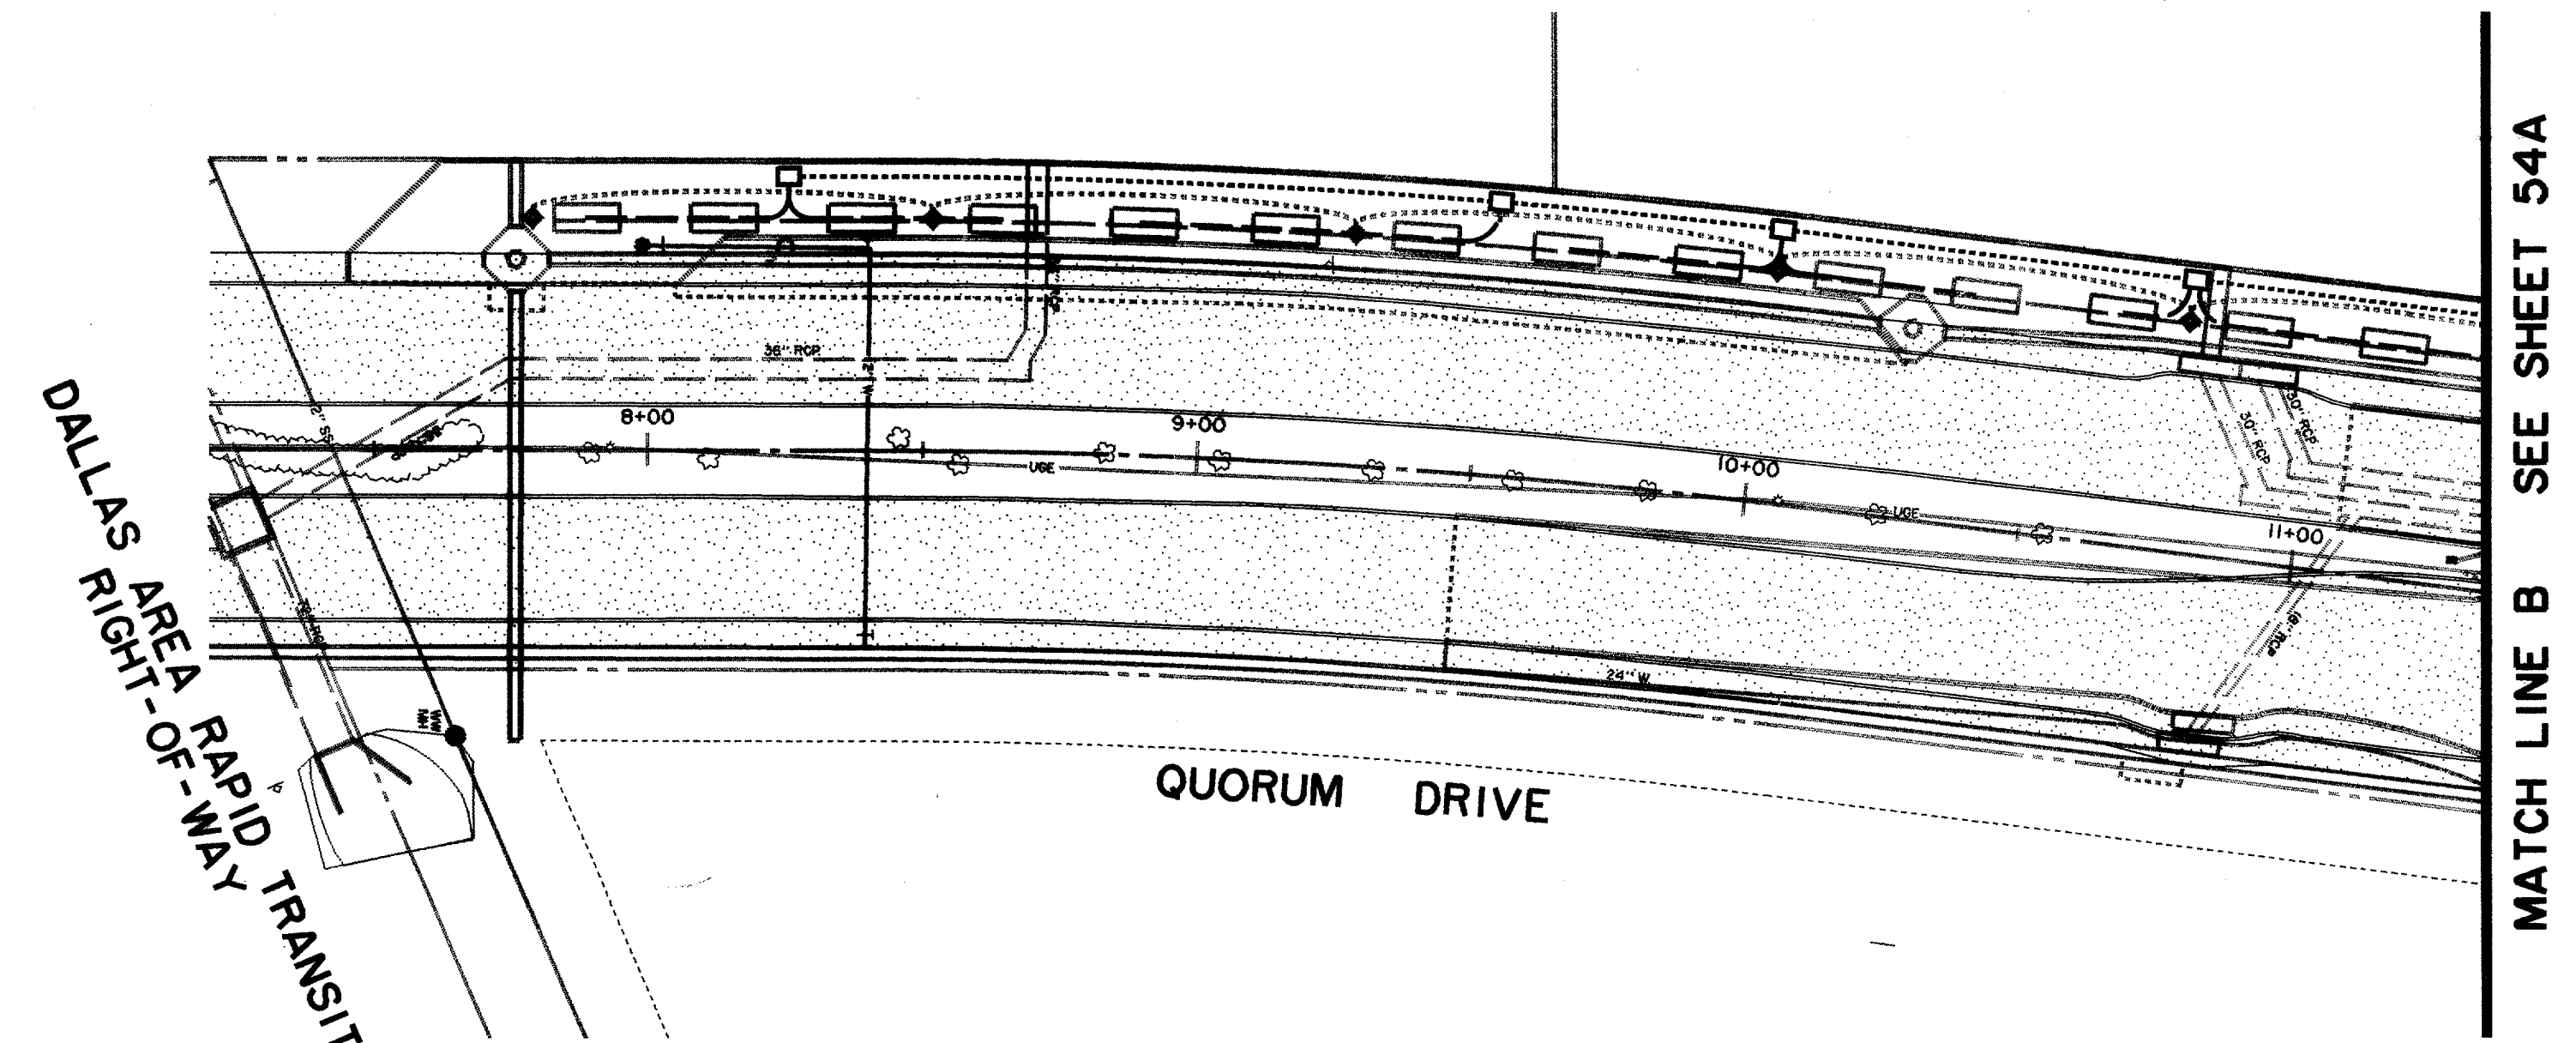

- LEGEND: \triangle \triangle
- \square PULL BOX
 - 2" SCH. 40 PVC TREE LIGHTING CONDUIT
 - 1" SCH. 40 PVC TREE LIGHTING CONDUIT
 - 3" SCH. 40 PVC TREE LIGHTING CONDUIT

ISSUED FOR CONSTRUCTION
JULY 2, 1996

THE SEAL APPEARING ON THIS DOCUMENT WAS AUTHORIZED BY
KENNETH A. ROBERTS, P.E. 55446
ON JULY 2, 1996.

7-2-96

RECORD DRAWING 5/1/98

\triangle DELETED CONDUIT ON PASCHAL PLACE AND GOODMAN AVENUE EXCEPT ONE FEED TO QUORUM TREES; REVISED LEGEND TO CHANGE $\frac{3}{4}$ " CONDUIT TO 1" CONDUIT; REVISED TYPICAL TREE CONDUIT INSTALLATION DETAIL. 5/15/97

\triangle REVISED LEGEND TO CHANGE 1" TO $\frac{3}{4}$ ", CHANGE 3" TO 2", AND ADD A NEW SYMBOLOGY FOR 3" CONDUIT. 9/25/96

TREE LIGHTING CONDUIT PLAN					
ADDISON CIRCLE					
PHASE I PUBLIC INFRASTRUCTURE					
TOWN OF ADDISON, TEXAS					
Huitt-Zollars, Inc./Engineering/Architecture Dallas, Fort Worth, Houston, El Paso, Phoenix, Tucson, Ontario, San Clemente					
DESIGN	DRAWN	APPR.	SCALE	DATE	PROJECT NO.
HZI	HZI	KAR	1"=30'	JUL 96	1822-04
					NO.
					54B
					137