

AREA OF DISTURBANCE
0.20 ACRES

AREA OF DISTURBANCE
9.41 ACRES


AREA OF DISTURBANCE
9.21 ACRES

- NOTES:**
1. SEE DRAINAGE AREA MAP FOR DRAINAGE AREAS AND CALCULATIONS.
 2. SEE POLLUTION CONTROL DETAILS FOR TYPES OF INLET PROTECTION.

- LEGEND:**
- SILT FENCE
 - INLET PROTECTION
 - EXISTING CONTOURS
 - DIRECTION OF RUNOFF
 - - - - LIMITS OF DISTURBANCE
 - ▨ STABILIZED CONSTRUCTION ENTRANCE/EXIT

ISSUED FOR CONSTRUCTION
MARCH 28, 1996

THE SEAL APPEARING ON THIS DOCUMENT WAS AUTHORIZED BY
KENNETH A. ROBERTS, P.E. 55446
ON MARCH 28, 1996.

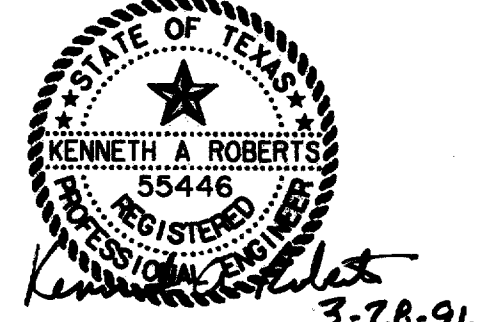

NOTE: CONCURRENT CONSTRUCTION OF APARTMENT DEVELOPMENT WITHIN AND ADJACENT TO THIS PROJECT MAY REQUIRE MODIFICATION OF EROSION CONTROL MEASURES. CONTRACTOR SHALL COORDINATE WITH DEVELOPER FOR A PRACTICAL AND USEFUL SYSTEM TO CONTROL EROSION AND SILTATION FROM BOTH PROJECTS. CONTRACTOR SHALL PROVIDE FOR WEEKLY STREET SWEEPING OF QUORUM DRIVE AND ADDISON CIRCLE

POLLUTION CONTROL PLAN							
ADDISON CIRCLE							
PHASE I PUBLIC INFRASTRUCTURE							
TOWN OF ADDISON, TEXAS							
Hull-Zollars, Inc./Engineering/Architecture Dallas, Fort Worth, Houston, El Paso, Phoenix, Tustin, Ontario, San Clemente							
DESIGN	DRAWN	APPR.	SCALE	DATE	PROJECT NO.	NO.	
HZI	HZI	KAR	1"=50'	JAN 96	1822-04	102	137

RECORD DRAWING 5/1/98

ADDENDUM #4 2/16/96