SECTIONS OF TYPICAL FORMATION

DUCT

I'-6"min. FOR PRECAST MANHOLES & POURED IN PLACE WITH PULLING EYE.

OUTSIDE DIAMETER

3.50"

4.50 "

5.56"

6. 56

PVC

PVC :

PVC


PVC

CONDUIT

5"

6"

PVC CEMENT

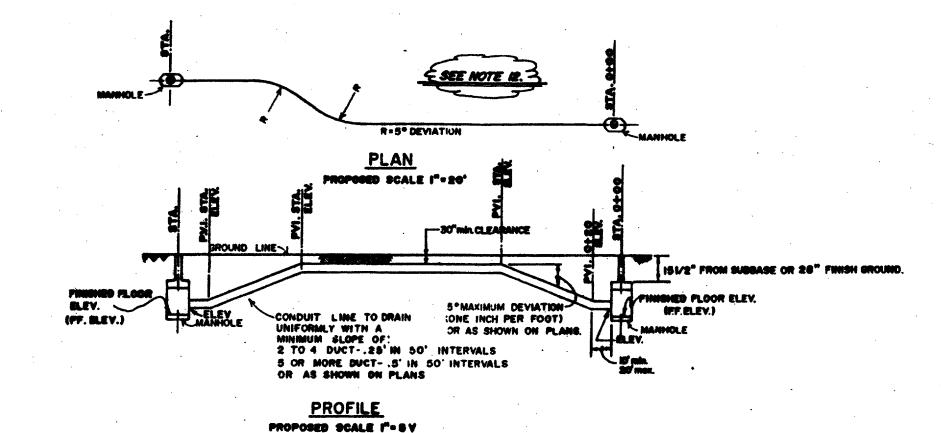

#### MOTES:

- L ALL SECTIONS OF THE CONDUIT WILL BE RUN IN A STRAIGHT LINE AS CONDITIONS WILL PERMIT. DEVIATIONS WILL BE LAND OUT BY THE POWER COMPANY
- 2. THE CONDUIT & FITTINGS WILL SE COATED LIBERALLY WITH PVC CEMENT. FUCH CONDUIT AND FITTING TOCETHER UNTIL CONDUIT BUTTS AGAINST PITTING SHOULDER.
- THIST COMMIT LA TURN TO ASSURE SMOOTH SPREADING OF CEMENT, NORMAL MIN. COVER TO BE 30".
- LIME WILL MAVE A SWAS PULLED THROUGH THE ENTIRE LEMOTH TO CHECK FOR BLOCKAGES OR OTHER UNDESTRABLE CONDITIONS, SEE TABLE NO. I FOR MANDREL AND SHEE POR CONDITIONS CONDUIT SIZE.
- 4 ALL BITCH CUTS WILL SE IN ACCORDANCE WITH EXISTING SAFETY REGULATIONS IN EFFECT.
- B. ALL CONDUIT FRUIT ON LH. & STATE HWY. R.O.W. WILL REQUIRE A MINIMUM OF 8" CONCRETE COVER FROM THE UPPERMOST DUCT, AND MIN. 36" COVER, FROM FINISH GRADE,
- T FOR HUMBER, FORMATION, AND SIZE OF CONDUITS SEE JOB PLANS.
- . 8. MIGH GARLY STRENGTH CEMENT PROHIBITED.
- 9. SHOW SITCH ELEVITION 90' INTERVALS & EACH GRADE CHANGE AND AT MANHOLE ENTRANCE.

  10. SHOW MANHOLE FUNDIN PLOOF ELEVATION.
- 11. ALL CONSULT TO SE TYPE SE D.B. UNLESS OTHERWISE NOTED ON PLANS.
- 12. STATION EVERY 100%. IN PLAN VIEW AND EVERY SOFT WITH BLEVATION IN PROPILE PLUS STATION AND ELEVATION AT EACH GRADE CHANGE.

# DETAIL # ① CONCRETE SPECIFICATION

# I. MENERAL

THESE SPECIFFEATIONS APPLY TO NAMEDLE, VAULT, AND DUCT LINE CONSTRUCTION ON THE UNBERGROUND SYSTEMS IN THE COUNTING NETWERK. THE CONCRETE SHALL BE OF ONE OF THE CLASSES SPECIFIED ON THE DRAWINGS FOR THE TYPE OF WORK UNDER CONSTRUCTION. THE RATIO OF SAND TO GRAVEL SHALL BE USED SO AS TO OSTAIR AS DEFISE AND ECONOMICAL CONCRETE AS POSSIBLE WITH THE MATERIALS AVAILABLE AND FOR THE CLASS OF WORK UNDER CONSTRUCTION, BUT IN NO CASE SHALL THE MATIO OF COMENT TO THE INERT CONTENTS DE LESS THAN THE GLASS OF CONCRETE SPECIFIED.

# E. MEGIFICATIONS FOR MATERIALS

- A. COMENT: THE COMENT SHALL COMPONN TO "STANDARD SPECIFICATIONS FOR PORTLAND COMENT" ACTH C-190 FOR TYPE !

  HORMAL PORTLAND COMENT AND TYPE !!!, HIGH-EARLY-STRENGTH PORTLAND COMENT. THE COMENT SHALL BE PROPERLY

  PROTECTED FROM THE NGATHER UNTIL USED AND SHALL BE DRY AND FREE FROM LUNDS WHEN PLACED IN THE MIXER.
- B. SAME: THE SAME SMALL COMEST OF MAND SILICEOUS MATERIAL. FREE FROM VEGETABLE MATER, CREATING, WATER, OR SUMFACE CONTING. THAT IS INJURIOUS TO CONCRETE. THE GRAINS SMALL OF GRADED IN SIZE FROM ONE-FOURTH FIRCH BOIGH, WITH HOT MORE THAN THOMPY-FIVE PER CENT OF MEIGHT WHICH SHE ALMOND SHEWE AND HOT MORE THAN FIVE PER CENT PASSING A 100 MESH PER LIMEAL HIGH SIEVE. THREE PER CENT OF MEIGHT OF GLAY OR LOAM, OR A CONSINATION OF THE TWO, WILL BE PERSITTED PROVIDED THEY ARE WELL PULVERIZED AND DISTRIBUTED THROUGHOUT THE MIX. THE FINENESS MODULUS SMALL HOT BE LESS THAN 2.5 AND NOT
- C. MANNOLE GRAVEL: THE GRAVEL SHALL CONSIST OF CLEAN, HARD, TOUGH STONES FREE FROM VEGETAGLE MATTER.

  GREATER STATES, OR SUMPACE COATING, RANGING IN SIZE FROM ONE & ONE HALF FROM DOM. NOT HOME THAN FIVE PER
  CENT OF MEMORY WHOM DOY AND ROODED, PASSING A SCREEN HAVING FOUR NESNES PER LINEAL NORM AND NO
  HITEMEDIATE SIZES SMALL BE REMOVED.
- D. COMMIT GRAVEL: THE GRAVEL SHALL CONSIST OF CLEAN, TOUGH STONES, FREE FROM VEGETABLE MATTER, GROAMIC MATTER, OR SURFACE GOATING, RANGING IN SIZE FROM GHE-HALF INCH DOWN, NOT MORE THAN FIVE PER CENT BY MEIGHT MICH DOX AND ROOSED, PAGGING A SCREEN HAVING FOUR MESHES PER LINEAL INCH AND NO INTERNEDIATE SIZES SHALL BE REMOVED.
- E. MATER: THE MATER USED FOR MIXING OR SPRINKLING CONCRETE SHALL SE CLEAR AND FREE FROM SARTH, SALT, ALEAL, SALT, OR OTHER DETERMENTAL IMPURITIES. WHEN POSSIBLE CITY WATER WILL SE USED.
- F. STEEL: NETAL REINFORCEMENT DEFORE DEING PLACED SHALL BE FREE FROM LODGE MUST SCALE, DREADE, CLAY OF STHER CONTINGS THAT WILL DESTROY OR REDUCE THE BOND. THE STEEL SHALL CONFORM TO THE LATEST EDITION OF "SPECIFICATION FOR DEFORMED BILLET-STEEL MASS FOR CONCRETE REINFORCEMENT" (\$35H A-615.)

# M. FIELD TEST FOR MATERIALS

FIELD TESTS SMALL SE MADE AS OFTEN AS IS NECESSARY TO INSURE THE MATERIALS CONFORMING TO THE FOREGOING SPECIFICATIONS. THE METHOD OF MAKING THESE TESTS SMALL DE IN ACCORDANCE WITH THE RECOMMENDATIONS OF THE AMERICAN SOCIETY FOR TESTING MATERIALS FOR CONCRETE AND CONCRETE AGREGATES.

IT CLASSES OF COMMETE AND INIT SECTION

			•	,
A.	TABLE I	A	•	·C
	STERONCO TO SEAJO	2000 pei	3000 ps i	3000 po i
	MATER CONTENT (INCLUDING	PREE SURFACE MOI STURE)		
	BY WEIGHT	.00	.58	. 56
	SALLOWS PER SACK	7.8	6.5	6.5
	MIN MADI CONTENT CONTENT			
	POUNDS PER CUBIC YARD	375	520	520
	SACRS PER CUBIC YARD	•	. 5.5	5.5
	TYPE CENEUT	1	Ī	III (HIGH EARLY)
	ALONALE SLOW	5"-4"	4°-5°	3"-4"
	MARINAM FIRE AGREEATE	eck	39%	<b>37</b> %
	MAX MAIN AGREGATE SIZE	1/2*	f 1/2"	1-1/2"

- INTES:

  1. FOR DUCT LINE INSTALLATION NOE CLASS A (2000pel) CONCRETE, OR AS SPECIFIED ON PLANS.

  2. POR NAMHOLE AND VAULT INSTALLATIONS USE CLASS B (2000pel) CONCRETE.

  3. FOR STREET BASE REPAIR NOE CLASS C (2000pel) CONCRETE.
- O. MEADY-MIX CONCRETE SHALL SE MINED AND SELEVERED IN ACCORDANCE WITH THE REQUIREMENTS SET FORTH IN THE LATEST EDITION OF "SPECIFICATIONS FOR READY-MIX CONCRETE" ASTM C-94.
- C. CONCRETE MASE BY VOLUMETRIC DATCHMIS AND CONTINUOUS MIXING SHALL CONFORM TO THE REQUIRMENTS SET FORTH IN THE LATEST EDITION OF "SPECIFICATIONS FOR CONCRETE MADE BY VOLUMETRIC BATCHING AND CONTINUOUS MIXING" ASTM C-005.
- D. ALL CONCRETE SHALL SE PLACED WITHIN ONE HOUR AFTER MIXING.

# I DESIGN AND MIXIMA OF MORTAR AND CONCRETE HAND MIXES

A. MORTAR DESIGN
MORTAR SHALL BE COMPOSED OF ONE PART TYPE I PORTLAND CENENT TO 2 3/4 PARTS GRADED STANDARD SAND
BY VOLUME. THE SAND SHOULD NOT BE EXCESSIVELY WET OR ENTIRELY. DRY WHEN MEASURED.

CONCRETE ENVELOPE(TYP.)

- B. CONCRETE MAND MYX DESIGN FOR SMALL JOBS
  THE FOLLOWING MUNICES REFER TO THE VOLUMES, RESPECTIVELY, OF CEMENT, SAND, AND AGGREGATE TO BE
  USED FOR EACH MIX.

  1. (1:2:2 1/4) FOR USE WITH MAXIMON AGGREGATE SIZE OF 1/2.
- 2. (1:2 1/4:3) FOR USE WITH MAXIMUM AGGREGATE SIZE OF 1 1/2.

  C. MIXING OF CONCRETE
  THE CEMENT AND NATURAL MIVED AGGREGATE SHALL BE MEASURED IN SWITABLE CONTAINERS. THE MIXTUPES
  SMALL BE PORPORTIQUED BY AVOLUME, EACH STEM BEING MEASURED, LOGSE AND SEPARATELY. IF MACHINE
  MIXED IN A ROTARY TYPE BATCH MIXER, THE SPEED OF THE OUTSIDE EDGE OF THE DRUM SHALL BE ABOUT
  120 FEET PER MINUTE. BUT MIX THE CEMENT AND AGGREGATES UNTIL OF UNIFORM MIXTURE. WATER
  SMALL THEN BE ADODD UNTIL A WORKABLE MIXTURE IS PRODUCED. EACH BATCH OF CONCRETE SHOULD BE
  USED INMEDIATELY AFTER MIXING.
- D. MIXING OF HORTAR
  THE CENERT AND SAND SWALL SE MIXED DRY UNTIL OF UNIFORM COLOR. WATER SHOULD THER SE ADDED AND
  THE MIXTURE TURNED UNTIL IT FORMS A UNIFORM AND WORKABLE PASTE. EACH SATCH OF MORTAR SHOULD BE
  USED IMMEDIATELY AFTER MIXING.

# II PLACING OF CONCRETE


- A. DUCT LINES: THE CONCRETE FOR CONJUST LINES SHALL BE PLACED HONOLITHICALLY INMEDIATELY AFTER MIXING.
  THE CONCRETE WILL BE SO TAMPED OR PUDDLED SO AS TO MAKE A DERSE CONCRETE ENVELOPE AROUND THE DUCTS.
  IF RECESSARY TO JOIN A NEW CONDUST LINE ONTO ONE IN WHICH THE CONCRETE HAS SET, THE OLD SURFACE SHALL BE CLEANED, ROUGHENED AND WETTED.
- B. MANHOLES AND TRANSFORMER VAULTS: THE CONCRETE FOR MANHOLES AND VAULTS SHALL BE PLACED HOMEDIATELY AFTER MIXING. THE CONCRETE SHALL BE PLACED SO AS TO KEEP THE SURFACE OF THE CONCRETE LEVEL TO PREVENT ANY FLOWING OF THE CONCRETE IN THE FORMS. THE CONCRETE SHALL BE CONTINUOUSLY SPACED TO EXPEL AIR POCKETS. THE TOP OF THE MALLS SHALL BE WELL CLEPHED, ROUGHENED AND WETTED HOMEDIATELY BEFORE POURTING THE ROOF SLAS.
- C STREET PAYENENT: SEE DETAIL #20

DETAIL #20

#### DUENCE OF CONSTRUCTION

- STEP 1 SUFFICIENT CONCRETE WILL BE REMOVED TO PERMIT TRENCH EXCAVATION.

  STEP 2 UPON COMPLETION OF THE INSTALLATION OF THE CONDUIT LINE. THE TRENCH WILL BE BARRYLLED A
- STEP 3 : THE CONCRETE PAYEMENT WILL BE SAMED TO A DEPTH OF APPROXIMATELY ONE TIMBO OF THE DEPTH OF PAYEMENT, PARALLEL TO THE LINE OF TRENCH, ONE FOOT BACK OF SOLIO GROUND. MINING STEAM-ERS CAN THEN BE USED TO BREAK THE EXCESS CONCRETE.
- STEP 4 THE EXPOSED EDGES OF THE CONCRETE WILL BE CLEANED SO A GOOD BOND CAN BE OUTAINED THE VOID IS FILLED.

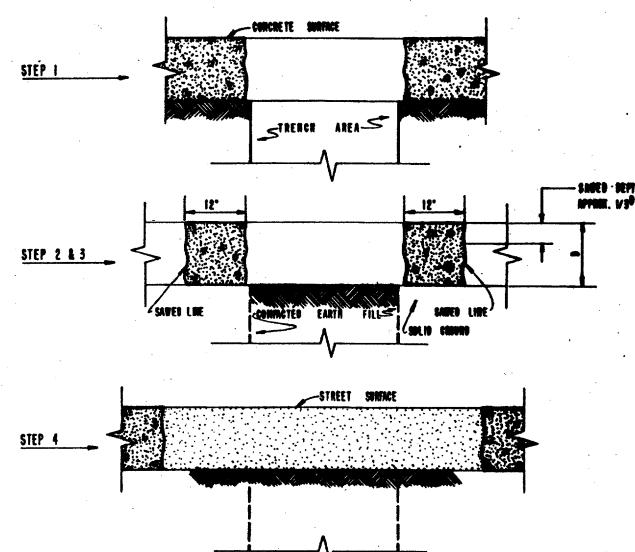

MULE, TOMMIL MOMING CHARACTE

SEQUENCE OF CONSTRUCTION ON CONCRETE STREETS WITH ASPHALT DON'THE SURFACES WILL DE THE SAME AS SEQUENCE, EXCEPT STEP 3, THE ASPHALT WILL BE OUT IN A STRAIGHT LINE USING METHODS ACCEPTABLE WITH THE CITY SPECIFICATIONS. SAWING OF THE CONCRETE WILL NOT

STREET BREAKING AND REPLACEMENT DETAILS

# TIL PROTECTION OF FRESH CONCRETE

CONCRETE SHALL SE KEPT MOIST BY SPRINKLING WITH WATER FOR A PERIOD SUITABLE TO THE CHARACTER OF THE STRUCTURE. WALKING OR WORKING OVER FIRISHED SURFACES SHALL NOT DE PERMITTED UNTIL SAME MAYE SUFFICIENTLY SET. FINISHED STREET SURFACES SHALL DE WELL BARRICADED FOR AT LEAST FORTY-FIGHT MOURS AFTER PLACEMENT., FORMS AND BRACINGS FOR MALLS OF MARHOLES AND TRANSFORMER VAULTS SHALL NOT BE DISTURBED DURING THE FIRST THIRTY SIX HOURS AFTER CONCRETE HAS BEEN PLACED. FORMS AND BRACINGS FOR ROOFS OF MARHOLES AND TRANSFORMER VAULTS SHALL NOT BE REMOVED FOR AT LEAST SEVEN DAYS AFTER CONCRETE HAS BEEN PLACED.

# TIII FINISH

UNLESS ESPECIALLY CALLED FOR. NO WORK IS TO BE DONE BY WAY OF FIRISHING CONCRETE TO SURFACES AFTER THE FORMS ARE REMOVED, EXCEPT THAT SERIOUS FAULTS IN THE CONCRETE SURFACE SHALL BE CHISELED OUT AND POCKET FORMED AND FILLED WITH CEMENT MORTAR IN SUCH A MANNER THAT THE PATCH IS SECURELY KEYED INTO THE

DATE S RGROUND SHEETS IS DETAIL NANCE メロー WOR! NET APP MIS

3

RECORD DRAWING 5/1/98

E-NUA-1 SHEET NO. 8

119/137