

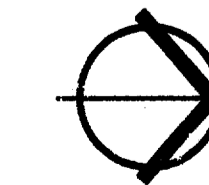


RECORD DRAWING 5/1/98

3-28-98 Issued for Construction

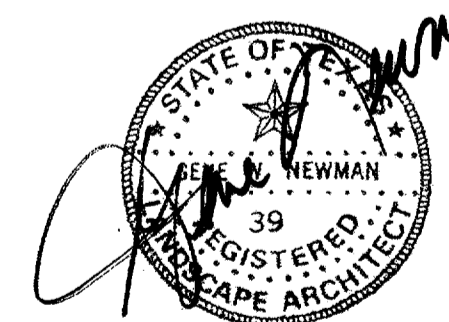

Revisions:
1-22-96 Addendum #2

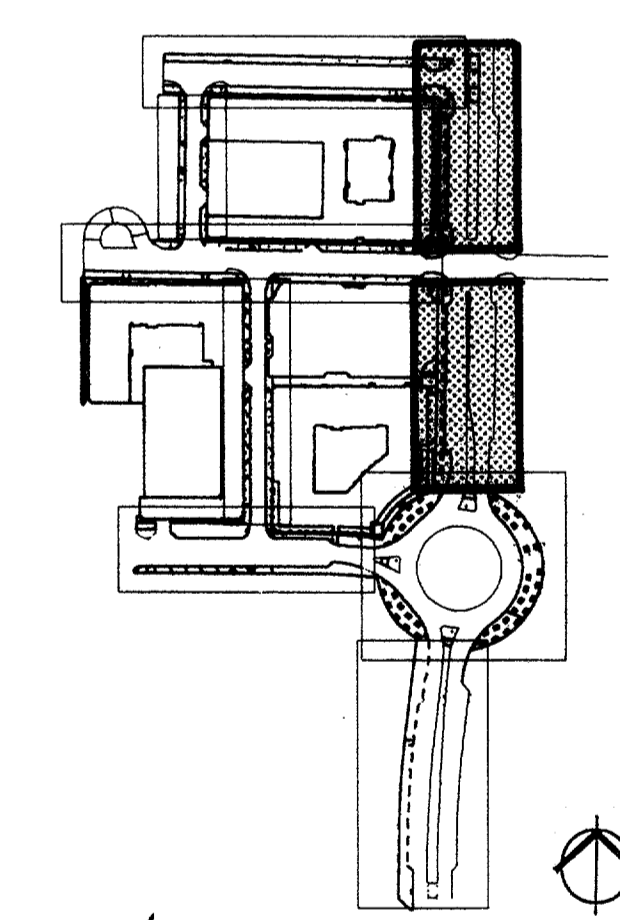

Newman, Jackson, Bieberstein, Inc.
Landscape Architecture Urban and Development Planning
12710 Colt Road, Suite 210 Dallas, Texas (214) 233-2033 Fax (214) 233-2022

Planting & Furniture Plan
ADDISON CIRCLE

PHASE 1
TOWN OF ADDISON, TEXAS

Hutt-Zollars, Inc./Engineering/Architecture
Dallas, Fort Worth, Houston, El Paso, Phoenix, Tustin, Ontario, San Clemente

DESIGN	DRAWN	APPR	SCALE	DATE	PROJECT NO.	NO.
PS	TS	GN	1" = 20'-0"	2-4-95	0030-95	124

137

Issued for Construction
March 28, 1996