

FURNITURE SCHEDULE

QTY.	ITEM	DESCRIPTION	SOURCE
11	BENCH A	CUSTOM 5' DOUBLE BOWERY BENCH STANDARD BLACK	CANTERBURY INTERNATIONAL 1-800-935-7111
16	BENCH B	5' BOWERY BENCH CDBB-805-60-F STANDARD BLACK	CANTERBURY INTERNATIONAL 1-800-935-7111
19	BENCH C	6' EXPO BENCH (3 SUPPORTS) BLACK GLOSS FINISH	ROBINSON IRON 1-205-329-8486
11	TRASH RECEPTACLE a	BOWERY TRASH RECEPTACLE WITH LID AND METAL LINER STAND. BLACK	CANTERBURY INTERNATIONAL 1-800-935-7111
7	TRASH RECEPTACLE b	ULTRUM EXPANDED METAL POLE MOUNT TRASH RECEPT. #2015 BLACK POWDER COAT FINISH	GAMETIME REPRESENTATIVE RESOURCE CONSULTING SERVICES 214-492-2428
6	TRASH RECEPTACLE c	ULTRUM CUSTOM METAL POLE MOUNT TRASH RECEPT. 20" HT. 9" DIA. BLACK POWDER COAT FINISH	GAMETIME REPRESENTATIVE RESOURCE CONSULTING SERVICES 214-492-2428
22	BIKE RACK	BIKE RIB, MODEL BR2-3 (IMBEDDED) BLACK POWDER COAT FINISH	FUNCTION FIRST BIKE SECURITY 602-322-9626
2	WATER FOUNTAIN	METRO DRINKING FOUNTAIN, DOUBLE ARM, CAST IRON, WITH STANDARD BLACK FINISH, SOLID BOWLS WITH A PATINA FINISH, FOR PERMANENT ANCHORING, SHIPPED ASSEMBLED	CANTERBURY INTERNATIONAL 1-800-935-7111

POT SCHEDULE

QTY.	ITEM	DESCRIPTION	SOURCE
10	POT A	GARDEN PLANTER STYLE 006, SANDSTONE COLOR, TEXTURED FINISH.	THE BROOKFIELD CO. 615-899-8224

PLANT SCHEDULE

SHADE TREE

QTY.	BOTANICAL NAME	COMMON NAME	SIZE AND REMARKS
100	QUERCUS SHUMARDII	RED OAK	200 GAL., 16-18" HT., 10-12" SP., 5"-6" CAL. (MATCHED SPECIMEN / CONT. GROWN) <i>cont. grown</i>
95	QUERCUS VIRGINIANA	LIVE OAK	200 GAL., 16-18" HT., 10-12" SP., 5"-6" CAL. (MATCHED SPECIMEN / CONT. GROWN) <i>specimen / cont. grown</i>
38	PRUNUS	CHANTICLEER PEAR (CLEVELAND SELECT)	4" CAL., 14-16" HT., 6' SPREAD FULL (B&B OR CONT. GROWN) <i>full</i>

SHRUBS





0	ILEX CORNUTA NELLE R. STEVENS'	NELLE R. STEVENS' HOLLY	15 GAL., 48"-54" HT., 30"-36" SP. FULL <i>Full change to green variety</i>
4612	ILEX VOMITORIA	DWF. YAUPON HOLLY	1 GAL. 8"-10" SP., FULL <i>list under shrubs plant outside of tree ball</i>
22	HESPERALOE PARVIFOLIA	RED YUCCA	1 GAL. FULL (PLANT OUTSIDE OF TREE BALL) <i>Green variety / list under shrubs</i>

PERENNIALS

14	AGAVE NEOMEXICANA	NEW MEXICO AGAVE	1 GAL. FULL
25	ASTER AUTUMN	AUTUMN ASTER	4" CONT. FULL
376	CHRYSANTHEMUM MAXIMUM	SHASTA DAISY	4" CONT. FULL
76	HEMEROCALLIS SP.	DAYLILY 'RED RUM'	4" CONT. FULL
180	HEMEROCALLIS SP.	DAYLILY 'STELLA de ORO'	4" CONT. FULL
125	HEMEROCALLIS SP.	DAYLILY MIXED (GREEN FLUTTER FRILLY MISS)	4" CONT. FULL
970	IRIS SPP.	BEARDED IRIS PURPLE	NO. 1 RHIZOMES
433	IRIS SPP.	BEARDED IRIS YELLOW	NO. 1 RHIZOMES
52	IRIS SPP.	BEARDED IRIS WHITE	NO. 1 RHIZOMES
46	IRIS SPP.	JAP. IRIS BLUE	NO. 1 RHIZOMES
254	LYCORIS RADIATA	SPIDER LILY	4" CONT. FULL
389	NARCISSUS SP.	DAFFODIL MIXED (ICE FOLLIES, TREVITHIAN, MT. HOOD, GERANIUM)	NO. 1 BULB
461	NARCISSUS SP.	DAFFODIL 'TEB. GOLD'	NO. 1 BULB
245	NARCISSUS SP.	DAFFODIL 'PEEPING TOM'	NO. 1 BULB
61	PHLOX SUBULATA	THRIFT (PINK & WHITE MIXED)	4" CONT. FULL
26	YUCCA FILAMENTOSA STARBURST	ADAMS NEEDLE 'STARBURST'	1 GAL. FULL (PLANT OUTSIDE OF TREE BALL)
56	SALMON PINK DWF. PFTZER CANNA	CANNA SALMON PINK PFTZER HYBRID	NO. 1 RHIZOMES
65	SETCREASEA PALLIDA 'PURPLE HEART'	PURPLE HEART	4" CONT. FULL

GRASS:
 LAWN TYPE A: 13,300 s.f. BERMUDA SOLID SOD TEXTURE 10
 LAWN TYPE B: 52,000 s.f. WEEPING LOVE GRASS ERAGROSTIS CURVULA

Note: Delete Tree Well Plantings of shrubs & perennials along Mildred Street as follows:
 Qty. (9) C1
 Qty. (10) C2
 Qty. (9) C3

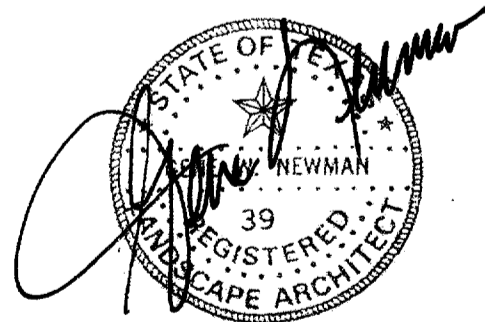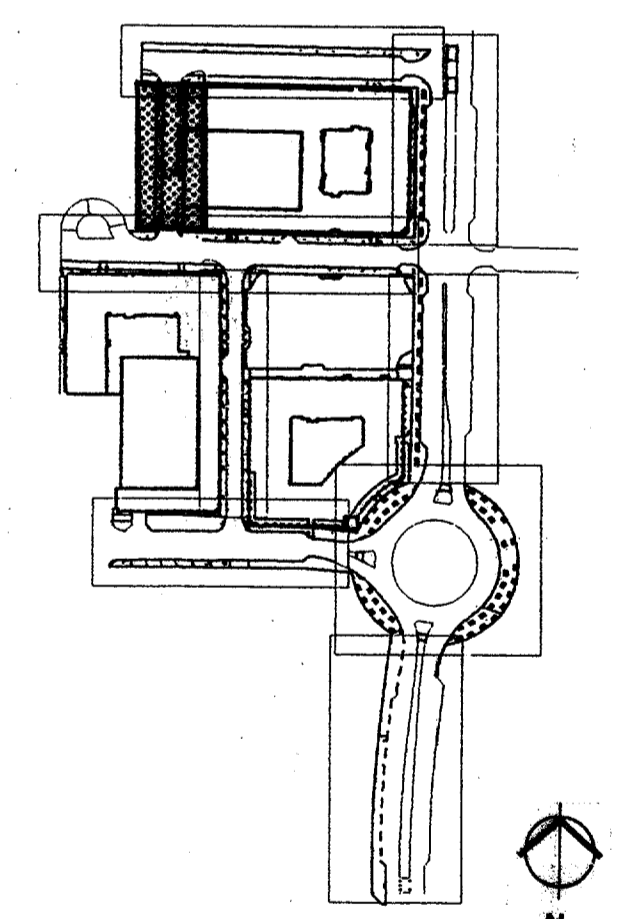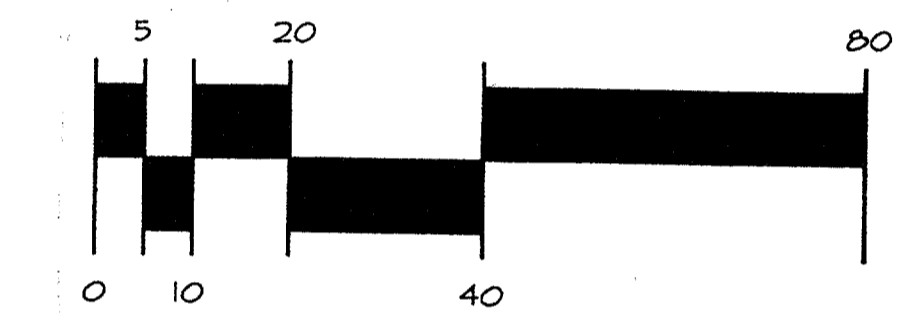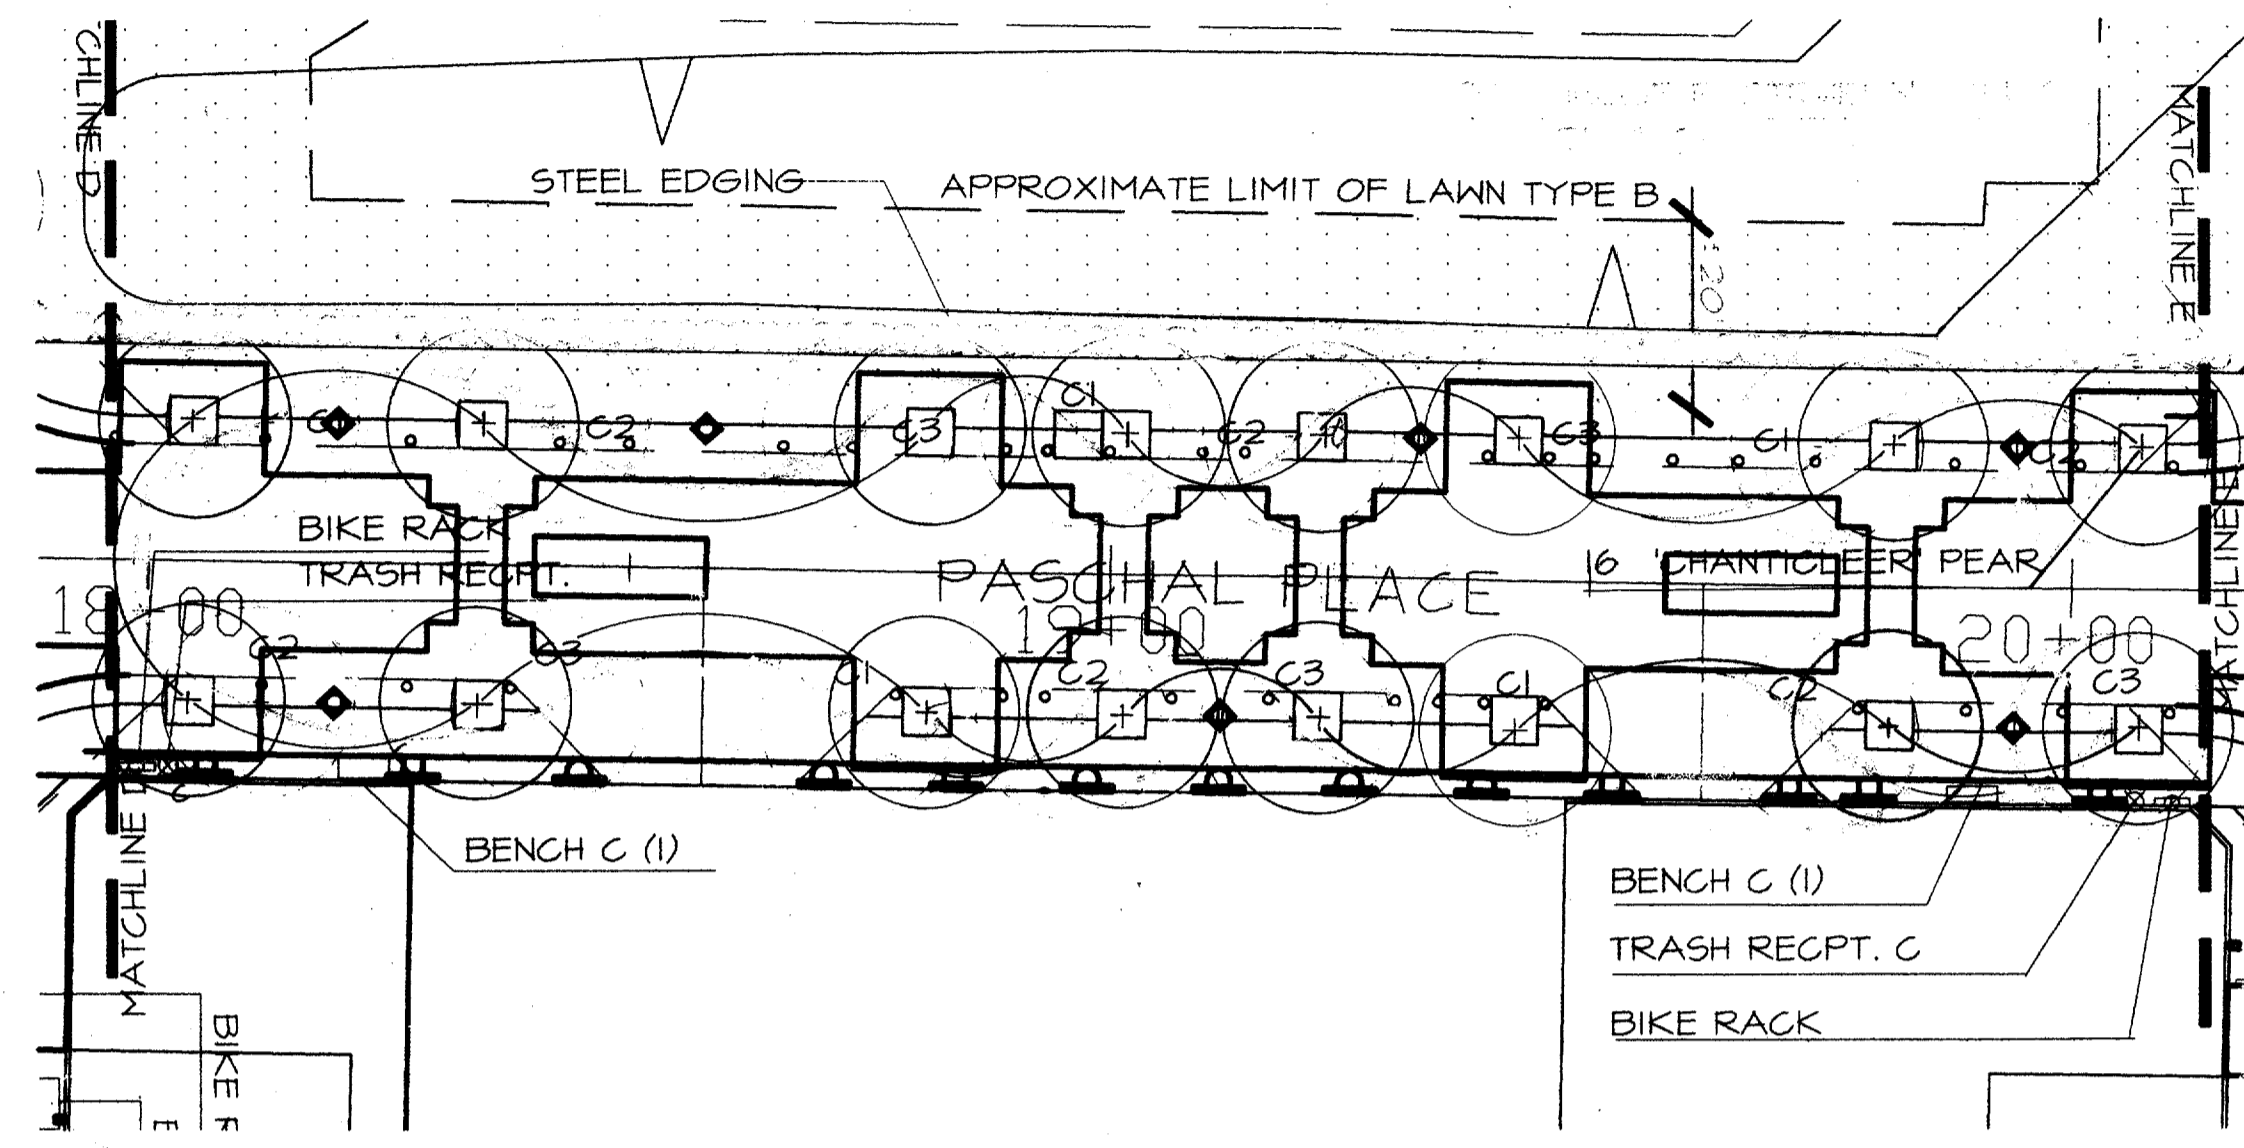

Newman, Jackson, Bieberstein, Inc.
 Landscape Architecture Urban and Development Planning
 12710 Coll Road, Suite 210 Dallas, Texas (214) 239-2039 Fax (214) 239-2022

Planting & Furniture Plan	
ADDISON CIRCLE	
PHASE 1	
TOWN OF ADDISON, TEXAS	
Huitt-Zollars, Inc./Engineering/Architecture Dallas, Fort Worth, Houston, El Paso, Phoenix, Austin, Ontario, San Clemente	
DESIGN	TS
DRAWN	GN
APPR.	TS
SCALE	1" = 20'-0"
DATE	12-4-95
PROJECT NO.	0030-95
NO.	128
137	

RECORD DRAWING 5/1/98
 3-28-96 Issued for Construction
 2-16-96 Addendum #1
 Revisions:
 1-22-96 Addendum #2
 Revisions:
 1-26-96 Addendum #3

Issued for Construction
 March 28, 1996