
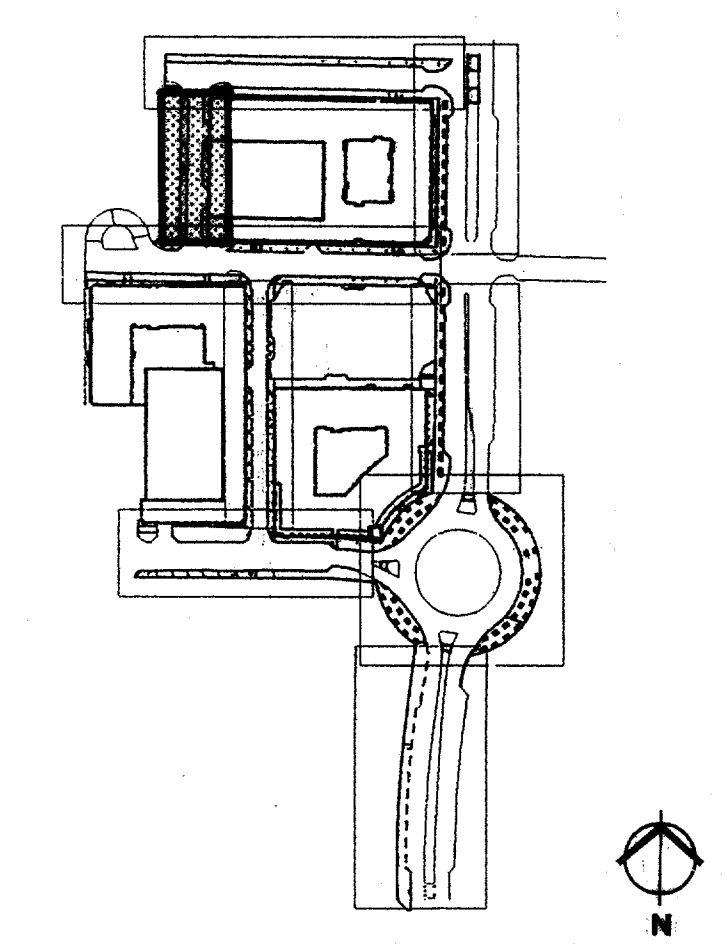


misaligned ✓

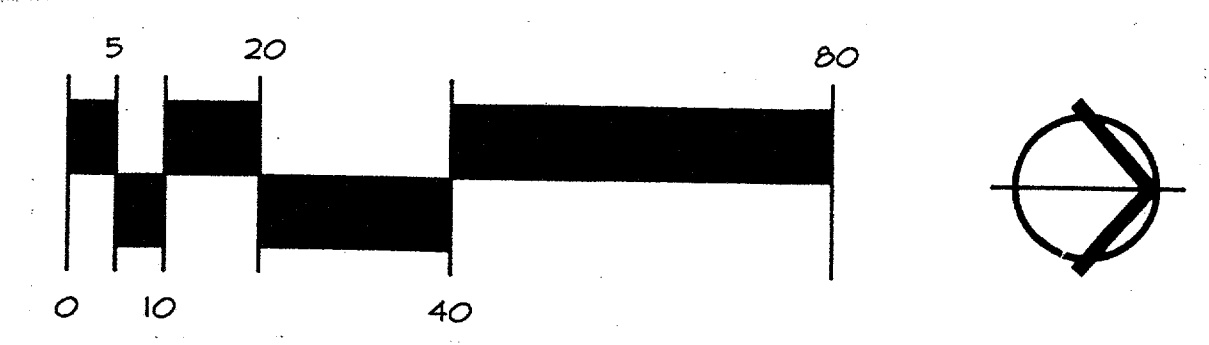

Newman, Jackson, Bieberstein, Inc.
 Landscape Architecture Urban and Development Planning
 12710 Coit Road, Suite 210 Dallas, Texas (214) 299-2099 Fax (214) 299-2022

Irrigation Plan						
ADDISON CIRCLE						
PHASE 1						
TOWN OF ADDISON, TEXAS						
<small>Hutt-Zollars, Inc./Engineering/Architecture Dallas, Fort Worth, Houston, El Paso, Phoenix, Tustin, Ontario, San Clemente</small>						
DESIGN	DRAWN	APPR.	SCALE	DATE	PROJECT NO.	NO.
		GN	1" = 20'-0"	12-4-95	0030-05	136
						137

RECORD DRAWING 5/1/98

- ▲ 2-16-94 Addendum #4
- Revisions:
- ▲ 1-22-96 Addendum #2

Issued for Construction
 March 28, 1996