




LINE "A"

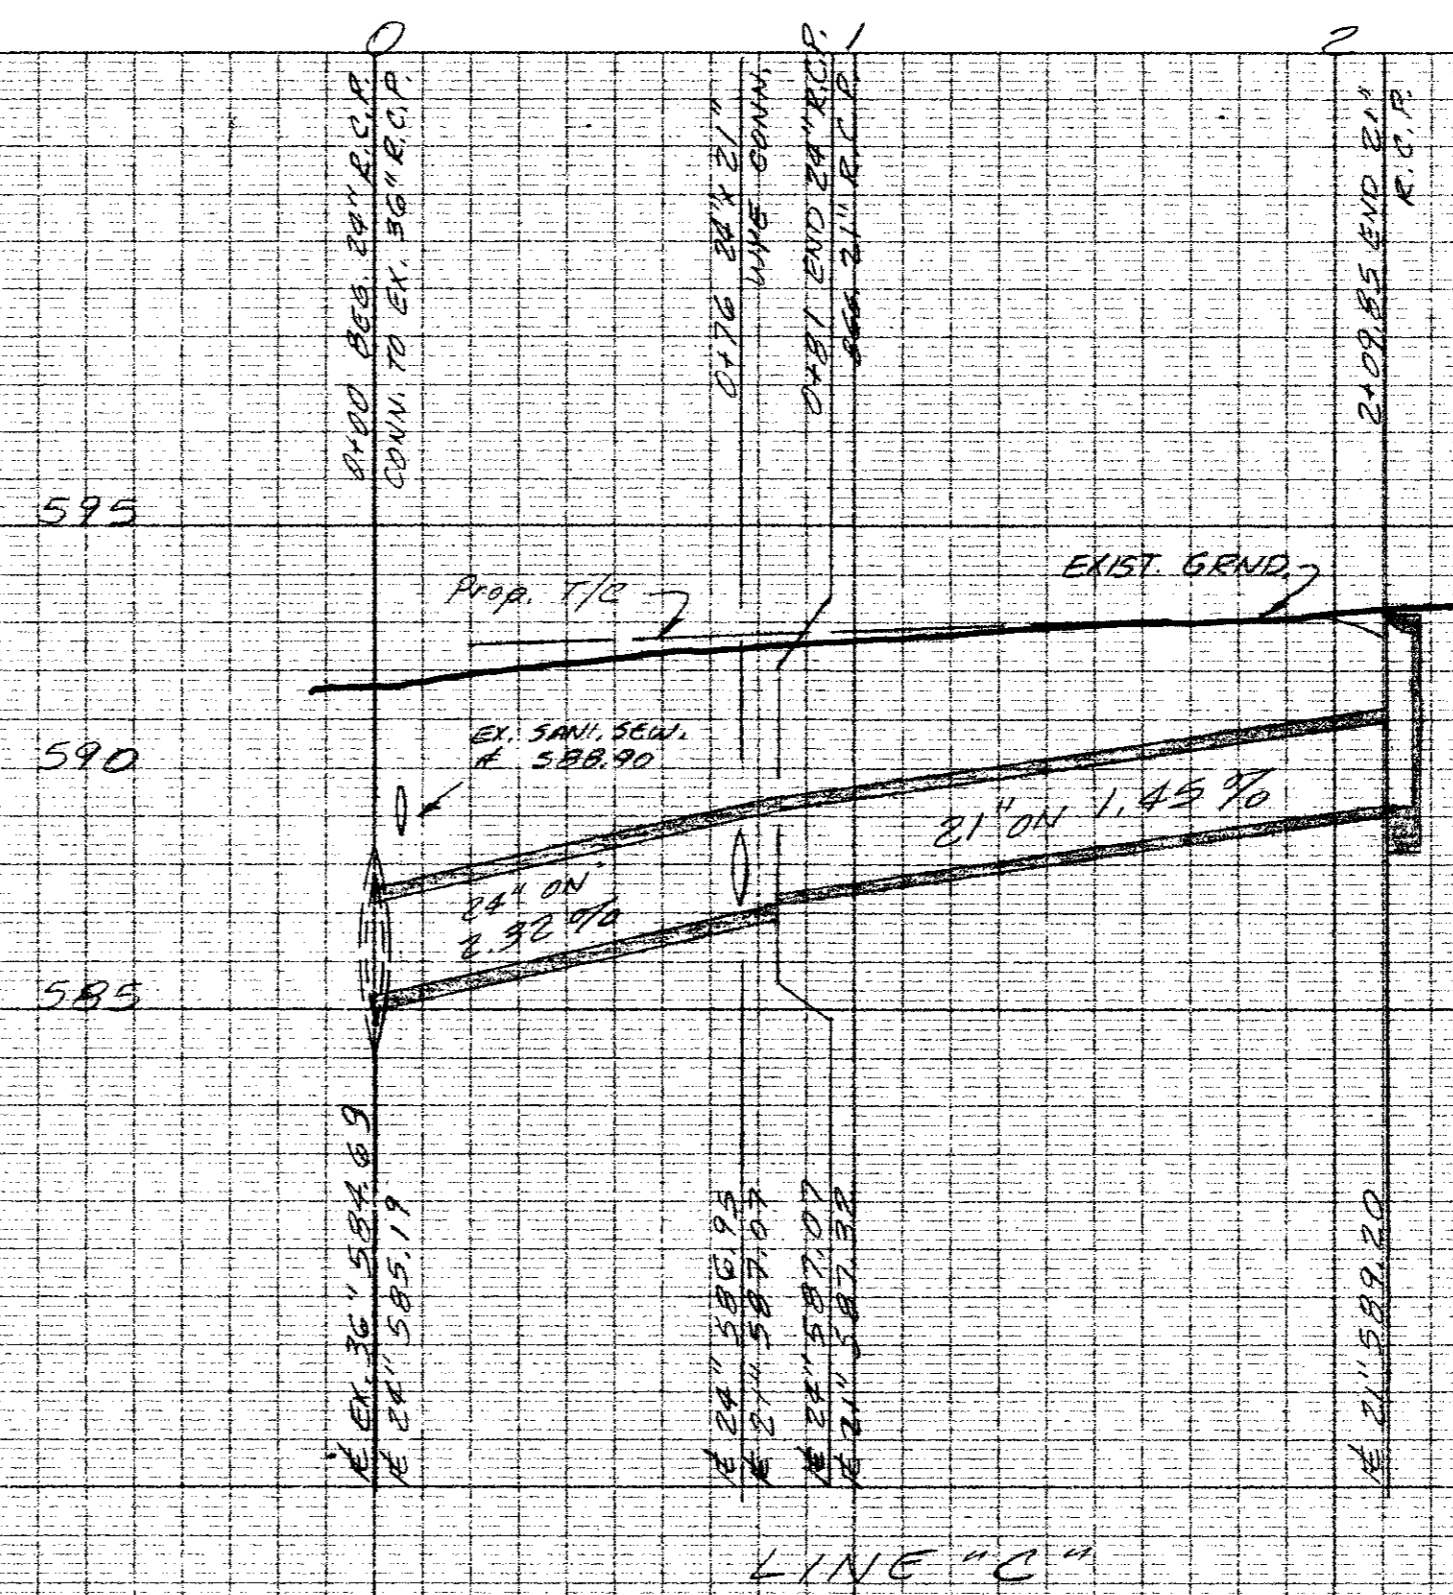


LINE "C"

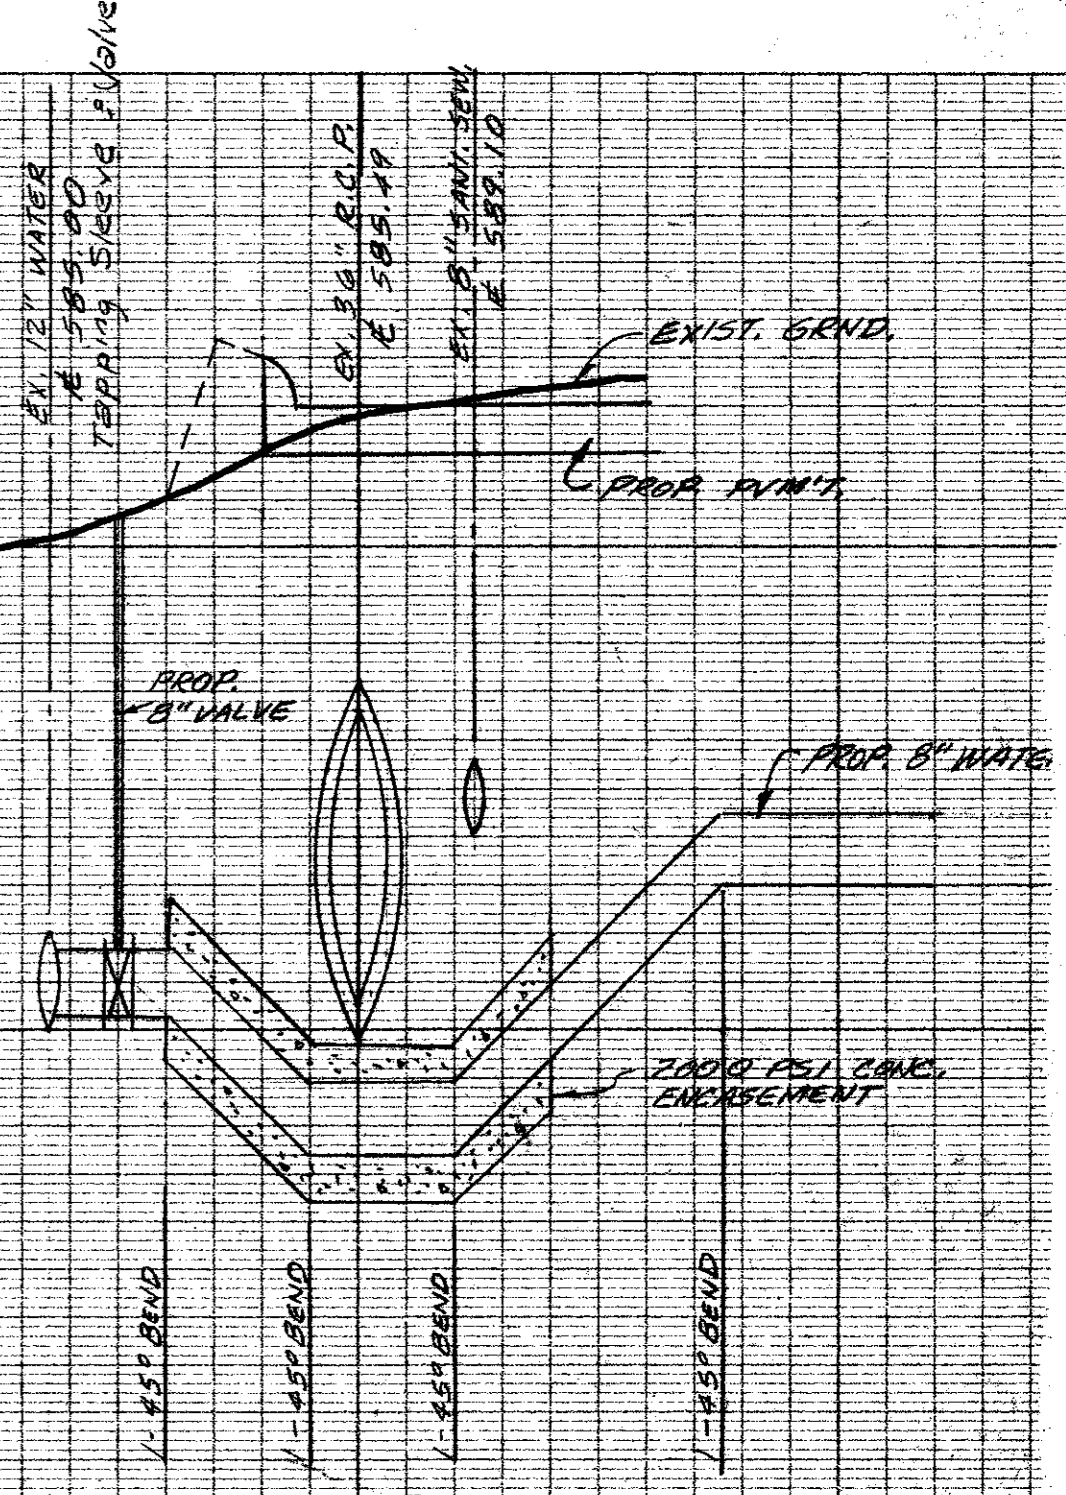

WATER LINE CROSSING DETAIL
SCALE: 1" = 10' H.
1" = 2' V.

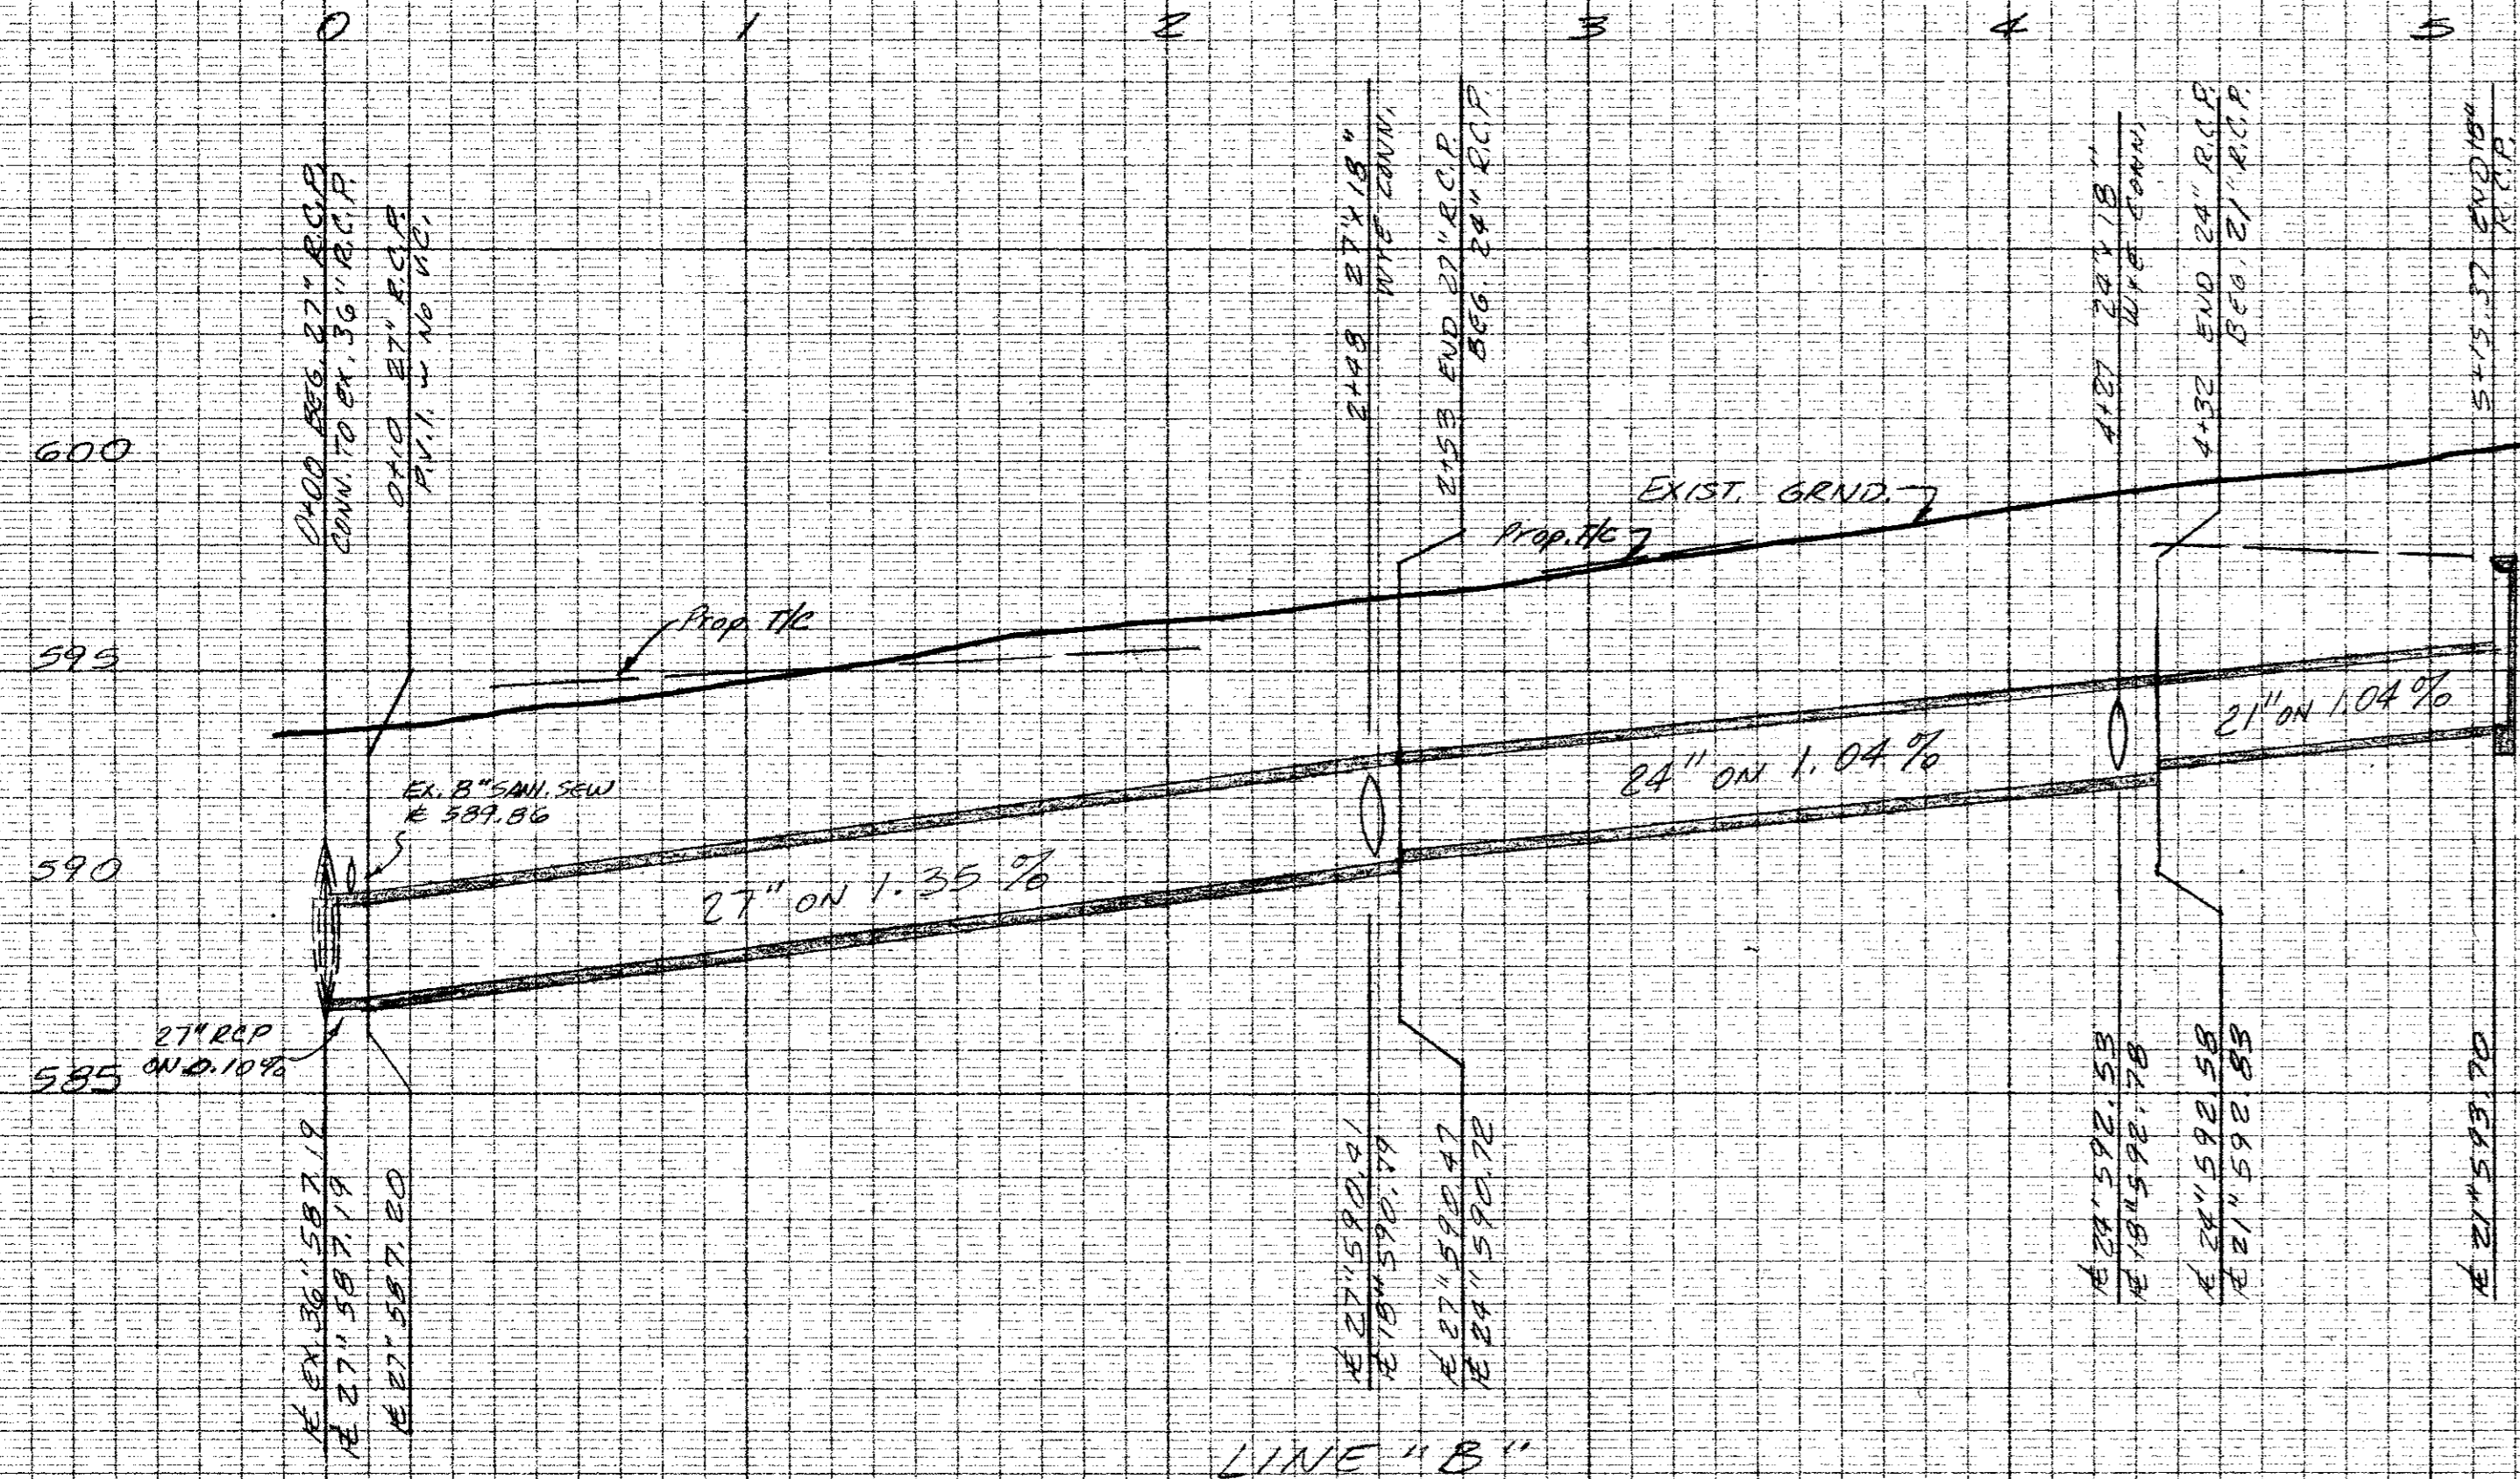

LINE "B"

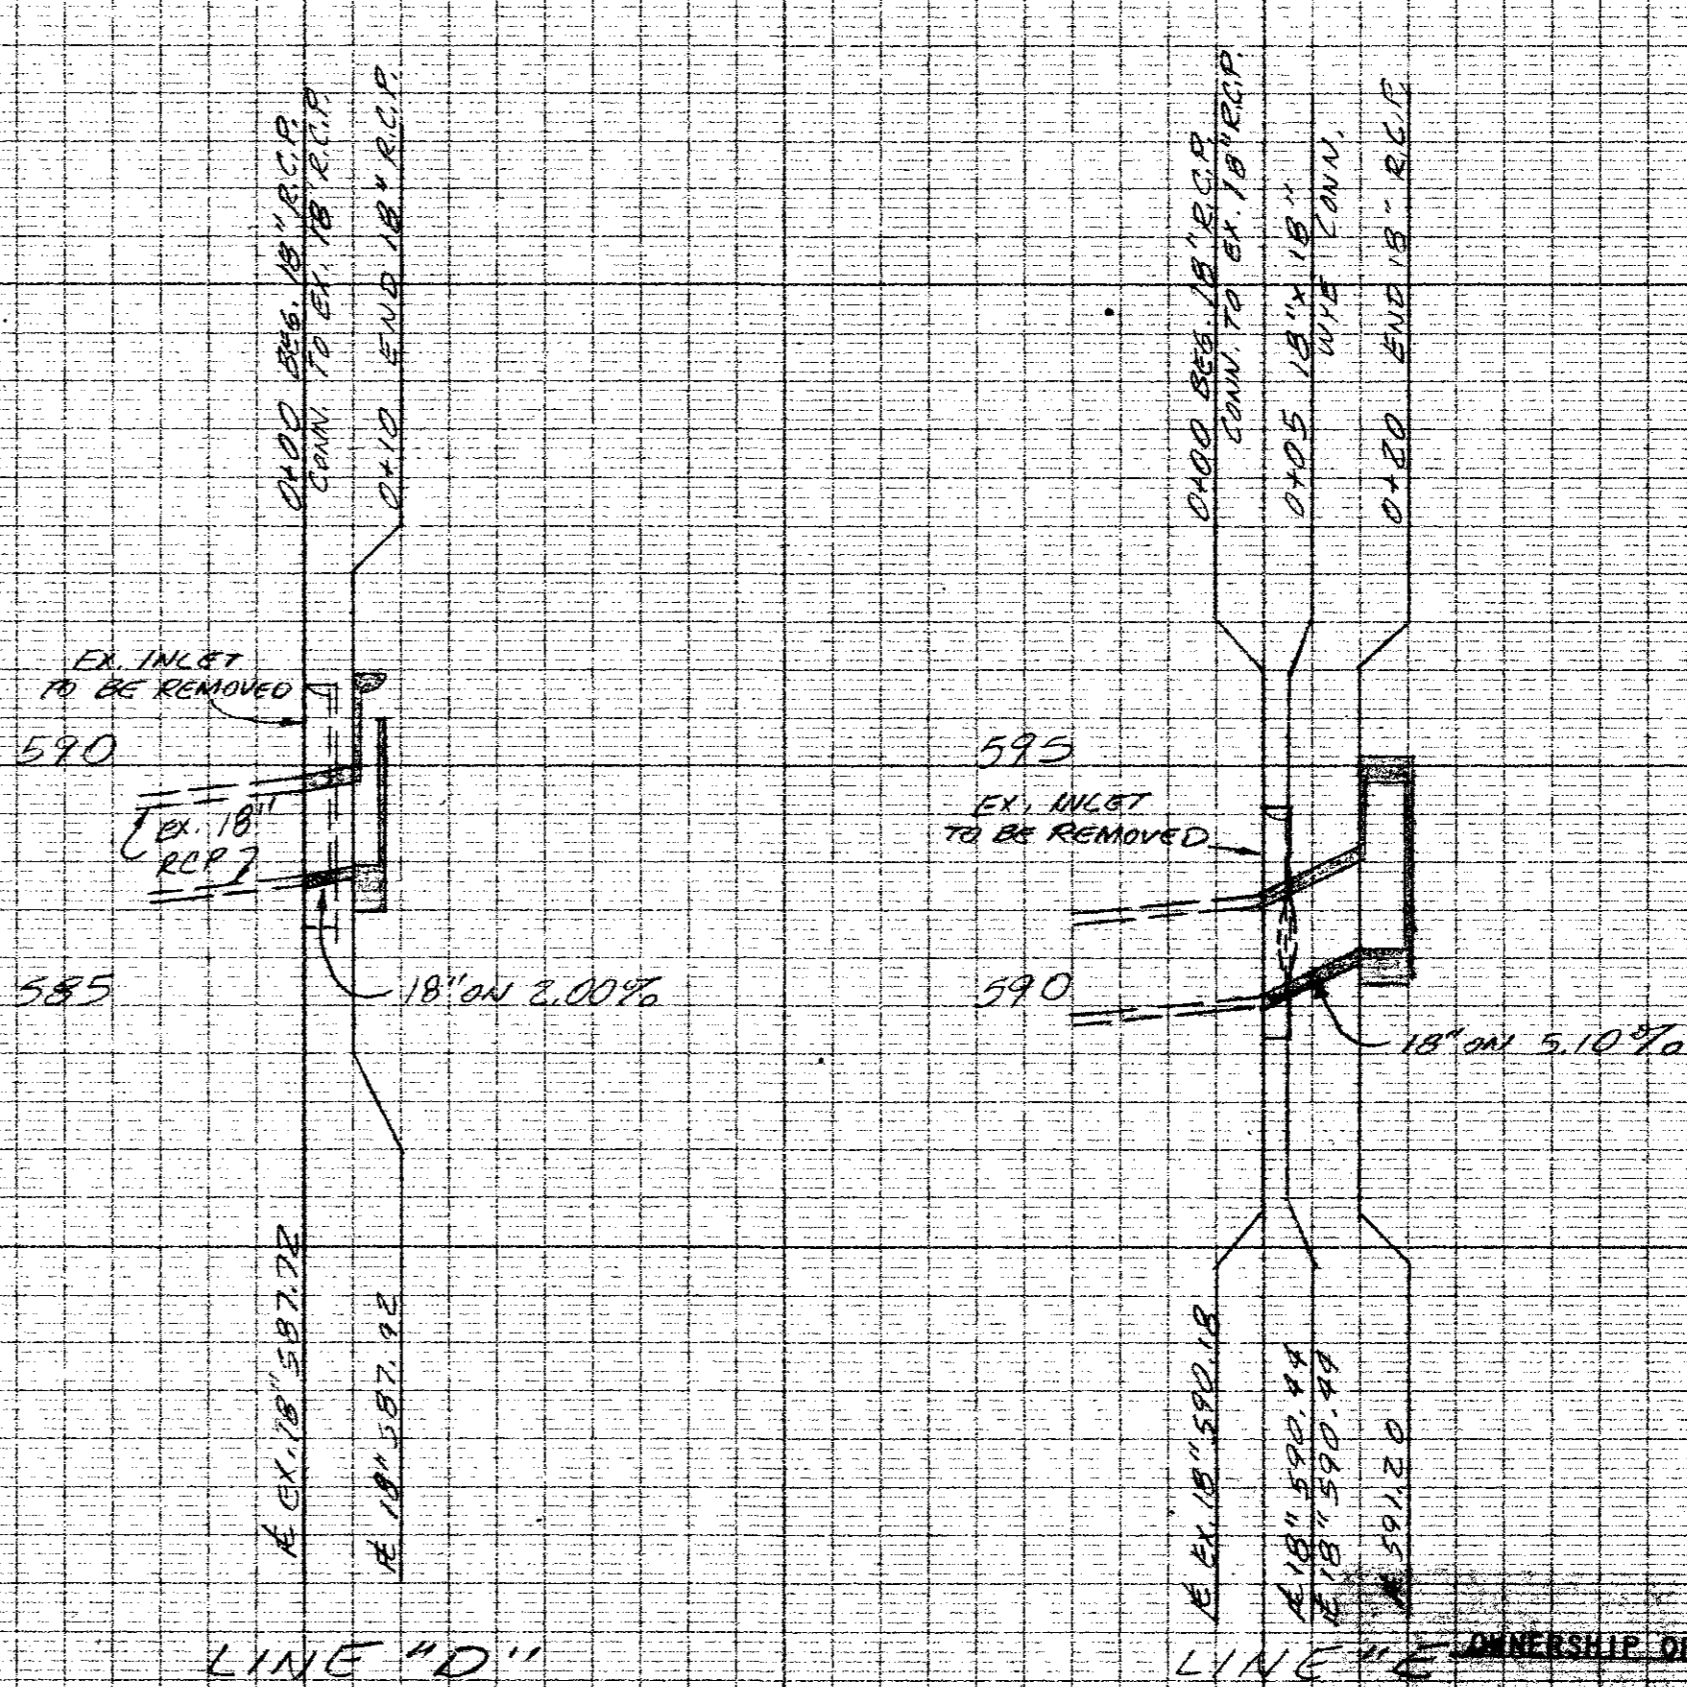

LINE "D"

LINE "E"

AS BUILT PLANS

NOTE: THE INTENT OF THE OWNER AND ENGINEER WAS TO CONSTRUCT THE UTILITIES ACCORDING TO THESE PLANS AS APPROVED BY THE CITY OF ADDISON. THE LINES AND GRADES WERE SET ON THE GROUND FOR CONSTRUCTION ACCORDING TO SAID PLANS. THE CITY OF ADDISON INSPECTED THE CONSTRUCTION. THE OWNER OR ENGINEER DID NOT VERIFY LINES OR GRADES AFTER CONSTRUCTION. WE ARE NOT AWARE OF ANY CHANGES OR REVISIONS TO THESE PLANS DURING CONSTRUCTION EXCEPT SOME MARKING IN THE FIELD. CHANGED.

NOV. 14, 1995



STORM SEWER PROFILES					
HUIE ADDISON ADDITION					
THOMAS L. CHENNOWETH SUR., ABST. 273					
ADDISON, TEXAS					
THREADGILL-DOWDEY and ASSOCIATES					
CONSULTING ENGINEERS DALLAS, TEXAS					
DESIGN	DRAWN	CHECKED	DATE	SCALE	JOB SHEET
AR.W.	R.E.	D.M.D.	6-84	1/4" = 1'-0"	9208 2/2

BENCH MARK: "1" CUT S.E. CORNER INLET @ N.E. CORNER OF PROTON ROAD & MIDWAY RD. ELEV. 598.77

ALL STORM SEWER PIPE TO BE REINFORCED CONCRETE, CLASS III.