


MIDWAY (100' ROW) ROAD

PROTON (60' ROW) DRIVE

AS BUILT DRAWINGS BASED ON INFORMATION PROVIDED BY THE CONTRACTOR

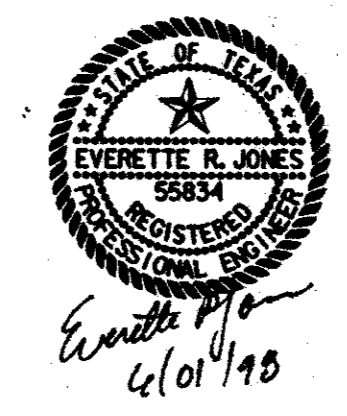

BENCH MARKS:
 □ CUT AT WEST CORNER OF CONCRETE HEADWALL OF BOX CULVERT, SOUTH SIDE OF PROTON DRIVE AND +350' EAST OF MIDWAY ROAD AND PROTON DRIVE INTERSECTION. ELEV.=598.37
 SET *□* CUT SET ON CURB INLET NORTH SIDE OF PROTON DR. ± 50' WEST OF WEST R.O.W. OF MIDWAY RD. ELEV.=598.92

UTILITY DIMENSION CONTROL PLAN						
ENGLISHMAN'S ANTIQUES						
PRITCHARD ASSOCIATES						
ADDISON, TEXAS						
Half Associates <small>ENGINEERS • ARCHITECTS • SCIENTISTS • PLANNERS • SURVEYORS</small>						
DESIGN	DRAWN	DATE	SCALE	NOTES	FILE	NO.
R.M.	CADD	JULY 1998	1" = 20'	7490001 16749		DC-1