


NO.	DATE	REVISION
1	12-6-93	CITY COMMENTS
2	2-2-94	REVISED PONDS & STORM SEWER

Winkelmann & Associates, Inc.
 CONSULTING CIVIL ENGINEERS
 14802 PRESTON ROAD, SUITE 200
 DALLAS, TEXAS 75244
 (214) 490-1998

THOMAS L. CHENOWETH SURVEY,
 ABSTRACT NO. 273
 CITY OF ADDISON, DALLAS COUNTY, TEXAS
 CLIENT:
 MCUTCHIN PROPERTIES
 14802 PRESTON ROAD, SUITE 200
 DALLAS, TEXAS 75244

STORM SEWER PROFILE

Winkelmann & Associates, Inc. hereby certifies that this plan to the best of our knowledge is as built. All modifications from the originally approved construction documents have been made as per information provided by the contractor. Winkelmann & Associates, Inc. does not certify as to the accuracy or quality of construction by the field inspection was performed.
Thomas L. Chenoweth
 WINKELMANN & ASSOCIATES, INC.
 10-19-94
 DATE

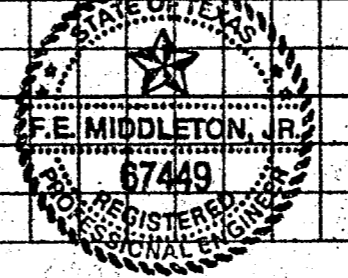

BENCHMARK NO. 1:
 "I" CUT IN CURB LOCATED ON NORTHEAST CORNER OF AN INLET ON THE WEST SIDE OF MIDWAY ROAD APPROXIMATELY 911 FEET SOUTH OF BELTWAY DRIVE.
 ELEV. = 615.72

BENCHMARK NO. 2:
 "I" CUT IN CURB LOCATED ON SOUTH SIDE OF BELTWAY ROAD APPROXIMATELY 627 FEET EAST OF MIDWAY ROAD.
 ELEV. = 631.63

Scale: 1" = 1'-0"
 Date: 10-28-93
 Designed By: F.E.M.
 Drawn By: L.E.H.
 Checked By: F.E.M.
 File: 156PROF.DWG
 Project No.: 15602.01