


SITework PLANS FOR



S.W.C. OF BELT LINE ROAD & MIDWAY ROAD THE TOWN OF ADDISON, TEXAS

OWNER:
PIEDMONT MIDWAY PARTNERS, LP
 3400 CARLISLE, SUITE 445
 DALLAS, TEXAS 75204
 CONTACT: BILL PARK
 (214) 979-1125
 FAX: (214) 979-1128

CIVIL ENGINEER:
LAWRENCE A. CATES & ASSOC., LLP
 14800 QUORUM DRIVE, SUITE 200
 DALLAS, TEXAS 75254
 CONTACT: BRYAN M. BURGER, P.E.
 (972) 385-2272
 FAX: (972) 980-1627

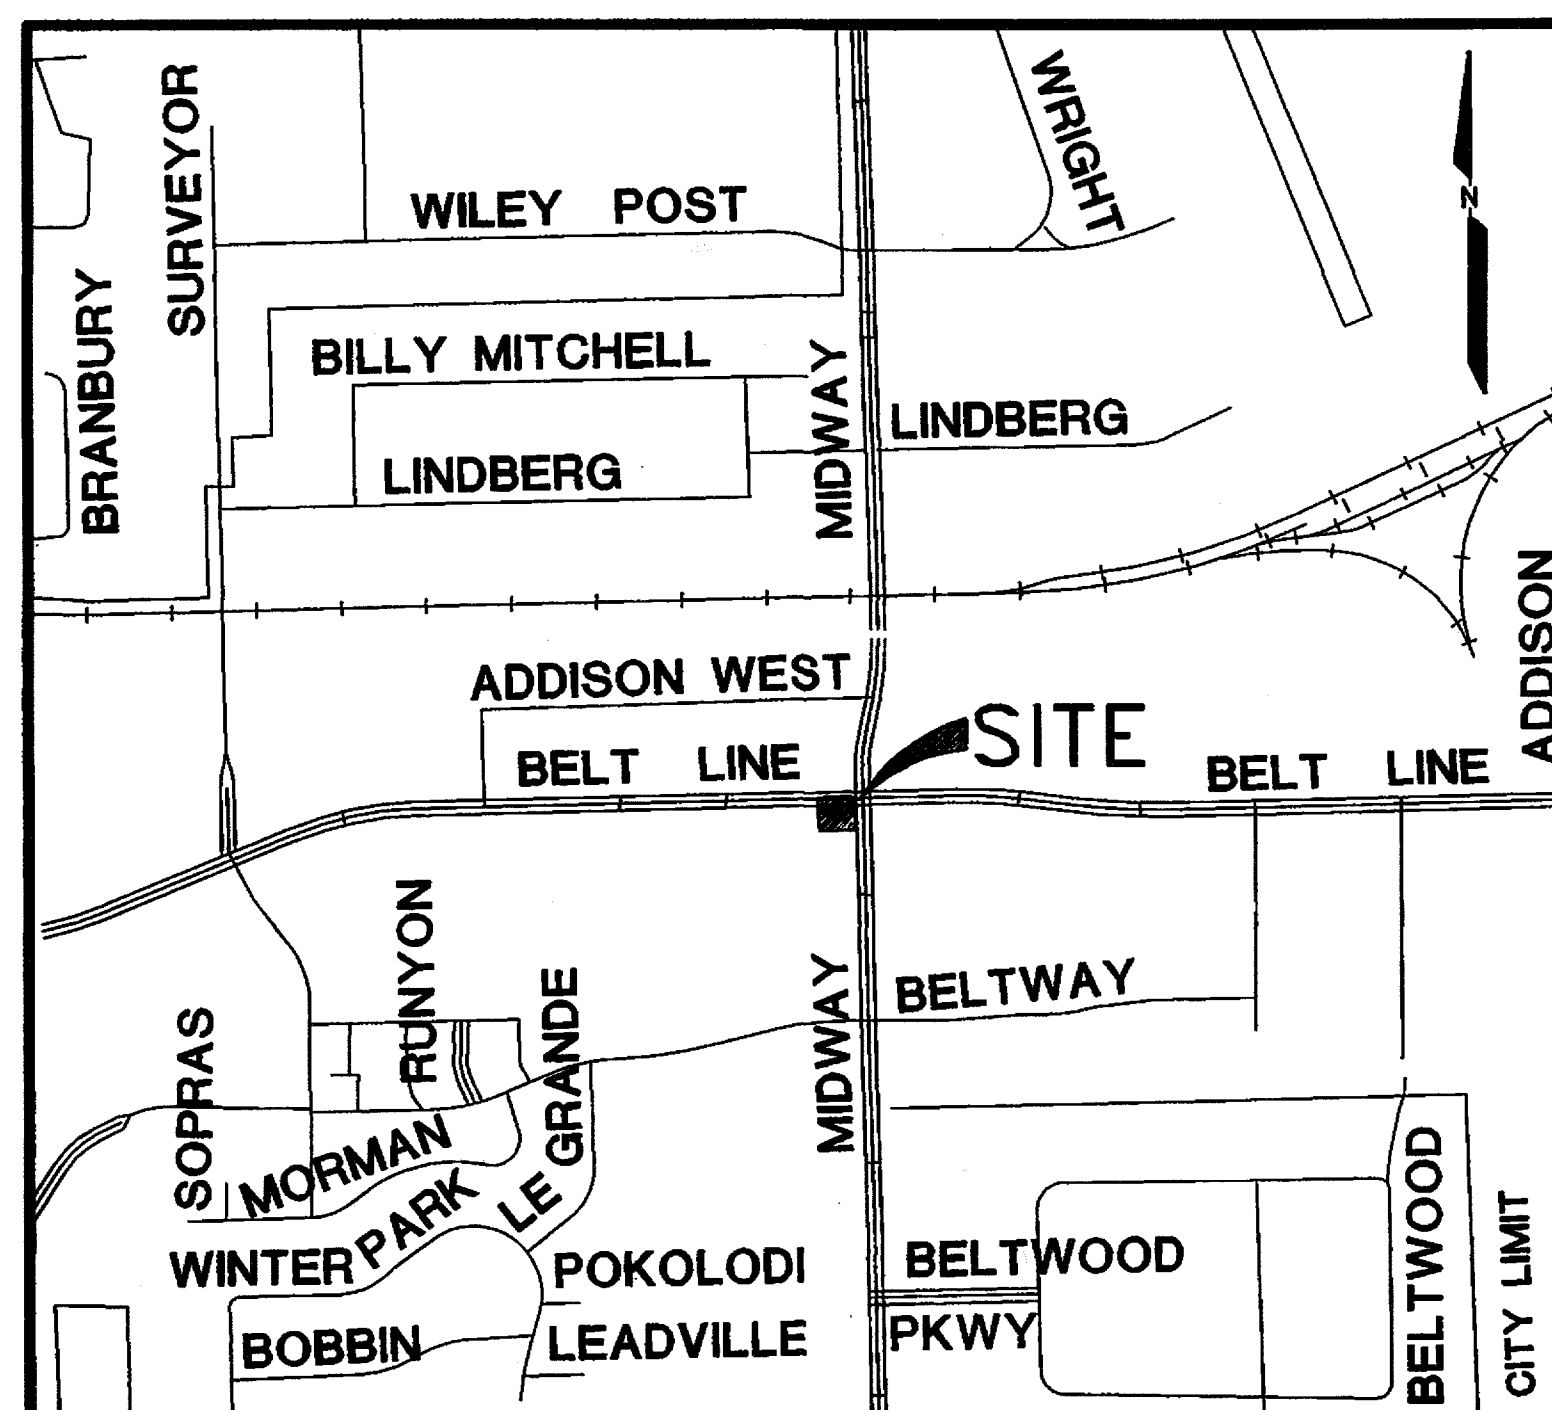

VICINITY MAP

N.T.S.

SHEET INDEX

C-1	SURVEY
C-2	PLAT
C-3	DEMOLITION PLAN
C-4	SITE PLAN
C-5	PAVING PLAN
C-6	GRADING PLAN
C-7	DRAINAGE AREA MAP
C-8	WATER & SANITARY SEWER PLAN
C-9	EROSION CONTROL PLAN
SD-1	SANITARY SEWER DETAILS
SD-2	TRAFFIC CONTROL PLAN
L.1	LANDSCAPE PLAN
L.2	LANDSCAPE SPECIFICATIONS AND DETAILS
L.3	IRRIGATION PLAN
L.4	IRRIGATION SPECIFICATIONS AND DETAILS
MEP-1	SITE PLAN-MEP
MEP-2	MEP REQUIREMENTS
MEP-3	SITE PLAN-PHOTOMETRICS

AS BUILT
 DATE 3.17.06

FF-6
 15099 MIDWAY
 23113 STARBUCKS, S.W.C. BELTLINE RD. & MIDWAY RD. ADDISON, TEXAS