

NOTES

1. Calc at grade level
2. Mounting Height based on a 20' pole on a 30' pier


STATISTICS

Description	Symbol	Avg	Max	Min	Max/Min	Avg/Min
Calc Zone #1	+	2.3 fc	13.4 fc	0.0 fc	N/A	N/A

LUMINAIRE SCHEDULE

Symbol	Label	Qty	Catalog Number	Description	Lamp	File	Lumens	LLF	Watts
☐	SA	6	CM-A-H400-H3-F-Q-PS-F2-HS	MEDALLION I RECTANGULAR AREA LIGHT TYPE III REFLECTOR CLEAR FLAT GLASS LENS INTERNAL HOUSE SHIELD	400W CLEAR ED28 METAL HALIDE HORIZONTAL POSITION	L4990CM.ies	36000	0.72	400
☐	SB	2	CM-A-H400-H3-F-Q-PS-F2	MEDALLION RECTANGULAR AREA LIGHT TYPE V REFLECTOR CLEAR FLAT GLASS LENS	400W CLEAR ED28 METAL HALIDE	L5090CM.ies	36000	0.72	800

AS BUILT
DATE 3.17.06

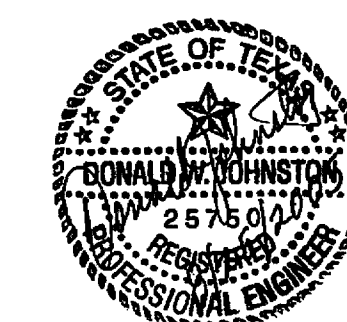

ROBNETT & ASSOCIATES
2714 W. KINGSLEY ROAD
SUITE 211
GARLAND, TEXAS 75041
(972) 840-8989

SITE PLAN - PHOTOMETRICS						
STARBUCKS - ADDISON PLAZA ADDITION						
S.W.C. BELT LINE RD. & MIDWAY RD.						
THE TOWN OF ADDISON, TEXAS						
LAWRENCE A. CATES & ASSOCIATES, L.L.P. CONSULTING ENGINEERS DALLAS, TEXAS (972) 385-2272						
DESIGN	DRAWN	DATE	SCALE	NOTES	FILE	NO.
RAR	RAR	08/24/05	1"=20'	-	23113 R&A#36-04	MEP-3