

# IMPROVEMENT PLANS FOR ADDISON GROVE TOWN OF ADDISON, TEXAS PUBLIC WORKS #16-02



TODD MEIER  
MAYOR

BRUCE ARFSTEN  
MAYOR PRO TEMPORE


AL ANGELL  
JIM DUFFY  
PAUL WALDEN  
DALE WILCOX

COUNCIL MEMBERS

WES PIERSON  
CITY MANAGER

LISA PYLES  
DIRECTOR OF INFRASTRUCTURE  
AND DEVELOPMENT SERVICES

JASON SHROYER  
ASSISTANT DIRECTOR - INFRASTRUCTURE  
AND DEVELOPMENT SERVICES

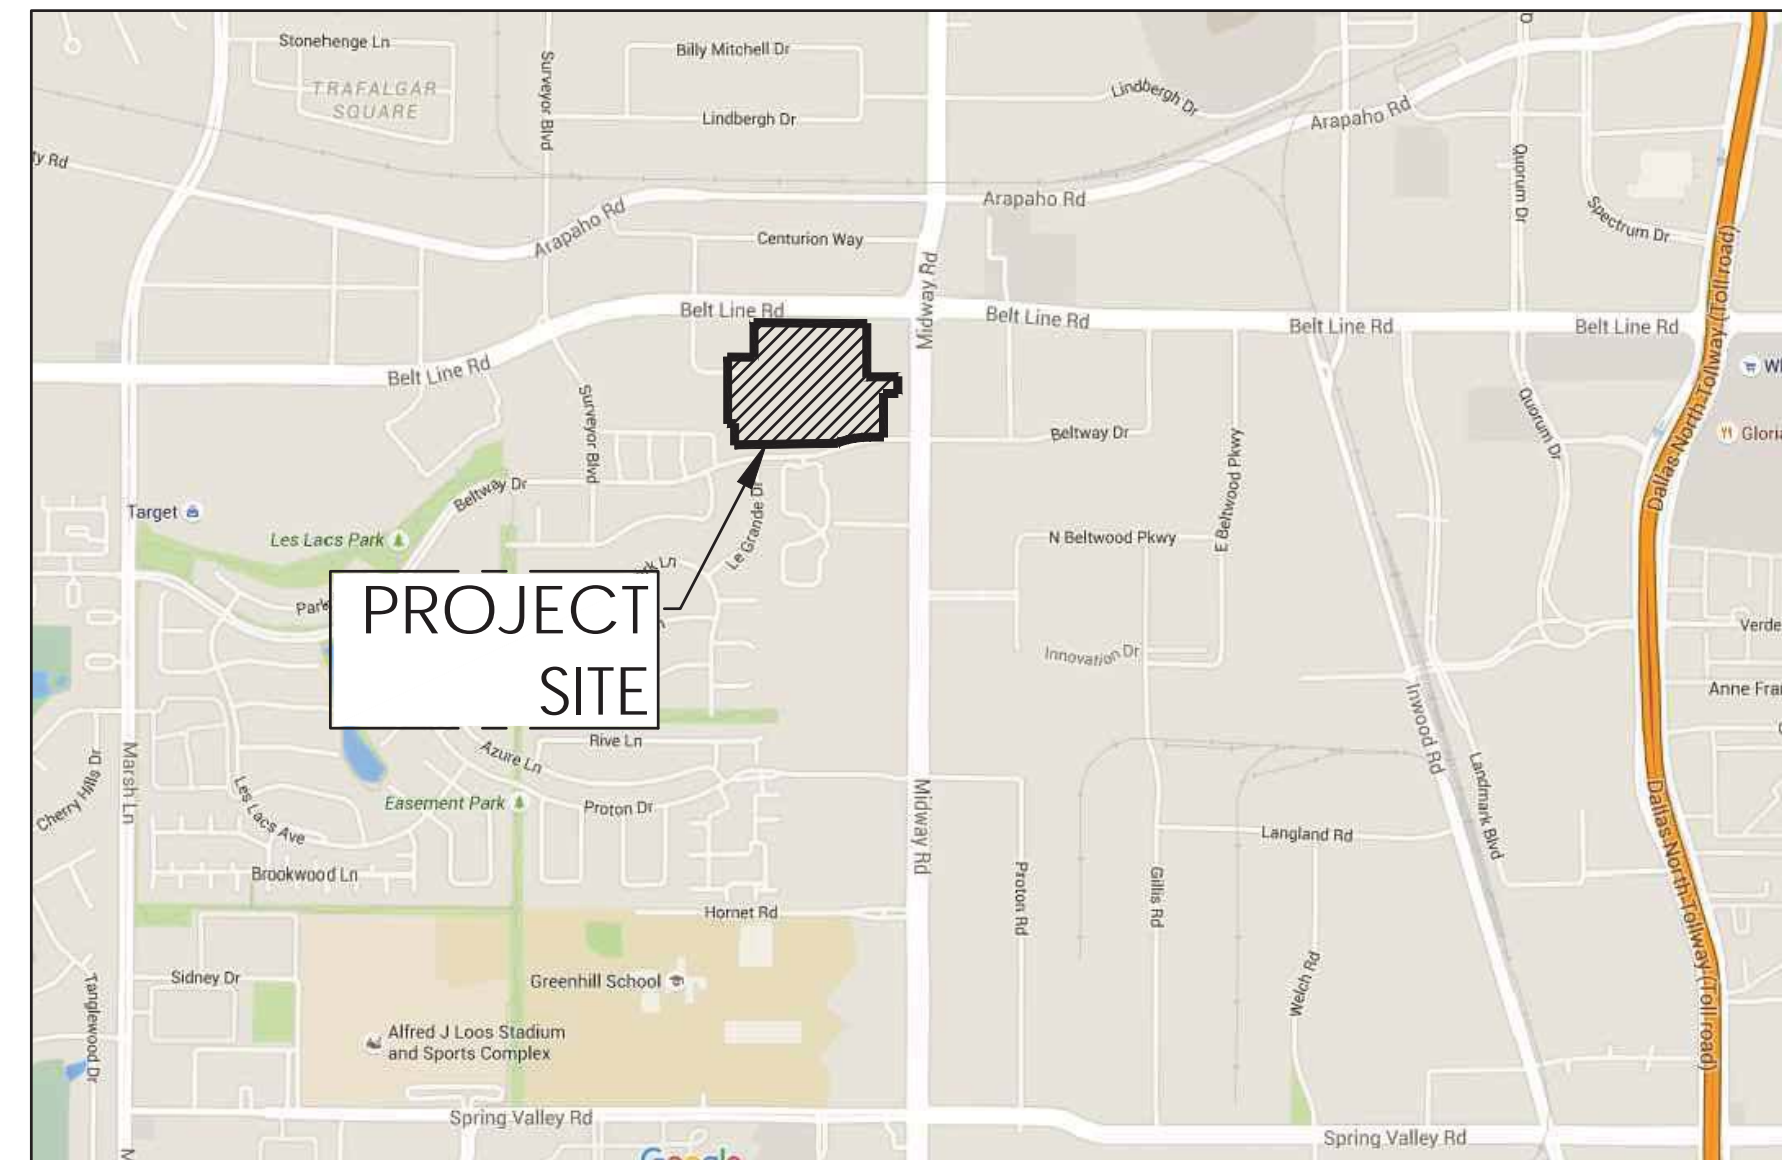

VICINITY MAP  
NOT TO SCALE

**CIVIL ENGINEER**  
SAWYER ENGINEERING, INC.  
1520 OLIVER STREET  
HOUSTON, TEXAS 77007  
TBPE FIRM: F-9171  
PH: (832) 553-5948  
CONTACT: CARMEN PEARSON, P.E.

**SURVEYOR**  
U.S. SURVEYOR  
4929 RIVERWIND POINTE DRIVE  
EVANSVILLE, INDIANA 47715  
PH: (800) TO SURVEY

KIMLEY HORN  
12750 MERIT DRIVE, SUITE 1000  
DALLAS, TEXAS 75251  
FIRM #10115500  
PH: (972) 770-1300

**GEOTECHNICAL ENGINEER**  
GEOSCIENCE INCORPORATED  
2712 SATSUMA DRIVE, SUITE 400  
DALLAS, TEXAS 75229  
TBPE FIRM: F-11285  
PH: (972) 488-3500  
CONTACT: SAYED AFSAR, P.E.

**SAWYER**  
ENGINEERING, LLC  
CIVIL ENGINEERING & PLANNING  
1520 OLIVER STREET  
HOUSTON, TEXAS 77007  
(832) 553-5948  
TBPE FIRM: F-9171

SHEET INDEX	
<b>PUBLIC PLANS</b>	
1	COVER SHEET
2	OVERALL PLAN & PROJECT CONTROLS
3	GENERAL CONSTRUCTION NOTES, LEGEND & ABBREVIATIONS
4	OVERALL PAVING & DRAINAGE PLAN & NOTES
5	PAVING CROSS-SECTIONS
6	PAVING PLAN & PROFILE - OAK STREET
7	PAVING PLAN & PROFILE - RUNYON ROAD (WEST)
8	PAVING PLAN & PROFILE - RUNYON ROAD (EAST)
9	PAVING PLAN & PROFILE - HOLLY STREET
10	PAVING PLAN & PROFILE - MAGNOLIA STREET
11	PAVING MARKING & SIGNING PLAN
12	INTERSECTION SIGHT TRIANGLE LAYOUT
13	TRAFFIC CONTROL PLAN
14	PAVING DETAILS
15	PAVING DETAILS
16	PAVING DETAILS
17	PRE-DEVELOPMENT DRAINAGE PLAN
18	DRAINAGE AREA MAP
19	DRAINAGE AREA CALCULATIONS - DRAINAGE SYSTEM "A"
20	DRAINAGE AREA CALCULATIONS - DRAINAGE SYSTEM "B"
21	INLET & DETENTION CALCULATIONS
22	HYDRAULIC CALCULATIONS
23	STORM DRAIN PLAN & PROFILE - OAK STREET
24	STORM DRAIN PLAN & PROFILE - RUNYON ROAD
25	STORM DRAIN PLAN & PROFILE - HOLLY STREET
26	STORM DRAIN PLAN & PROFILE - MAGNOLIA STREET
27	STORM SEWER LATERAL PROFILES
28	STORM SEWER LATERAL PROFILES
29	EROSION & SEDIMENT CONTROL PLAN
30	EROSION & SEDIMENT CONTROL DETAILS
31	STORM SEWER DETAILS
32	STORM SEWER DETAILS
33	OVERALL WATER & SANITARY SEWER LAYOUT & NOTES
34	WATER LINE AND SANITARY SEWER PLAN & PROFILE - OAK STREET
35	WATER LINE AND SANITARY SEWER PLAN & PROFILE - RUNYON ROAD (WEST)
36	WATER LINE AND SANITARY SEWER PLAN & PROFILE - RUNYON ROAD (EAST)
37	WATER LINE AND SANITARY SEWER PLAN & PROFILE - HOLLY STREET
38	WATER LINE AND SANITARY SEWER PLAN & PROFILE - MAGNOLIA STREET
39	PUBLIC WATER LINE BLOCK "A"
40	PUBLIC WATER LINE BLOCK "B" & "C"
41	PUBLIC WATER LINE BLOCK "D"
42	SANITARY SEWER CROSSING PROFILES
43	WATER LINE DETAILS
44	WATER LINE DETAILS
45	SANITARY SEWER DETAILS
<b>PRIVATE PLANS</b>	
46	PRIVATE GRADING LAYOUT BLOCK A
47	PRIVATE GRADING LAYOUT BLOCK B
48	PRIVATE GRADING LAYOUT BLOCK C
49	PRIVATE GRADING LAYOUT BLOCK D
50	PRIVATE UTILITY LAYOUT BLOCK A
51	PRIVATE UTILITY LAYOUT BLOCK B
52	PRIVATE UTILITY LAYOUT BLOCK C
53	PRIVATE UTILITY LAYOUT BLOCK D
54	PRIVATE UTILITY COORDINATES
55	ONCOR LAYOUT
<b>PLAT</b>	
56	REPLAT ADDISON GROVES
57	REPLAT ADDISON GROVES
58	REPLAT ADDISON GROVES
59	REPLAT ADDISON GROVES

LANDSCAPE REFERENCE PLAN		
L0.0	R.O.W.	LANDSCAPE REFERENCE PLAN
L1.0	R.O.W.	LAYOUT PLAN
L1.1	R.O.W.	LAYOUT PLAN
L1.2	R.O.W.	LAYOUT PLAN
L1.3	R.O.W.	LAYOUT PLAN
L2.0	R.O.W.	HARDSCAPE DETAILS
L2.1	R.O.W.	HARDSCAPE DETAILS
L3.0	R.O.W.	IRRIGATION PLAN
L3.1	R.O.W.	IRRIGATION PLAN
L3.2	R.O.W.	IRRIGATION PLAN
L3.3	R.O.W.	IRRIGATION PLAN
L3.4	R.O.W.	IRRIGATION DETAILS
L3.5	R.O.W.	IRRIGATION DETAILS
L4.0	R.O.W.	LANDSCAPE PLAN
L4.1	R.O.W.	LANDSCAPE PLAN
L4.2	R.O.W.	LANDSCAPE PLAN
L4.3	R.O.W.	LANDSCAPE PLAN
L4.4	R.O.W.	LANDSCAPE DETAILS
L5.0	R.O.W.	SITE FURNISHING AND LIGHTING PLAN
L5.1	R.O.W.	SITE FURNISHING AND LIGHTING PLAN
L5.2	R.O.W.	SITE FURNISHING AND LIGHTING PLAN
L5.3	R.O.W.	SITE FURNISHING AND LIGHTING PLAN
L5.4	R.O.W.	SITE FURNISHING AND LIGHTING DETAILS

PARKS REFERENCE PLAN		
L0.0	PARKS	REFERENCE PLAN
L1.0	PARKS	LAYOUT PLAN
L1.1	PARKS	LAYOUT PLAN
L1.2	PARKS	LAYOUT PLAN
L2.0	PARKS	HARDSCAPE DETAILS
L2.1	PARKS	HARDSCAPE DETAILS
L2.2	PARKS	HARDSCAPE DETAILS
L2.3	PARKS	HARDSCAPE DETAILS
L2.4	PARKS	HARDSCAPE DETAILS
L2.5	PARKS	HARDSCAPE DETAILS
L3.0	PARKS	IRRIGATION PLAN
L3.1	PARKS	IRRIGATION PLAN
L3.2	PARKS	IRRIGATION PLAN
L3.3	PARKS	IRRIGATION PLAN
L3.4	PARKS	IRRIGATION DETAILS
L3.5	PARKS	IRRIGATION DETAILS
L4.0	PARKS	LANDSCAPE PLAN
L4.1	PARKS	LANDSCAPE PLAN
L4.2	PARKS	LANDSCAPE PLAN
L5.0	PARKS	SITE FURNISHING AND LIGHTING PLAN
L5.1	PARKS	SITE FURNISHING AND LIGHTING PLAN
L5.2	PARKS	SITE FURNISHING AND LIGHTING PLAN
L5.3	PARKS	SITE FURNISHING AND LIGHTING DETAILS
L5.4	PARKS	SITE FURNISHING AND LIGHTING DETAILS
L6.0	PARKS	GRADING AND DRAINAGE PLAN
L6.1	PARKS	GRADING AND DRAINAGE PLAN
L6.2	PARKS	GRADING AND DRAINAGE PLAN

GREENSPACE REFERENCE PLAN		
L0.0	GREEN SPACE	LANDSCAPE REFERENCE PLAN
L1.0	GREEN SPACE	LAYOUT PLAN
L1.1	GREEN SPACE	NOT USED
L1.2	GREEN SPACE	LAYOUT PLAN
L1.3	GREEN SPACE	LAYOUT PLAN
L2.0	GREEN SPACE	HARDSCAPE DETAILS
L2.1	GREEN SPACE	HARDSCAPE DETAILS
L2.2	GREEN SPACE	HARDSCAPE DETAILS
L2.3	GREEN SPACE	HARDSCAPE DETAILS
L2.4	GREEN SPACE	HARDSCAPE DETAILS
L2.5	GREEN SPACE	HARDSCAPE DETAILS
L3.0	GREEN SPACE	IRRIGATION PLAN
L3.1	GREEN SPACE	NOT USED
L3.2	GREEN SPACE	IRRIGATION PLAN
L3.3	GREEN SPACE	IRRIGATION PLAN
L3.4	GREEN SPACE	IRRIGATION DETAILS
L3.5	GREEN SPACE	IRRIGATION DETAILS
L4.0	GREEN SPACE	LANDSCAPE PLAN
L4.1	GREEN SPACE	NOT USED
L4.2	GREEN SPACE	LANDSCAPE PLAN
L4.3	GREEN SPACE	LANDSCAPE PLAN
L4.4	GREEN SPACE	LANDSCAPE DETAILS

NOTE: THIS PLAN CONFORMS WITH DESIGN STANDARDS INCLUDED IN THE TOWN OF ADDISON TRANSPORTATION PLAN, WATER SYSTEM REQUIREMENTS, WASTE WATER SYSTEM REQUIREMENTS, AND DRAINAGE CRITERIA MANUAL.



2017/12/19  
SAWYER ENGINEERING, LLC  
TBPE FIRM NUMBER F-9171