



### STORM DRAIN LEGEND

- SANITARY SEWER AND MANHOLE
- SANITARY SEWER AND CLEANOUT
- EXISTING SANITARY SEWER AND MANHOLE
- PROPOSED FIRE HYDRANT ASSEMBLY
- PROPOSED WATERLINE WITH GATE VALVE AND BOX WITH 10' W.L.E.
- EXISTING WATERLINE WITH GATE VALVE AND BOX
- PROPOSED STORM SEWER WITH MANHOLE AND INLETS
- PROPOSED PRIVATE STORM SEWER
- EXISTING STORM SEWER AND MANHOLE
- EXISTING INLET
- PROPOSED TREE WELL
- 2x6 TRUNCATED DOME PANEL

CONTRACTOR TO CONNECT 4" PERFORATED PVC DRAINAGE PIPE TO BACK OF STORM DRAIN INLETS. CONTRACTOR TO DETERMINE FREQUENCY AND LOCATION OF CONNECTIONS TO ALLOW ADEQUATE DRAINAGE OF STRUCTURAL SOIL.

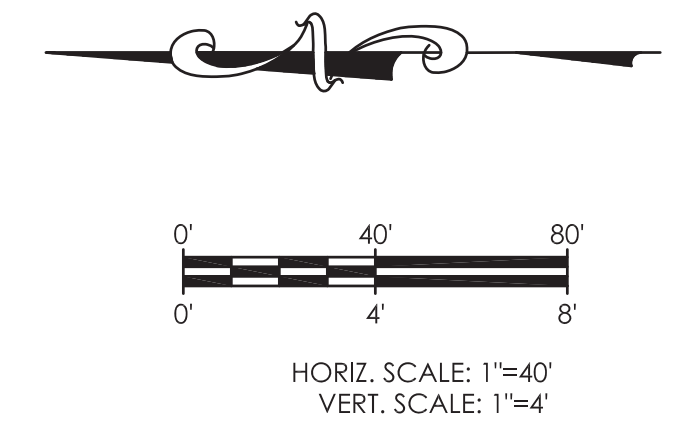

## MAGNOLIA STREET

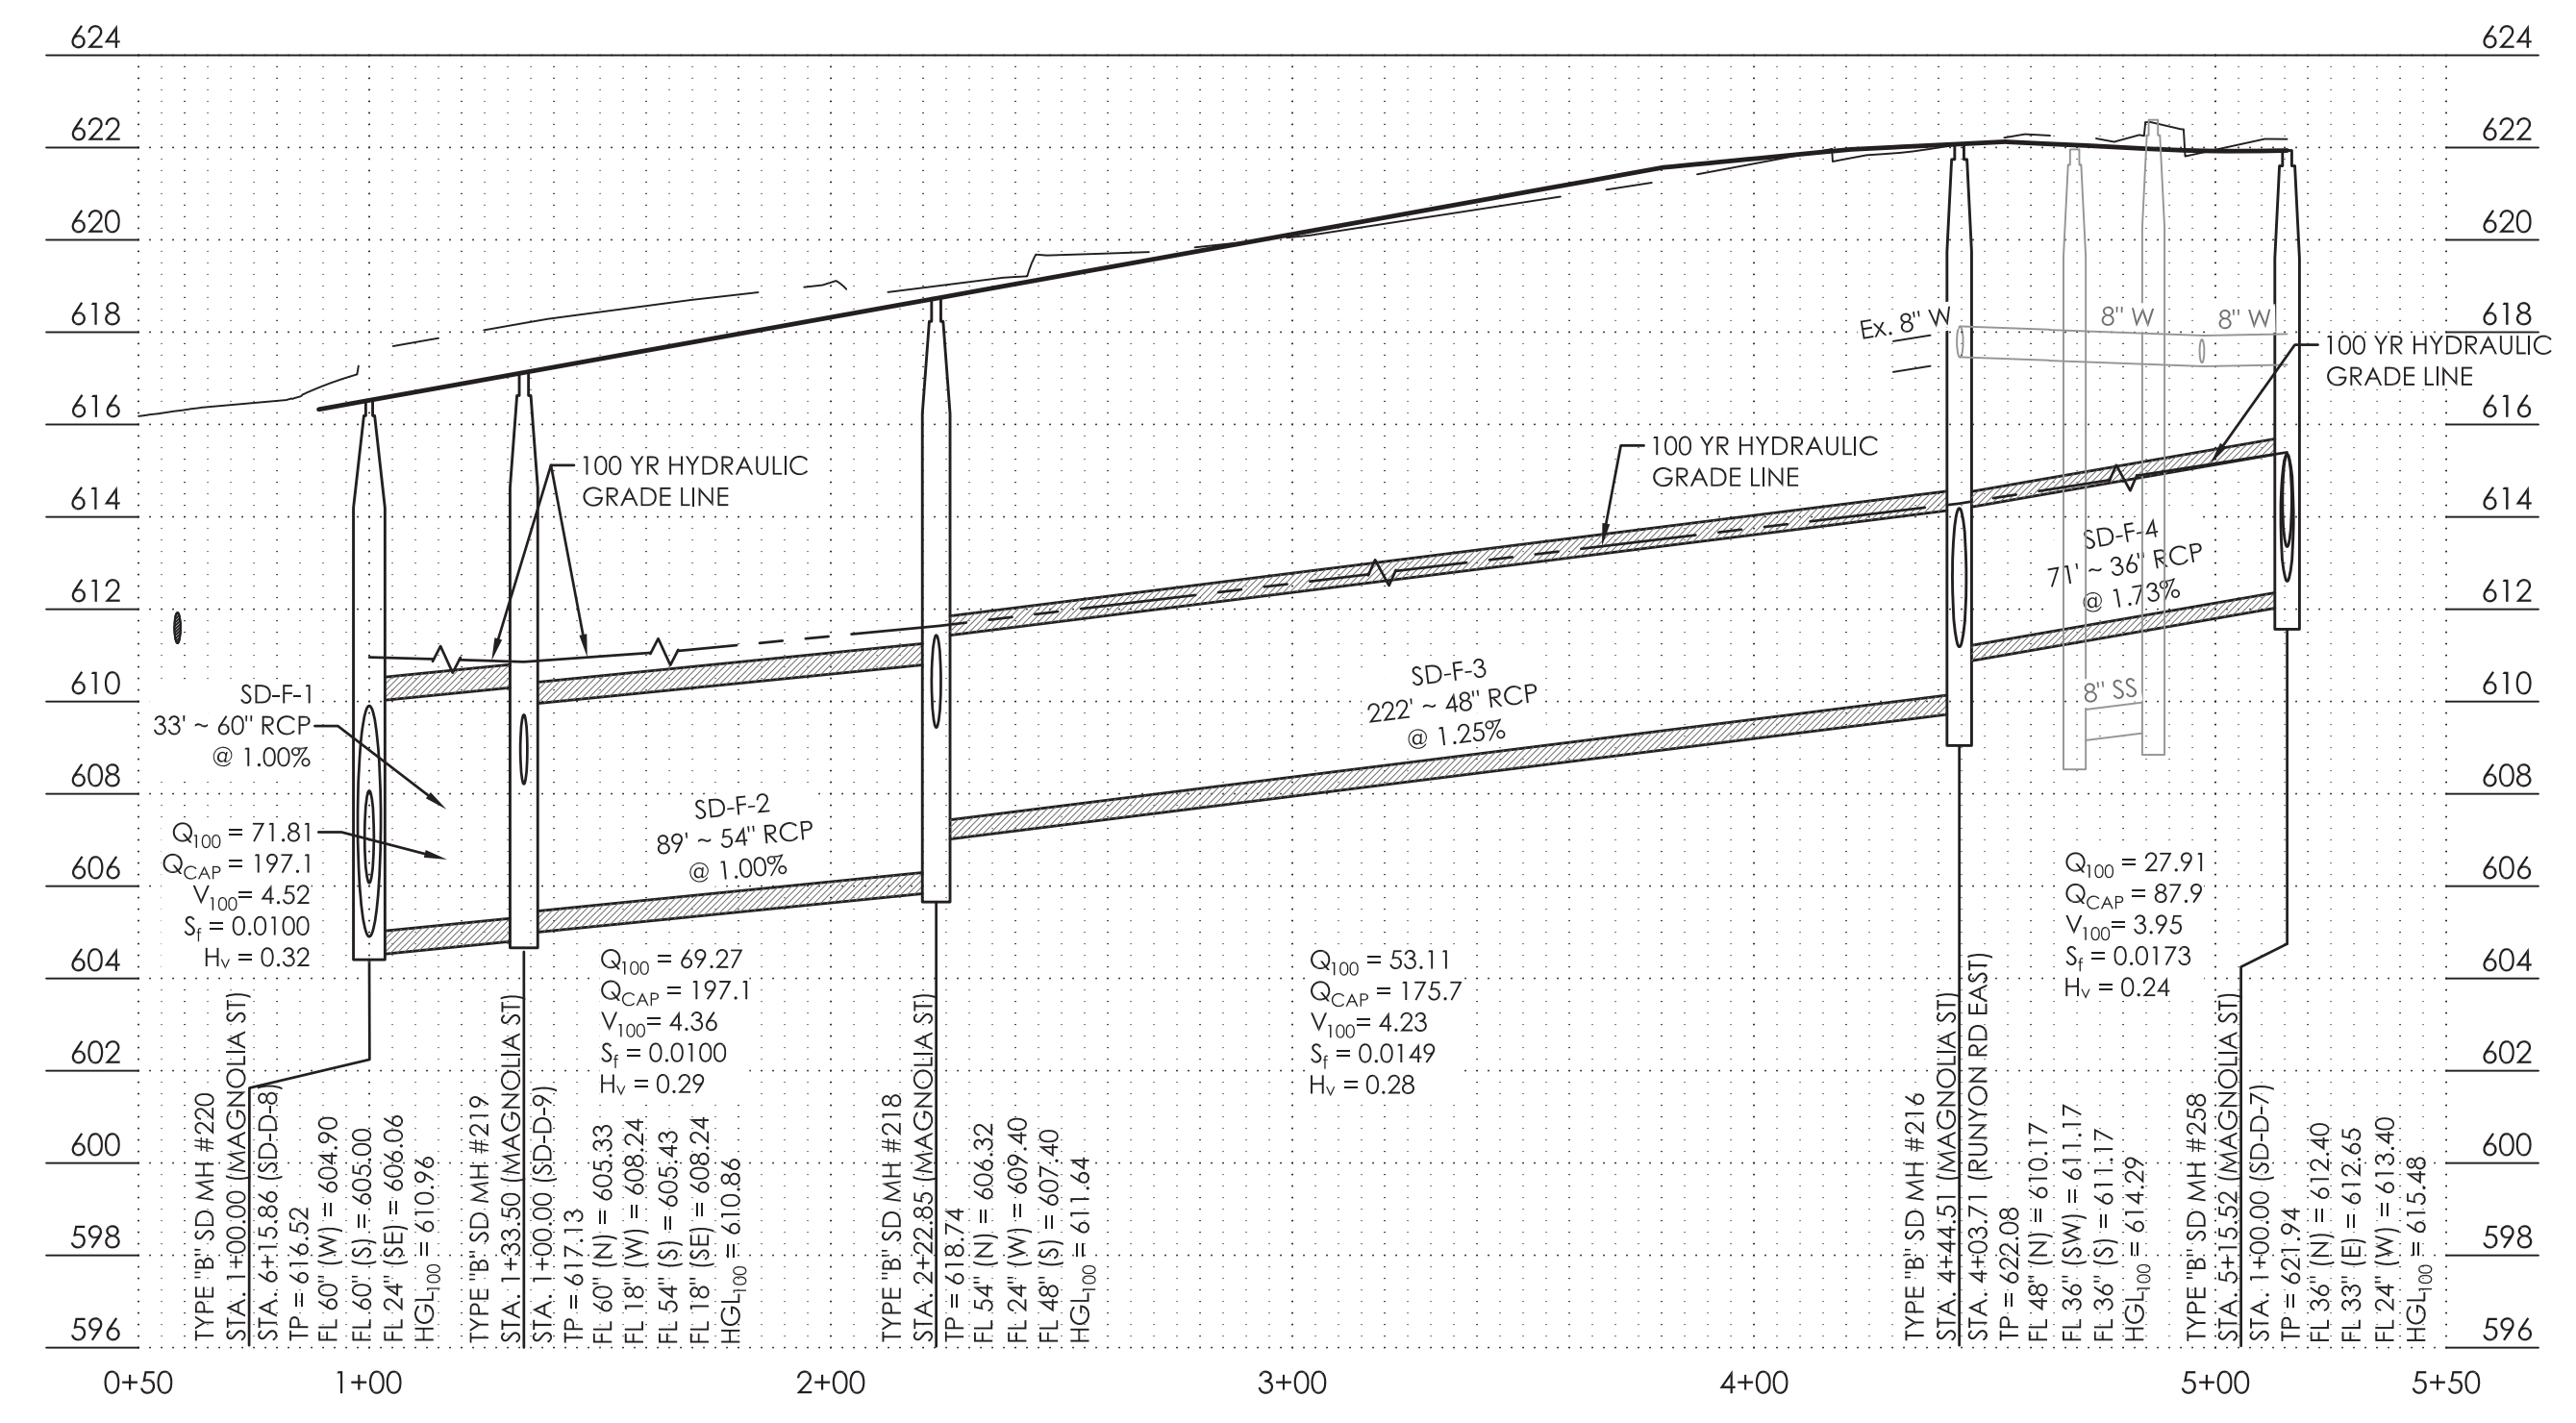

2018/04/04  
 SAWYER ENGINEERING, LLC  
 TBPE FIRM NUMBER F-9171

ONE-CALL NOTIFICATION SYSTEM  
**CALL BEFORE YOU DIG**  
 1-800-545-6005  
 OR OTHER UTILITY LOCATING SERVICES AT  
 LEAST 48 HOURS PRIOR TO  
 CONSTRUCTION ACTIVITIES.

NO.	REVISION	BY	DATE

**TOWN OF ADDISON**  
 DALLAS COUNTY, TEXAS

IMPROVEMENT PLANS  
 ADDISON GROVE

STORM DRAIN PLAN &  
 PROFILE - MAGNOLIA STREET

**SAWYER ENGINEERING, LLC**  
 TBPE: F-9171  
 1520 OLIVER STREET  
 HOUSTON, TEXAS 77007  
 (832) 553-5948

PROJECT	DESIGN	DRAWN	DATE	FILE	SHEET
	CDP	JDS	MAY 2017		26