



FOR ADDISON USE ONLY
 Permit Number: W-1037
 Location: 14612 Hawthorne Ct.

APPLICATION
Right of Way Work Permit -PUBLIC UTILITY/CTP
 (For Public Utility/CTP - Street Cut/Excavation/Lane Closure)

PLEASE PRINT LEGIBLY

Date of application: 12/27/16
 Facility Owner Company: AT&T Company Phone #: 800-924-9420
 Utility/CTP Representative: Susan Esquivel Cell Phone #: 214-467-8276
 General Contractor: Tenex Construction Company Phone #: 972-913-8883
 Site Supervisor Name: Rocky Stockman 24 hour phone #: 214-202-9093
 Work Site Address and Location: 14612 HAWTHORNE CT

Purpose and general description of work: Placement of Phone Service Deep
 Proposed Start Work Date: 12/28/16 Estimated Completion Date: 1/6/17

Pavement Cut? Yes No Directional Bore/Boring? Yes No
 Excavation? Yes No Lane Closure? Yes No Other: _____ ? Yes No

Kim Dines Applicant's Printed Name Kim Dines Signature Office Manager Position with Company

Applicant's Email: Kim@tenexconstruction.com Applicant's Phone Number: 972-913-8883
Rocky Stockman Direct Supervisor's Printed Name 214-202-9093 Phone Number Tenex Construction Company Name

FOR ADDISON USE ONLY

Received By: MP Entered? Yes Received Date: 12/27/16 3:48PM
 Approved By: Dave Wilde Inspector: JC Issue Date: 12/28/16
 Plans Submitted? Yes No N/A Traffic Control Plan Submitted? Yes No N/A Expiration Date: 1/18/17
 Insurance Provided? Yes No On File Performance/Maintenance Bond? Yes No On File N/A

Fee Paid: NA Receipt#: CTP Date: 12-30-16 Processed By: Nieder S.
 Picked Up By: Rocky Company: Tenex Date & Time: 12-30-16

TOWN OF ADDISON INFRASTRUCTURE AND DEVELOPMENT SERVICES
 DEPARTMENT ATTN.: RIGHT OF WAY PERMIT - DAVE WILDE 972-450-2847
 16801 WESTGROVE RD. ADDISON, TX 75001-9010
 PHONE: 972-450-2871 FAX: 972-450-2837

3:03PM



FOR ADDISON USE ONLY	
Permit Number:	<u>115-1037</u>
Location:	<u>14612 Hawthorne St.</u>

APPLICATION
Right of Way Work Permit -PUBLIC UTILITY/CTP
 (For Public Utility/CTP - Street Cut/Excavation/Lane Closure)

Sub-Contractor List

PLEASE PRINT LEGIBLY

General Contractor's Name: Tenex Construction General Contractor's Phone #: 972-913-8883

Sub-Contractor #1 Company Name: Magdalena Almaraz Address: _____

Print Sub-Contractor's Name: Magdalena Almaraz Sub-Contractor Phone #: 972-872-5271

Print Site Supervisor's Name: Rocky Stockman Supervisor's Phone #: 214-202-9093

Insurance Provided? Yes No On File

Sub-Contractor #2 Company Name: Ascension Rodriguez Address: _____

Print Sub-Contractor's Name: Ascension Rodriguez Sub-Contractor Phone #: 972-394-0771

Print Supervisor's Name: Rocky Stockman Supervisor's Phone #: 214-202-9093


Insurance Provided? Yes No On File

Sub-Contractor #3 Company Name: _____ Address: _____

Print Sub-Contractor's Name: _____ Sub-Contractor Phone #: _____

Print Supervisor's Name: _____ Supervisor's Phone #: _____

Insurance Provided? Yes No On File

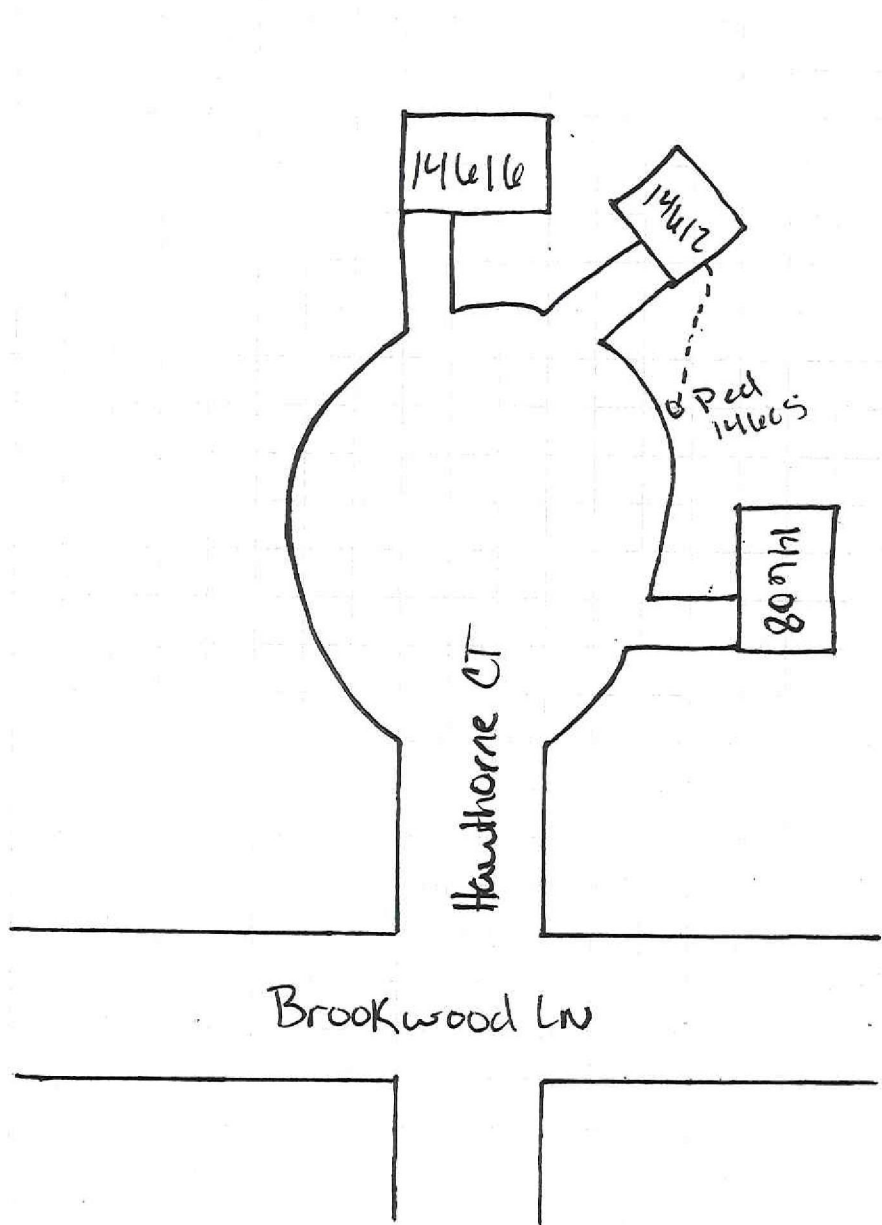

ATT/Tenex Cont
log 7800898
14612 Hawthorne Ct
Addison Tx