

| FOR | <b>ADDISON</b> | USE | ONLY | - |
|-----|----------------|-----|------|---|
|-----|----------------|-----|------|---|

Permit Number:

# **APPLICATION**

## Right of Way Work Permit -PUBLIC UTILITY/CTP

(For Public Utility/CTP - Street Cut/Excavation/Lane Closure)

| PLEASE PRINT LEGIBLY  Date of application: 12/28/1/e   |  |  |  |  |  |
|--|--|--|--|--|--|
| Facility Owner Company: AT+T Company Phone #: 800-924-9420   |  |  |  |  |  |
| Utility/CTP Representative: Susan Esquivol Cell Phone #: 214-467-8276  |  |  |  |  |  |
| General Contractor: Tenex Construction Company Phone #: 472-913-8883   |  |  |  |  |  |
| Site Supervisor Name: Bocky Stockman 24 hour phone #: 214-2021-9093  |  |  |  |  |  |
| Work Site Address and Location: 14819 Sopras Cir   |  |  |  |  |  |
| Purpose and general description of work: Placement of Phone Service Deop   |  |  |  |  |  |
| Proposed Start Work Date: 12/30/11e Estimated Completion Date: 1/19/17   |  |  |  |  |  |
| Pavement Cut? ☐Yes ☑No Directional Bore/Boring? ☐Yes ☑No   |  |  |  |  |  |
| Excavation?     Yes   Mo   Lane Closure?   Yes   Mo   Other:   ?     Yes     No  |  |  |  |  |  |
| Applicant's Printed Name  Signature  Ducco Manager  Position with Company  |  |  |  |  |  |
| Applicant's Email: Kim@ tenexconstruction Applicant's Phone Number: 972-913-8883   |  |  |  |  |  |
| Bocky Stockman  Direct Supervisor's Printed Name  Direct Supervisor's Printed Name  Direct Supervisor's Printed Name  Direct Supervisor's Printed Name  Phone Number  Company Name |  |  |  |  |  |
| FOR ADDISON USE ONLY   |  |  |  |  |  |
| Received By: Michael Simpson Entered? DYes Received Date: 12-78-16   |  |  |  |  |  |
| Approved By: Dave Wille Inspector: J& Issue Date: 12/29/16   |  |  |  |  |  |
| Plans Submitted? ☑Yes ☐No ☐N/A Traffic Control Plan Submitted? ☐Yes ☑No ☐N/A Expiration Date:  |  |  |  |  |  |
| Insurance Provided? □Yes □No □On File Performance/Maintenance Bond? □Yes □No □On File ☑N/A   |  |  |  |  |  |
| Fee Paid: NA Receipt#: CTP Date: 12-30-11 Processed By: MCCLS  |  |  |  |  |  |
| Picked Up By: Company: The & Time: (28) - Company: Date & Time:  |  |  |  |  |  |
| TOWN OF ADDISON INFRASTRUCTURE AND DEVELOPMENT SERVICES 5:07 PM  |  |  |  |  |  |

DEPARTMENT ATTN.: RIGHT OF WAY PERMIT - DAVE WILDE 972-450-2847 16801 WESTGROVE RD. ADDISON, TX 75001-9010 PHONE: 972-450-2871 FAX: 972-450-2837



PLEASE PRINT LEGIBLY

Insurance Provided? □Yes □No □On File

| FUR ADDISON USE ON | DDISON USE ONL | F ONLY |
|--------------------|----------------|--------|
|--------------------|----------------|--------|

Permit Number:

Location: 48/9 Sopras Cir


#### **APPLICATION**

## Right of Way Work Permit -PUBLIC UTILITY/CTP

(For Public Utility/CTP - Street Cut/Excavation/Lane Closure)

### **Sub-Contractor List**

| General Contractor's Name: Tenex Construction      | General Contractor's Phone #: 972-913-999 |
|--|---|
| Sub-Contractor #1 Company Name Magdolono Umaroz    | Address:                                  |
|  |   |
| Print Site Supervisor's Name: ROCK J Stockman      | Supervisor's Phone #: 214-202-9093        |
| Insurance Provided? ⊓Yes ⊓No ₽On File              |   |
| Sub-Contractor #2 Company Name: Ascension Robeigue | Address:                                  |
| Print Sub-Contractor's Name Ascension Ruderque     | Sub-Contractor Phone #: 972-394-0971      |
| Print Supervisor's Name: Rocky Stockman            | Supervisor's Phone #: 24-202-9093         |
| Insurance Provided? □Yes □No ੴn File               |   |
| Sub-Contractor #3 Company Name:                    | Address:                                  |
| Print Sub-Contractor's Name:                       | Sub-Contractor Phone #:                   |
| Print Supervisor's Name:                           | Supervisor's Phone #:                     |

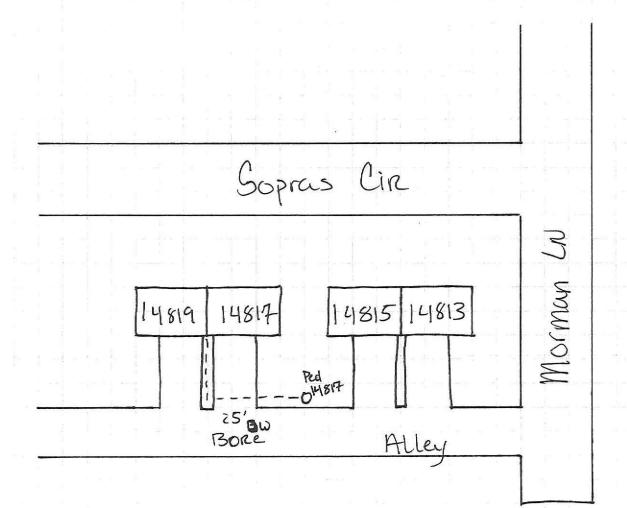

MAT/Tenex Const Log 7831845 14819 Sopras Cir Addison, TX