



FOR ADDISON USE ONLY
 Permit Number: W-1048
 Location: 4801 Belt Line

APPLICATION

Right of Way Work Permit -FRANCHISE

(For Franchise Utility/CTP - Street Cut/Excavation/Lane Closure)

PLEASE PRINT LEGIBLY

Date of Application: 1-25-17
 Facility Owner Company: SPECTRUM Company Phone #: _____
 Utility/CTP Representative: _____ Cell Phone #: _____
 Utility/CTP Representative E-Mail: _____
 General Contractor: Beyond Broadband Solutions Company Phone #: 214-501-4300
 Site Supervisor Name: Jovany Vazquez 24-hour phone #: 214-773-1054
 Contractor E-Mail address: jvazquez@beyondbroadband.com Site Foreman E-Mail: _____
 Work Site Address and Location: 4801 Belt Line Rd. - Per Wei
 Purpose and general description of work: 100ft of bury trench, 6" / 4" grass.
 Proposed Start Work Date: 1-26-17 Estimated Completion Date: 1-30-17
 Pavement Cut? Yes No Directional Bore/Boring? Yes No
 Excavation? Yes No Lane Closure? Yes No Other: _____ ? Yes No
JOVANY VAZQUEZ [Signature] SUPERVISOR
 Applicant's Printed Name Signature Position with Company
 Applicant's Email: jvazquez@beyondbroadband.com Applicant's Phone Number: 214-773-1054



Direct Supervisor's Printed Name _____ Phone Number _____ Company Name _____
 Supervisor's E-Mail: _____

FOR ADDISON USE ONLY

Received By: Melissa Simpson Entered? Yes Received Date: 1-25-17
 Approved By: Dave Wilde Inspector: JF Issue Date: 1/20/17
 Plans Submitted? Yes No N/A Traffic Control Plan Submitted? Yes No N/A Expiration Date: 2/9/17
 Insurance Provided? Yes No On File Performance/Maintenance Bond? Yes No On File N/A
 Fee Paid: NA Receipt#: CTP Date: _____ Processed By: _____
 Picked Up By: JOVANY VAZQUEZ Company: BBS Date & Time: 1/27/17

TOWN OF ADDISON INFRASTRUCTURE AND DEVELOPMENT SERVICES
 DEPARTMENT ATTN.: RIGHT OF WAY PERMIT - DAVE WILDE 972-450-2847
 16801 WESTGROVE RD. ADDISON, TX 75001-9010
 PHONE: 972-450-2871 FAX: 972-450-2837

9:41 pm

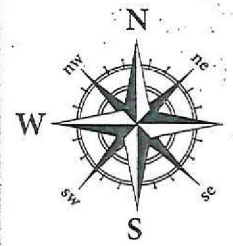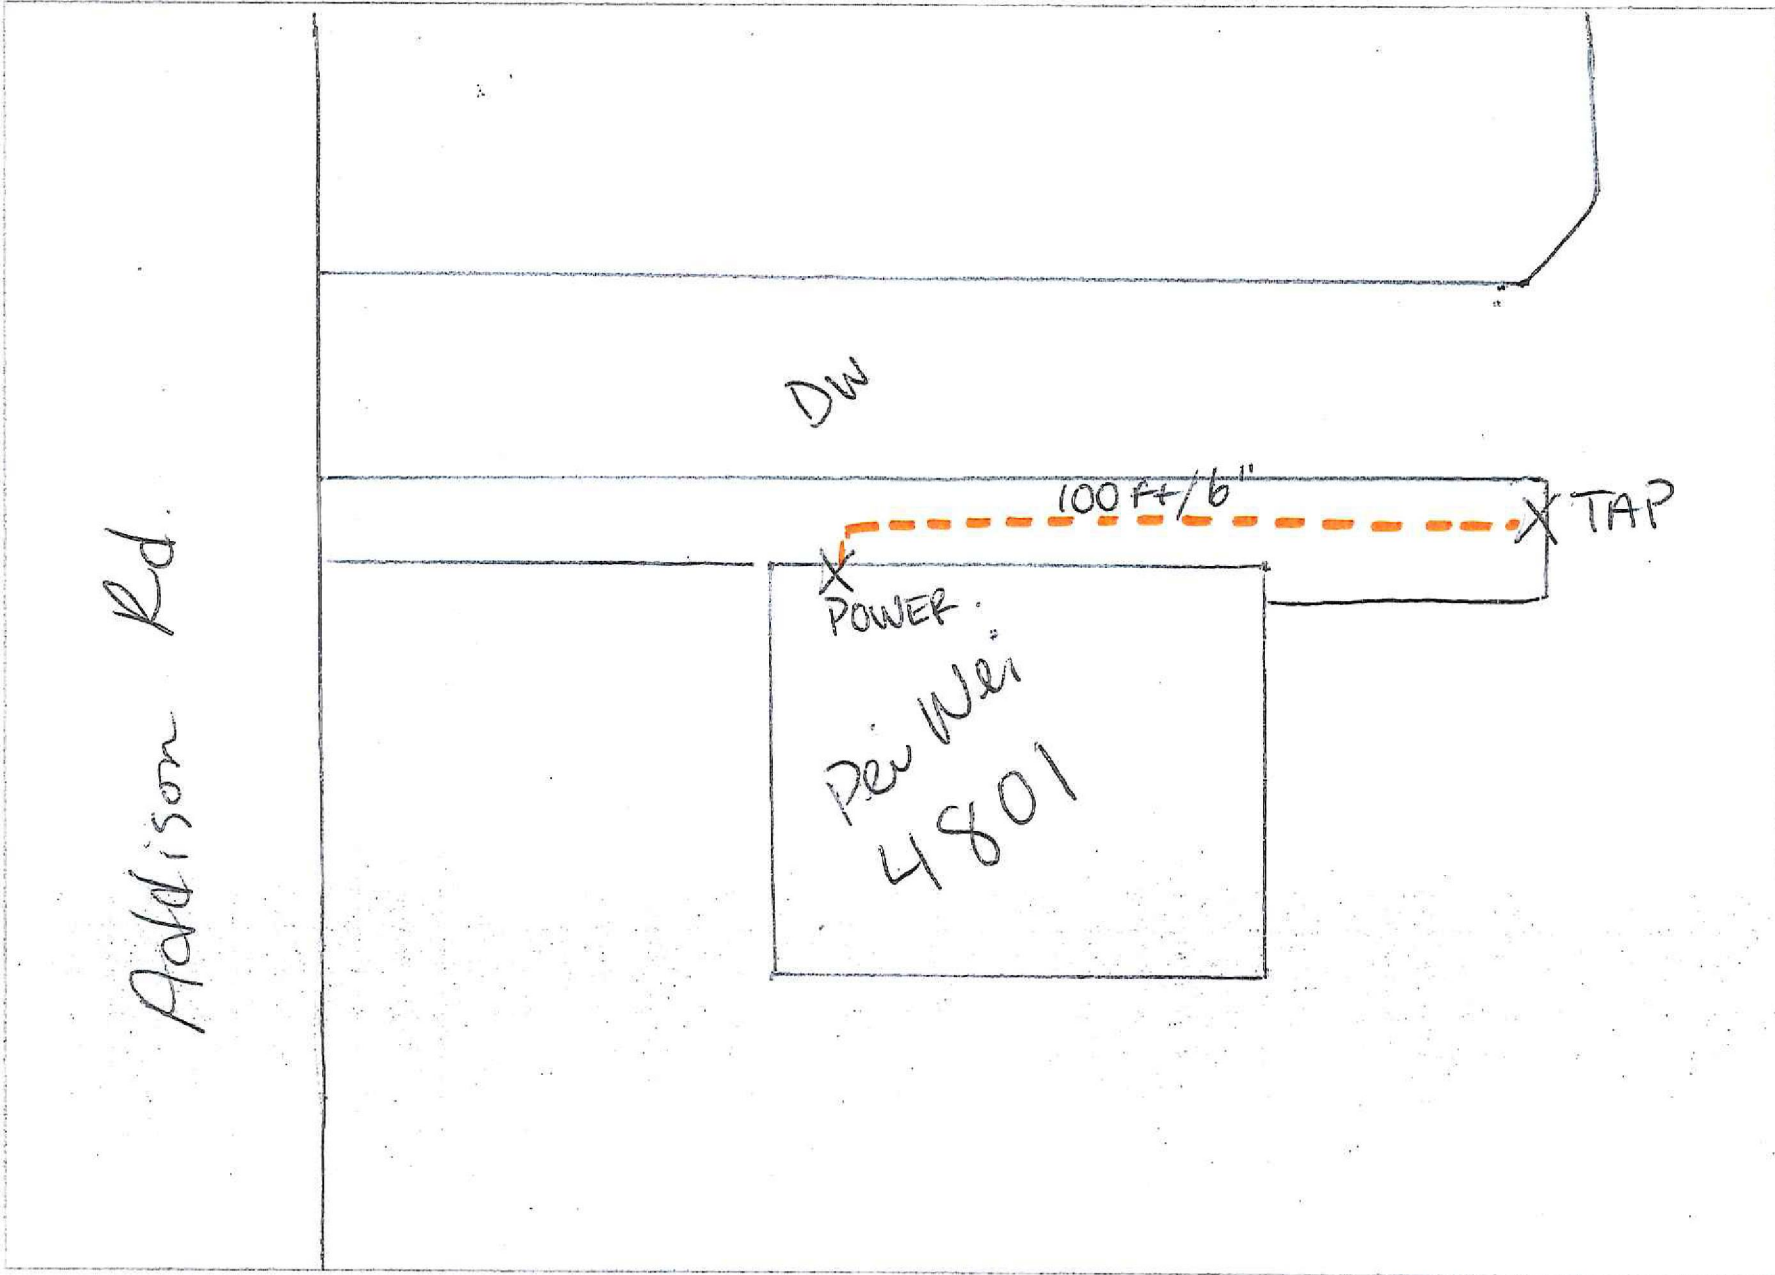

STREET NAME: 4801 Belt Line Rd. CITY: Addison ZIP: 75001