

FOR	ADDI	MOS	LISE	ONL	٧

APPLICATION

Right of Way Work Permit -PUBLIC UTILITY/CTP

(For Public Utility/CTP - Street Cut/Excavation/Lane Closure)

PLEASE PRINT LEGIBLY Date of application: 1/23/17
Facility Owner Company: AT+T Company Phone #: 800-934-9430
Utility/CTP Representative: SUSAN ESQUIVOD Cell Phone #: 214-467-8276
General Contractor: Tenex Construction Company Phone #: 972-913-8883
Site Supervisor Name: Bocky Sockman 24 hour phone #: 214-202-9093
Work Site Address and Location: 4144 Towne GREEN CIR
Purpose and general description of work: Placement of Phone Service Deop
Proposed Start Work Date: 1/24/17 Estimated Completion Date: 2/4/17
Pavement Cut? □Yes ☑No Directional Bore/Boring? □Yes ☑No
Excavation? Yes No Lane Closure? Yes Other: ? Yes No
Applicant's Printed Name Signature Which Manager Position with Company
Applicant's Email: Kim@ tenexconstruction Applicant's Phone Number: 972-913-8883
Rocky Stockman Direct Supervisor's Printed Name Name Name Name Name Name
FOR ADDISON USE ONLY
Received By: Mcole Sunger Entered? DYes Received Date: 1/24/17
Approved By: David Libble Inspector: TE Issue Date: 1/2-4/17
Plans Submitted? ☐Yes ☐No ☐N/A Traffic Control Plan Submitted? ☐Yes ☐No ☐N/A Expiration Date: 2/2///
Insurance Provided? ☐Yes ☐No ☐On File Performance/Maintenance Bond? ☐Yes ☐No ☐On File ☑N/A
Fee Paid: NA Receipt#: CTP Date: Processed By:
Picked Up By: Rocky Company: Teland Date & Time: 1/34/17 9:45 AM

TOWN OF ADDISON INFRASTRUCTURE AND DEVELOPMENT SERVICES DEPARTMENT ATTN.: RIGHT OF WAY PERMIT - DAVE WILDE 972-450-2847 16801 WESTGROVE RD. ADDISON, TX 75001-9010

PHONE: 972-450-2871 FAX: 972-450-2837



PLEASE PRINT LEGIBLY

Print Supervisor's Name: ₹

EOP	ADD	ICON	USE	OAH	11
FUR	AUU	NUCI	USE	UNI	. Y

Permit Number: W-109

Supervisor's Phone #: 214-0

Location: 414 Towns Gray (in

APPLICATION

Right of Way Work Permit -PUBLIC UTILITY/CTP

(For Public Utility/CTP - Street Cut/Excavation/Lane Closure)

Sub-Contractor List

General Contractor's Name: Tenex Construction General Contractor's Phone #: 972-913-999
Sub-Contractor #1 Company Name: Magdolono Umaroz Address: Print Sub-Contractor's Name: Magdolono Umaroz Sub-Contractor Phone #: 40-812-501
Print Sub-Contractor's Name: Magdolono almony Sub-Contractor Phone #: 90-87-501
Print Site Supervisor's Name: 214-202-9093
Insurance Provided? □Yes □No POn File
Sub-Contractor #2 Company Name: According Rodeland Address:

Print Sub-Contractor's Name & Consion Rudrigue Sub-Contractor Phone #472-394

Print Sub-Contractor's Name:______ Sub-Contractor Phone #: _____

Print Supervisor's Name:_____ Supervisor's Phone #: _____


Supervisor's Priorie #

Insurance Provided? □Yes □No □On File

Insurance Provided? ☐Yes ☐No ☑On File

7-1

ATOT/Tenex Const Log 7718 904 4144 Towne Green Gr Addison, TX

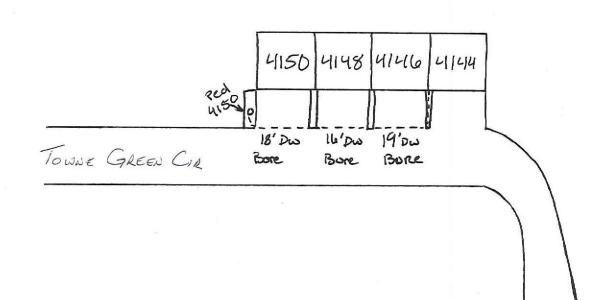

)