



FOR ADDISON USE ONLY
 Permit Number: W-1053
 Location: 4820 Westgrove

APPLICATION

Right of Way Work Permit -FRANCHISE

(For Franchise Utility/CTP - Street Cut/Excavation/Lane Closure)

PLEASE PRINT LEGIBLY


Date of Application: 1-27-17
 Facility Owner Company: Spectrum Company Phone #: _____
 Utility/CTP Representative: Johana Debnia Cell Phone #: 214-501-4300
 Utility/CTP Representative E-Mail: _____
 General Contractor: Beyond Broadband Solutions Company Phone #: 214-501-4300
 Site Supervisor Name: Jovany Vazquez 24-hour phone #: 214-773-1054
 Contractor E-Mail address: JV@Beyondbroadband.com Site Foreman E-Mail: _____
 Work Site Address and Location: 4820 Westgrove Dr.
 Purpose and general description of work: 100 ft bury trench, 6", grass.
 Proposed Start Work Date: 1-28-17 Estimated Completion Date: 2-2-17
 Pavement Cut? Yes No Directional Bore/Boring? Yes No
 Excavation? Yes No Lane Closure? Yes No Other: _____ ? Yes No
 Applicant's Printed Name: Jovany Vazquez Signature: [Signature] Position with Company: Supervisor
 Applicant's Email: JVazquez@beyondbroadband.com Applicant's Phone Number: _____
 Direct Supervisor's Printed Name: Edgar Moneje Phone Number: 214-243-3162 Company Name: BBS
 Supervisor's E-Mail: _____

FOR ADDISON USE ONLY


Received By: Bla. Insp. Entered? Yes No Received Date: 1/27/17 4:50 pm
 Approved By: Dave Wilde Inspector: JF Issue Date: 1/31/17
 Plans Submitted? Yes No N/A Traffic Control Plan Submitted? Yes No N/A Expiration Date: 2/14/17
 Insurance Provided? Yes No On File Performance/Maintenance Bond? Yes No On File N/A
 Fee Paid: NA Receipt#: CTP Date: 1-31-17 Processed By: Melissa S.
 Picked Up By: Jovany Company: BBS Date & Time: 1-31-17 12:09 PM

TOWN OF ADDISON INFRASTRUCTURE AND DEVELOPMENT SERVICES
 DEPARTMENT ATTN.: RIGHT OF WAY PERMIT - DAVE WILDE 972-450-2847
 16801 WESTGROVE RD. ADDISON, TX 75001-9010
 PHONE: 972-450-2871 FAX: 972-450-2837

Westgrove Dr.

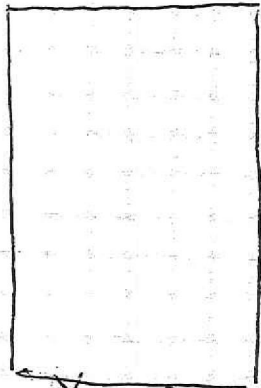

X TAP

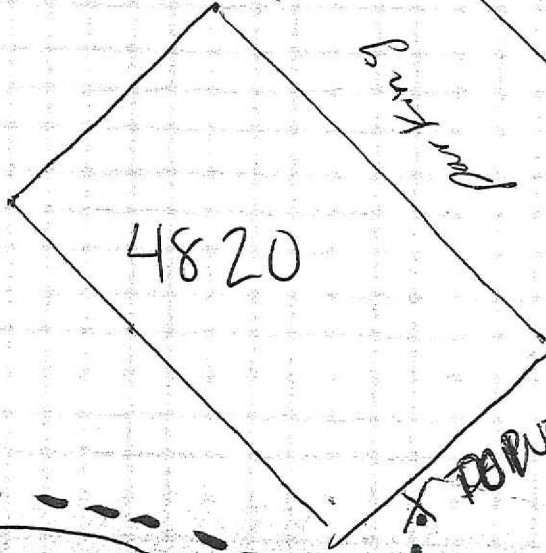


4820

Parking

grass

X POWER


110 Ft

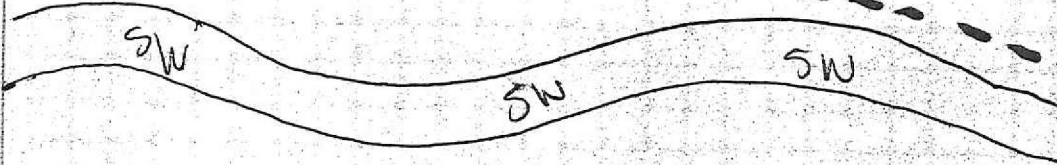

SW


SW

SW

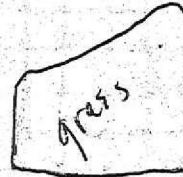

grass

Ledgeмонт Ln.

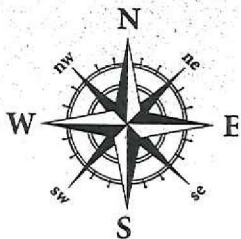

STREET NAME: 4820 Westgrove Dr CITY: Addison ZIP: 75001