



FOR ADDISON USE ONLY

Permit Number: W-1044
Location: 14675 Winnwood

APPLICATION

Right of Way Work Permit - PUBLIC UTILITY/CTP

(For Public Utility/CTP - Street Cut/Excavation/Lane Closure)

PLEASE PRINT LEGIBLY

Date of application: 01-18-17

Facility Owner Company: AT&T Company Phone #: 800-924-9420

Utility/CTP Representative: Susan Esquivel Cell Phone #: 214-467-8276

General Contractor: Tenex Construction Company Phone #: 972-913-8883

Site Supervisor Name: Rocky Stockman 24 hour phone #: 214-202-9093

Work Site Address and Location: 14675 Winnwood Rd

Purpose and general description of work: Placement of Phone Service Drop

Proposed Start Work Date: 01-19-17 Estimated Completion Date: 02-02-17

Pavement Cut? Yes No Directional Bore/Boring? Yes No

Excavation? Yes No Lane Closure? Yes No Other: _____? Yes No

Kim Dines Applicant's Printed Name Kim Dines Signature Office Manager Position with Company

Applicant's Email: Kim@tenexconstruction.com Applicant's Phone Number: 972-913-8883

Rocky Stockman Direct Supervisor's Printed Name 214-202-9093 Phone Number Tenex Construction Company Name

FOR ADDISON USE ONLY

Received By: Nicole Simpson Entered? Yes Received Date: 1-18-17

Approved By: Dave Wilde Inspector: JF Issue Date: 1-19-17

Plans Submitted? Yes No N/A Traffic Control Plan Submitted? Yes No N/A Expiration Date: 2-2-17

Insurance Provided? Yes No On File Performance/Maintenance Bond? Yes No On File N/A

Fee Paid: NA Receipt#: CTP Date: 01-23-17 Processed By: Nicole Simpson

Picked Up By: Rocky Company: Tenex Date & Time: 01-23-17 3:32 PM

TOWN OF ADDISON INFRASTRUCTURE AND DEVELOPMENT SERVICES
DEPARTMENT ATTN.: RIGHT OF WAY PERMIT - DAVE WILDE 972-450-2847
16801 WESTGROVE RD. ADDISON, TX 75001-9010
PHONE: 972-450-2871 FAX: 972-450-2837



FOR ADDISON USE ONLY	
Permit Number:	<u>W-1044</u>
Location:	<u>14675 Wismar</u>

APPLICATION
Right of Way Work Permit - PUBLIC UTILITY/CTP
(For Public Utility/CTP - Street Cut/Excavation/Lane Closure)

Sub-Contractor List

PLEASE PRINT LEGIBLY

General Contractor's Name: Tenex Construction General Contractor's Phone #: 972-913-8893

Sub-Contractor #1 Company Name: Magdalena Alvarez Address: _____

Print Sub-Contractor's Name: Magdalena Alvarez Sub-Contractor Phone #: 972-812-5271

Print Site Supervisor's Name: Rocky Stockman Supervisor's Phone #: 214-202-9093

Insurance Provided? Yes No On File

Sub-Contractor #2 Company Name: Ascension Rodriguez Address: _____

Print Sub-Contractor's Name: Ascension Rodriguez Sub-Contractor Phone #: 972-394-0971

Print Supervisor's Name: Rocky Stockman Supervisor's Phone #: 214-202-9093


Insurance Provided? Yes No On File

Sub-Contractor #3 Company Name: _____ Address: _____

Print Sub-Contractor's Name: _____ Sub-Contractor Phone #: _____

Print Supervisor's Name: _____ Supervisor's Phone #: _____

Insurance Provided? Yes No On File

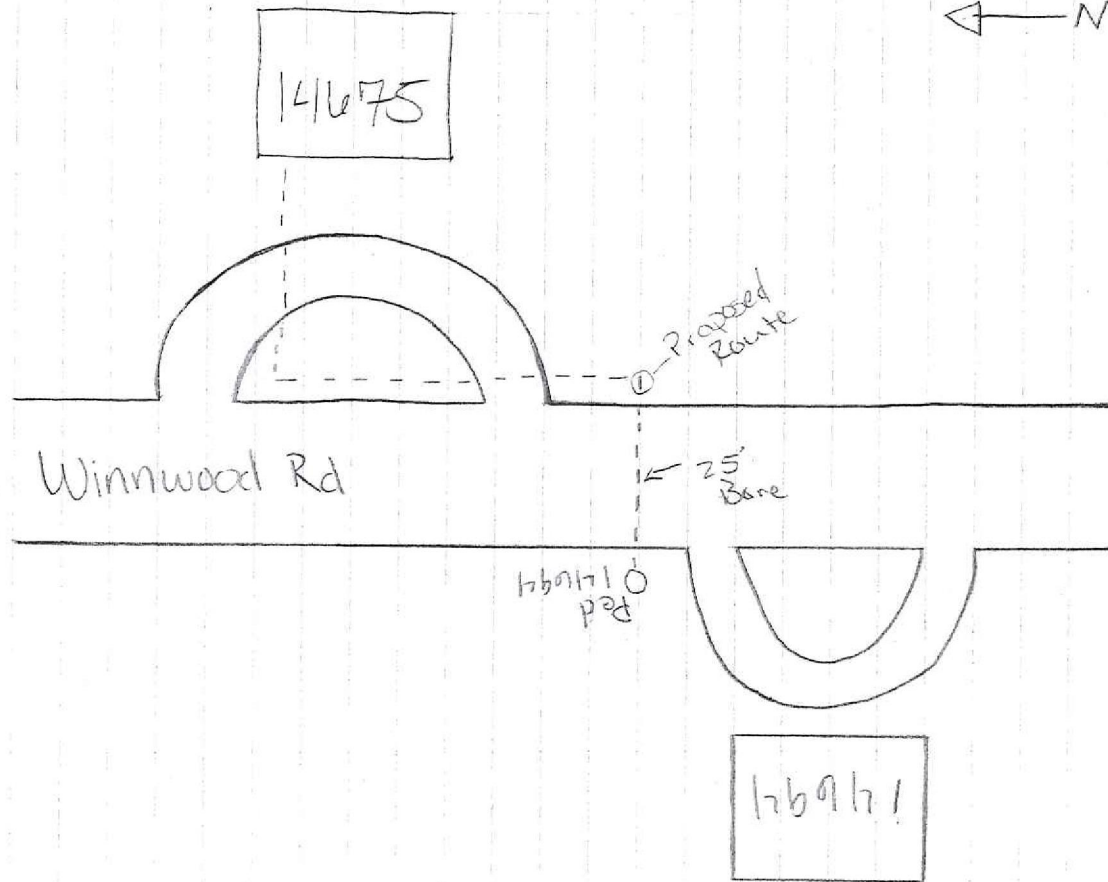

AT&T/Tenex Const
Log 7872421
141675 Winnwood Rd
Addison, TX