



This is the revised  
 ROW Application for  
 Level 3's project  
 14675 Dallas Pkwy.

FOR ADDISON USE ONLY  
 Permit Number: W-1072  
 Location: 14675 Dallas Pkwy


**PLEASE PRINT**

Date of Application: \_\_\_\_\_  
 Facility Owner: \_\_\_\_\_ Company Phone #: 214.764.2521  
 Utility/CTP Representative: Craig Burns Cell Phone #: 214.435.3298  
 Utility/CTP Representative E-Mail: craig.burns@level3.com/charles@tgainc.net  
 General Contractor: Future Telecom Company Phone #: 972.329.6400  
 Site Supervisor Name: Ricky Riggs 24-hour phone #: 972.877.9408  
 Contractor E-Mail address: ricky@futuretelco.com Site Foreman E-Mail: \_\_\_\_\_  
 Work Site Address and Location: 14675 Dallas Pkwy  
 Purpose and general description of work: Contractor to place 3-1.25" HDPE w/48F cable on Dallas Pkwy Service Rd (#16393)  
 Proposed Start Work Date: February 20, 2017 Estimated Completion Date: July 10, 2017  
 Pavement Cut?  Yes  No Directional Bore/Boring?  Yes  No  
 Excavation?  Yes  No Lane Closure?  Yes  No Other: \_\_\_\_\_?  Yes  No  
 Applicant's Printed Name: Craig Burns Signature: [Signature] Position with Company: Project Manager  
 Applicant's Email: craig.burns@level3.com/charles@tgainc.net Applicant's Phone Number: 214.435.3298  
 Direct Supervisor's Printed Name: Don Hurla Phone Number: 214.764.2517 Company Name: Level 3 Communications  
 Supervisor's E-Mail: \_\_\_\_\_

FOR ADDISON USE ONLY  
 Received By: Nicole Simpson Entered?  Yes  No Received Date: 2-21-17  
 Approved By: [Signature] Inspector: [Signature] Issue Date: 2/22/17  
 Plans Submitted?  Yes  No  N/A Traffic Control Plan Submitted?  Yes  No  N/A Expiration Date: 3/8/17  
 Insurance Provided?  Yes  No  On File Performance/Maintenance Bond?  Yes  No  On File  N/A  
 Fee Paid: NA Receipt#: CTP Date: 3-05-17 Processed By: Nicole S.  
 Picked Up By: James Scarber Company: Future Telecom Date & Time: 3/3/17 8:08AM

TOWN OF ADDISON INFRASTRUCTURE AND DEVELOPMENT SERVICES  
 DEPARTMENT ATTN.: RIGHT OF WAY PERMIT - DAVE WILDE 972-450-2847  
 16801 WESTGROVE RD. ADDISON, TX 75001-9010  
 PHONE: 972-450-2871 FAX: 972-450-2837

ADDRESS: 14675 DALLAS PARKWAY, ADDISON, TEXAS  
 PROJECT NAME: NXXXXXX

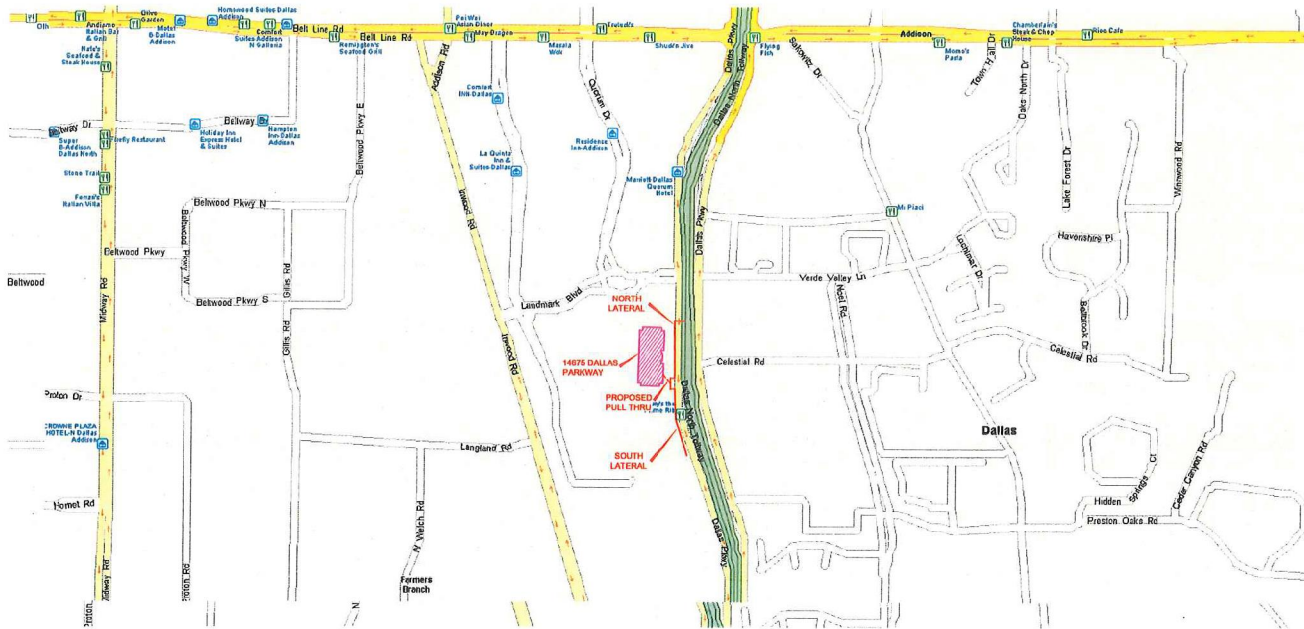

SITE LOCATION

CONTACTS

CONTACT INFO  
 LEVEL(3) COMMUNICATIONS  
 SR. MANAGER, FIELD OPERATIONS  
 1650 NORTH STEMMONS FRWY.  
 SUITE 6060  
 DALLAS, TX 75204  
 DON HURLA  
 OFFICE: (214) 764-2517

OSP ENGINEER:  
 CRAIG BURNS  
 OFFICE: (214) 764-2521  
 CELL: (214) 436-3298

CONSTRUCTION CONTRACTOR:

ENGINEERING CONTRACTOR:  
 TECH GROUP & ASSOCIATES  
 624 WINDBELL CIRCLE,  
 MESQUITE, TX 75149  
 ENGINEERING CONTRACT:  
 CHARLES MARTINEZ  
 OFFICE: (972) 613-8881  
 CELL: (214) 317-5452

UTILITIES:  
 TEXAS ONE CALL SYSTEM  
 1-800-245-4545

CITY OF RICHARDSON  
 OFFICE: (972) 744-4220

SITE INDEX

- 1 - COVER SHEET/SITE LOCATION
- 2 - LEGEND
- 3 - GENERAL NOTES
- (4-6) - PROJECT SHEET
- 7 - RATE CARD TABLES SHEET
- (8-9) - TYPICAL SHEETS

SCOPE OF WORK:

**NORTH LATERAL:**  
 BEGINNING AT EXISTING LEVEL(3) MANHOLE,  
 PULL 48 FIBER CABLE WEST TOWARDS THE  
 END OF THE SIDEWALK, INTERCEPT EXISTING  
 CONDUIT WITH PROPOSED LEVEL(3)  
 HANDHOLE. PLACE 3-1.25" H.D.P.E WITH 48  
 FIBER CABLE SOUTHWARD TO FLOWERBED  
 AREA, INTERCEPT EXISTING CONDUIT WITH  
 48 FIBER CABLE AND BEGIN PULL THRU TO  
 BUILDING.

**SOUTH LATERAL:**  
 BEGINNING AT EXISTING LEVEL(3) HANDHOLE,  
 PULL 48 FIBER CABLE SOUTHWARD TOWARDS  
 EXISTING HANDHOLE. CONNECT AND PLACE  
 3-1.25" H.D.P.E WITH 48 FIBER CABLE  
 NORTHWEST TOWARDS BUILDING, AND  
 INTERCEPT EXISTING CONDUIT WITH 48 FIBER  
 CABLE IN FRONT OF BUILDING AND BEGIN  
 PULL THRU AT THE SAME ENTRY POINT AS  
 NORTH LATERAL.

# SYMBOL CORRESPONDS TO PHOTO LOCATIONS AND ORIENTATION. SEE SHEET # FOR SITE PHOTOGRAPHS.

3			AS-BUILT	
2			REVISION # 1	
1			ORIGINAL	
NO.	DATE	ENG DESIGN	DRAFTING	COMMENT



**Level(3) COMMUNICATIONS**

LEVEL 3 ENGINEER: CRAIG BURNS  
 ENGINEERING FIRM: TECH GROUP  
 PROJECT NUMBER: NXXXXXX  
 LOCATION: 14675 DALLAS PARKWAY  
 ADDISON, TEXAS  
 DRAWING NAME: 16383.dwg

C:\land Projects\WHEED TO SAVE (ANGLE)\16383\_14675 Dallas Pkwy, Addison - Level(3)\16383.dwg, 2/27/2017 10:49:57 AM, IONICIA MORGAN, IONICIA MORGAN, IONICIA MORGAN, IONICIA MORGAN, IONICIA MORGAN

# LEGEND

## LINETYPES

	UG FIBER - EXISTING
	UG FIBER - PROPOSED
	AERIAL FIBER - EXISTING
	AERIAL FIBER - PROPOSED
	STRAND - EXISTING
	STRAND - PROPOSED
	CONDUIT - EXISTING
	CONDUIT - PROPOSED
	INNERDUCT - EXISTING
	INNERDUCT - PROPOSED
	GAS
	WATER
	TELEPHONE
	ELECTRIC
	SANITARY SEWER (SEW)
	STORM DRAIN
	FENCE
	CABLE TV
	STEAM
	OIL
	UNKNOWN UTILITY
	RIGHT OF WAY
	EDGE OF PAVEMENT

## SYMBOL DESCRIPTION

SYMBOL	DESCRIPTION
ASW	ASPHALT SIDEWALK
BIP	BLACK IRON PIPE
BSP	BLACK STEEL PIPE
CSW	CONCRETE SIDEWALK
EOP	EDGE OF PAVEMENT
EOTW	EDGE OF TRAVEL WAY
FOC	FACE OF CURB
HDPE	HIGH DENSITY POLYETHYLENE
HH	HANDHOLE
JB	JUNCTION BOX
MH	MANHOLE
MP	MILE POST
O/S	OFFSET
PVC	POLY VINYL CHLORIDE
RGS	RIGID GALVANIZED STEEL CONDUIT
ROW	RIGHT OF WAY
STA.	STATION

	RISER
	TELEPHONE
	POWER VAULT
	CATCH BASIN/INLET
	FIRE HYDRANT
	GROUND/BOND
	STREET LIGHT
	TREE
	CULVERT
	WING WALL
	BRIDGE
	MISC. UTILITY
	UTILITY POLE - EXISTING
	UTILITY POLE - PROPOSED
	HANDHOLE - EXISTING
	HANDHOLE - PROPOSED
	MANHOLE - EXISTING
	MANHOLE - PROPOSED
	PULLBOX - EXISTING
	PULLBOX - PROPOSED

	VAULT - EXISTING
	VAULT - PROPOSED
	AERIAL STORAGE - EXISTING
	AERIAL STORAGE - PROPOSED
	VAULT/BUILDING STORAGE - EXISTING
	VAULT/BUILDING STORAGE - PROPOSED
	POLE ANCHOR/DOWN GUY - EXISTING
	POLE ANCHOR/DOWN GUY - PROPOSED
	PROPOSED DOWN GUY ON EXISTING ANCHOR
	TERMINATION - EXISTING
	TERMINATION - PROPOSED
	BUILDING CALLOUT - PROPOSED
	SPLICE POINT - EXISTING
	SPLICE POINT - PROPOSED
	SEQUENTIAL CALLOUT
	SEQUENTIAL IN TAIL CALLOUT
	SEQUENTIAL TAIL OUT CALLOUT

POLE NO	N/A
UTILITY1	0'-0"

POLE ATTACHMENT CALLOUT - EXISTING  
USE DYNAMIC PULL DOWN TO SELECT  
FROM 1 TO 6 ATTACHMENTS

POLE NO	N/A
UTILITY1	0'-0"

POLE ATTACHMENT CALLOUT - PROPOSED  
USE DYNAMIC PULL DOWN TO SELECT  
FROM 1 TO 6 ATTACHMENTS

1	CABLE FIBERS: FIBERS CABLE OWNER: LEVEL3 CABLE LENGTH: LENGTH NOTES:
---	---

CABLE SPAN CALLOUT - EXISTING  
FOR USE ON PAPER SPACE (SHOWN AT 50X)

1	CABLE FIBERS: FIBERS CABLE OWNER: LEVEL3 CABLE LENGTH: LENGTH NOTES:
---	---

CABLE SPAN CALLOUT - PROPOSED  
FOR USE ON PAPER SPACE (SHOWN AT 50X)

1	CONDUIT OWNER: LEVEL3 CONDUIT LENGTH: LENGTH CONDUIT QTY: CONDUITS CONDUIT SIZE: SIZE CONDUIT TYPE: TYPE INNER DUCT QTY: INNERDUCTS INNER DUCT SIZE: SIZE INNER DUCT TYPE: TYPE NOTES:
---	--

CONDUIT CALLOUT - EXISTING  
FOR USE ON PAPER SPACE (SHOWN AT 50X)  
WITH OR WITHOUT INNER DUCT INFO

1	CONDUIT OWNER: LEVEL3 CONDUIT LENGTH: LENGTH CONDUIT QTY: CONDUITS CONDUIT SIZE: SIZE CONDUIT TYPE: TYPE INNER DUCT QTY: INNERDUCTS INNER DUCT SIZE: SIZE INNER DUCT TYPE: TYPE NOTES:
---	--

CONDUIT CALLOUT - PROPOSED  
FOR USE ON PAPER SPACE (SHOWN AT 50X)  
WITH OR WITHOUT INNER DUCT INFO

1	STRAND TYPE: TYPE STRAND LENGTH: LENGTH NOTES:
---	--

STRAND CALLOUT - EXISTING  
FOR USE ON PAPER SPACE (SHOWN AT 50X)

1	STRAND TYPE: TYPE STRAND LENGTH: LENGTH NOTES:
---	--

STRAND CALLOUT - PROPOSED  
FOR USE ON PAPER SPACE (SHOWN AT 50X)

SYMBOL CORRESPONDS TO PHOTO LOCATIONS AND ORIENTATION. SEE SHEET # FOR SITE PHOTOGRAPHS.



NO.	DATE	ENG	DESIGN	DRAFTING	COMMENT
3					AS-BUILT
2					REVISION # 1
1					ORIGINAL

**Level(3)**  
COMMUNICATIONS

LEVEL 3 ENGINEER: CRAIG BURNS  
ENGINEERING FIRM: TECH GROUP  
PROJECT NUMBER: NXXXXXX  
LOCATION: 14675 DALLAS PARKWAY  
ADDISON, TEXAS  
DRAWING NAME: 16393.dwg

CONFIDENTIAL/PROPRIETARY SHEET: 2 OF 10



# GENERAL NOTES

1. Contractor must obtain locates prior to disturbing the ground.
2. Contractor must have a copy of the approved permit from the appropriate agency on the jobsite at all times.
3. All cable will be placed at standard minimum depth. (Level 3 standard is 36" deep unless otherwise directed by a Level 3 representative.)
4. Any landscaping will be replaced to equal or better than that which existed prior to work.
5. Project site will be properly secured prior to the end of each day.
6. All work is to be in accordance with all authorities having jurisdiction in the work zone.
7. Contractors are advised to contact Level 3 for any additional information or clarification concerning scope of work or the requirements necessary for project completion.
8. Contractor is responsible to field verify all dimensions, quantities and existing conditions prior to construction. If a significant change to the running line is needed, please contact your Level 3 representative before proceeding.
9. Before construction begins, contractor shall take appropriate precautions to avoid any potential obstructions prior to proceeding with work.
10. No construction on private property will commence until approval is given by the appropriate Level 3 employee.
11. Contractor shall not proceed with work until they have received a Purchase Order and have been directed to do so by an authorized Level 3 representative.
12. Contractor shall not exceed the Purchase Order value without authorization in writing from the appropriate Level 3 representative.
13. As-Builts will be required for each project including cable footage sequentials at every access point, slack loop, splice location, pole and termination point. Contractor should also provide notes of all changes in depths, running lines, mh/hh locations, and any other applicable notes to depict the work that took place. NOTE: All major changes need to be pre-approved by an authorized Level 3 employee prior to starting the work.
- 14.



# SYMBOL CORRESPONDS TO PHOTO LOCATIONS AND ORIENTATION. SEE SHEET # FOR SITE PHOTOGRAPHS.

3				AS-BUILT
2				REVISION # 1
1				ORIGINAL
NO.	DATE	ENG DESIGN	DRAFTING	COMMENT
<b>Level (3)</b> COMMUNICATIONS				
LEVEL 3 ENGINEER: CRAIG BURNS				
ENGINEERING FIRM: TECH GROUP				
PROJECT NUMBER: NXXXXX				
LOCATION: 14676 DALLAS PARKWAY ADDISON, TEXAS				
DRAWING NAME: 16383.dwg				
CONFIDENTIAL/PROPRIETARY				SHEET: 3 OF 10

DALLAS NORTH TOLLWAY

715' TO QUORUM DRIVE

(RAMP)

DALLAS PARKWAY (SERVICE ROAD)

BUILDING  
CUSTOMER  
14675 DALLAS PARKWAY

STA 4+42  
BUILDING ENTRY

SEE SOUTH LATERAL  
FOR CONTINUATION

CONSTRUCTION NOTES

- 1 EXISTING LEVEL(3) MANHOLE  
INCLUDE 100' SLACK COIL
- 2 CABLE FIBERS: 1-48  
CABLE OWNER: LEVEL(3)  
CABLE LENGTH: 130'  
NOTES: INCLUDES SLACK
- 3 CONTRACTOR TO LOCATE AND  
INTERCEPT EXISTING CONDUIT  
WITH PROPOSED LEVEL 3 HANDHOLE
- 4 CONDUIT OWNER: LEVEL(3)  
CONDUIT LENGTH: 330'  
CONDUIT CITY: 3  
CONDUIT SIZE: 1.25"  
CONDUIT TYPE: H.D.P.E.  
NOTES:
- 5 CABLE FIBERS: 1-48  
CABLE OWNER: LEVEL(3)  
CABLE LENGTH: 330'  
NOTES:
- 6 CONTRACTOR TO LOCATE AND  
INTERCEPT EXISTING LEVEL3  
CONDUIT WITH 48 FIBER CABLE
- 7 CABLE FIBERS: 1-48  
CABLE OWNER: LEVEL(3)  
CABLE LENGTH: 82'  
NOTES:

# SYMBOL CORRESPONDS TO PHOTO LOCATIONS AND ORIENTATION. SEE SHEET # FOR SITE PHOTOGRAPHIC.

3			AS-BUILT
2			REVISION # 1
1			ORIGINAL
NO.	DATE	ENG DESIGN	DRAFTING COMMENT

**Level(3)**  
COMMUNICATIONS

LEVEL 3 ENGINEER: CRAIG BURNS  
ENGINEERING FIRM: TECH GROUP  
PROJECT NUMBER: NXXXXXX  
LOCATION: 14675 DALLAS PARKWAY  
ADDISON, TEXAS  
DRAWING NAME: 16393.dwg

CONFIDENTIAL/PROPRIETARY

SHEET: 4 OF 10

Page Rate Card

Unit Code & Description	Units	Estimated Quantity	Actual Quantity
UGB-30960 - Place up to 288 count FOC in conduit, up to 1500'	FOOT	30	
UGB-31280 - Place New - 30"x60"x36" - Non-concrete Manhole / Handhole	EACH	1	
UGB-30020 - Trench up to 1500'; Trench 48" minimum cover	FOOT	330	
UGB-30080 - Trench Rock ADDER	FOOT	330	
UGB-30160 - Place 3 - HDPE conduits in open trench up to 2" (on one reel)	FOOT	330	
UGB-30820 - Rod & Proof Existing Conduit	FOOT	330	
UGB-30830 - Place Locate Wire in Existing Conduit	FOOT	330	
UGB-30940-C Intercept Conduit: Wye Cast 4" - CBD	EACH	1	
UGB-30960 - Place up to 288 count FOC in conduit, up to 1500'	FOOT	212	

NOTE  
UTILITY & R.O.W. REPRESENTED ON  
PLANS ARE BASED ON RECORDS  
NOT ON BOUNDARY SURVEY  
& FIELD EXPOSURES

CAUTION:  
CONTRACTOR TO LOCATE &  
VERIFY ALL EXISTING UTILITIES  
PRIOR TO CONSTRUCTION

**811**  
Know what's below.  
Call before you dig.

C:\Land Projects\NEED TO SAVE (ANGEL)\16393\_L167675 Dallas Hwy, Addison - Level3\16393.dwg, 7/20/2017 11:09:13 AM, KDNCA\NINOLA\_C36064645\_Scheldt\_Guerra

DALLAS NORTH TOLLWAY

DALLAS PARKWAY (SERVICE ROAD)

MATCH TO SHEET 6

(RAMP)

48F IN:  
OUT:

100

CONSTRUCTION NOTES

- 1 EXISTING LEVEL(3) MANHOLE  
INCLUDE 100' SLACK COIL
- 2 CABLE FIBERS: 1-48  
CABLE OWNER: LEVEL(3)  
CABLE LENGTH: 130'  
NOTES: INCLUDES SLACK
- 3 CONTRACTOR TO LOCATE AND CONNECT  
TO EXISTING LEVEL(3) HANDHOLE  
INCLUDE 100' SLACK COIL
- 4 CONDUIT OWNER: LEVEL(3)  
CONDUIT LENGTH: 400'  
CONDUIT QTY: 3  
CONDUIT SIZE: 1.25"  
CONDUIT TYPE: H.D.P.E.  
NOTES:
- 5 CABLE FIBERS: 1-48  
CABLE OWNER: LEVEL(3)  
CABLE LENGTH: 400  
NOTES:

# SYMBOL CORRESPONDS TO PHOTO LOCATIONS AND ORIENTATION. SEE SHEET # FOR SITE PHOTOGRAPHS.

3			AS-BUILT
2			REVISION # 1
1			ORIGINAL
NO.	DATE	ENG DESIGN	DRAFTING
			COMMENT



LEVEL 3 ENGINEER: CRAIG BURNS  
ENGINEERING FIRM: TECH GROUP  
PROJECT NUMBER: NXXXXXX  
LOCATION: 14875 DALLAS PARKWAY  
ADDISON, TEXAS  
DRAWING NAME: 16393.dwg  
CONFIDENTIAL/PROPRIETARY SHEET: 6 OF 10



**NOTE**  
UTILITY & ROW REPRESENTED ON  
PLANS ARE BASED ON RECORDS  
NOT ON BOUNDARY SURVEY  
& FIELD EXPOSURES

**CAUTION:**  
CONTRACTOR TO LOCATE &  
VERIFY ALL EXISTING UTILITIES  
PRIOR TO CONSTRUCTION

Page Rate Card

Unit Code & Description	Units	Estimated Quantity	Actual Quantity
UGB-30980 - Place up to 288 count FOC in conduit, up to 1500'	FOOT	130	
UGB-30020 - Trench up to 1500'; Trench 48" minimum cover	FOOT	400	
UGB-30080 - Trench Rock ADDER	FOOT	400	
UGB-30180 - Place 3 - HDPE conduits in open trench up to 2" (on one reel)	FOOT	400	
UGB-30820 - Rod & Proof Existing Conduit	FOOT	400	
UGB-30830 - Place Locate Wire in Existing Conduit	FOOT	400	



DALLAS PARKWAY

(RAMP)

DALLAS PARKWAY  
(SERVICE ROAD)

MATCH TO SHEET 5

SEE NORTH LATERAL  
FOR CONTINUATION

STA 7+64  
BUILDING ENTRY

BUILDING  
CUSTOMER  
14675 DALLAS PARKWAY

Page Rate Card

Unit Code & Description	Units	Estimated Quantity	Actual Quantity
UGB-30020 - Trench up to 1500'; Trench 48" minimum cover	FOOT	282	
UGB-30080 - Trench Rock ADDER	FOOT	282	
UGB-30160 - Place 3 - HDPE conduits in open trench up to 2" (on one reel)	FOOT	282	
UGB-30820 - Rod & Proof Existing Conduit	FOOT	282	
UGB-30830 - Place Locate Wire in Existing Conduit	FOOT	282	
UGB-30940-C Intercept Conduit: Wye Cast 4" - CBD	EACH	1	
UGB-30960 - Place up to 288 count FOC in conduit, up to 1500'	FOOT	82	

NOTE


UTILITY & R.O.W. REPRESENTED ON  
PLANS ARE BASED ON RECORDS  
NOT ON BOUNDARY SURVEY  
& FIELD EXPOSURES

CAUTION:

CONTRACTOR TO LOCATE &  
VERIFY ALL EXISTING UTILITIES  
PRIOR TO CONSTRUCTION

811

Know what's below.  
Call before you dig.

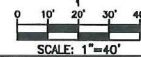

SCALE: 1"=40'

CONSTRUCTION NOTES

- 1 CONDUIT OWNER: LEVEL(3)  
CONDUIT LENGTH: 282'  
CONDUIT QTY: 3  
CONDUIT SIZE: 1.25"  
CONDUIT TYPE: H.D.P.E.  
NOTES:
- 2 CABLE FIBERS: 1-48  
CABLE OWNER: LEVEL(3)  
CABLE LENGTH: 282'  
NOTES:
- 3 CONTRACTOR TO LOCATE AND  
INTERCEPT EXISTING LEVEL 3  
CONDUIT WITH 48 FIBER CABLE
- 4 CABLE FIBERS: 1-48  
CABLE OWNER: LEVEL(3)  
CABLE LENGTH: 82'  
NOTES:

# SYMBOL CORRESPONDS TO PHOTO LOCATIONS AND ORIENTATION. SEE SHEET # FOR SITE PHOTOGRAPHS.

NO.	DATE	ENG DESIGN	DRAFTING	COMMENT
3				AS-BUILT
2				REVISION # 1
1				ORIGINAL

**Level(3)**  
COMMUNICATIONS

LEVEL 3 ENGINEER: CRAIG BURNS  
ENGINEERING FIRM: TECH GROUP  
PROJECT NUMBER: NXXXXXX  
LOCATION: 14675 DALLAS PARKWAY  
ADDISON, TEXAS

DRAWING NAME: 16993.dwg

CONFIDENTIAL/PROPRIETARY

SHEET 6 OF 10

Total Underground Rate Card			
Unit Code & Description	Units	Estimated Quantity	Actual Quantity
UCB-30020 - Trench up to 1500': Trench 48" minimum cover	FOOT	1,012	
UCB-30080 - Trench Rock ADDER	FOOT	1,012	
UCB-30160 - Place 3 - HDPE conduits in open trench up to 2" (on one reel)	FOOT	1,012	
UCB-30820 - Rod & Proof Existing Conduit	FOOT	1,012	
UCB-30830 - Place Locote Wire in Existing Conduit	FOOT	1,012	
UCB-30940-C Intercept Conduit: Wye Cast 4" - CBD	EACH	2	
UCB-30960 - Place up to 288 count FOC in conduit, up to 1500'	FOOT	424	
UCB-31280 - Place New - 30"x60"x36" - Non-concrete Manhole / Handhole	EACH	1	

Total Inside Plant (ISP) Rate Card			
Unit Code & Description	Units	Estimated Quantity	Actual Quantity
ISP-40170 - Risers and Runs: Place 1.25" Plenum innerduct	FT	95'	
ISP-40660 - Place Fiber Cable in innerduct	FT	145'	

Total Material Rate Card			
Unit Code & Description	Units	Estimated Quantity	Actual Quantity
UCB-30020 - Trench up to 1500': Trench 48" minimum cover	FOOT	1,012	
UCB-30080 - Trench Rock ADDER	FOOT	1,012	
UCB-30160 - Place 3 - HDPE conduits in open trench up to 2" (on one reel)	FOOT	1,012	
UCB-30820 - Rod & Proof Existing Conduit	FOOT	1,012	
UCB-30830 - Place Locote Wire in Existing Conduit	FOOT	1,012	
UCB-30940-C Intercept Conduit: Wye Cast 4" - CBD	EACH	2	
UCB-30960 - Place up to 288 count FOC in conduit, up to 1500'	FOOT	424	
UCB-31280 - Place New - 30"x60"x36" - Non-concrete Manhole / Handhole	EACH	1	
ISP-40170 - Risers and Runs: Place 1.25" Plenum innerduct	FT	95'	
ISP-40660 - Place Fiber Cable in innerduct	FT	145'	




Know what's below.  
Call before you dig.


3				AS-BUILT
2				REVISION # 1
1				ORIGINAL
NO.	DATE	ENG DESIGN	DRAFTING	COMMENT
LEVEL 3 ENGINEER: CRAIG BURNS				
ENGINEERING FIRM: TECH GROUP				
PROJECT NUMBER: NXXXXX				
LOCATION: 14675 DALLAS PARKWAY ADDISON, TEXAS				
DRAWING NAME: 16193.dwg				
CONFIDENTIAL/PROPRIETARY				
				SHEET: 8 OF 10




# TYPICALS

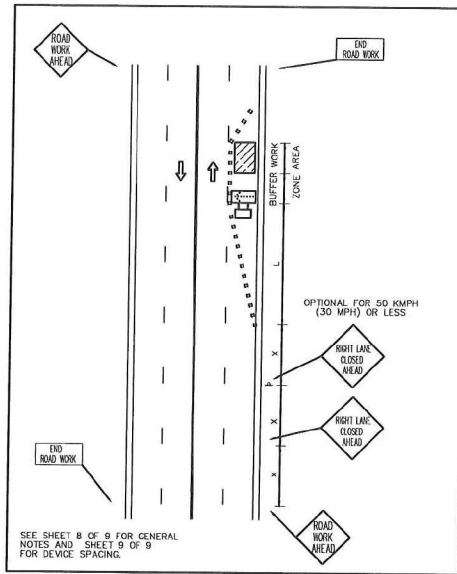

**ARTERIAL ONE LANE CLOSURE**

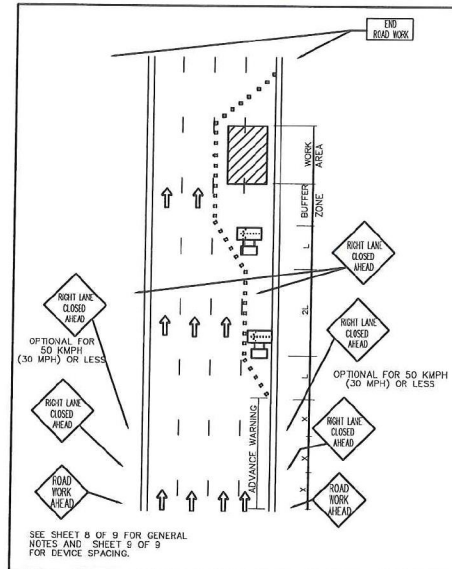


**ONE WAY ARTERIAL TWO-LANE CLOSURE**

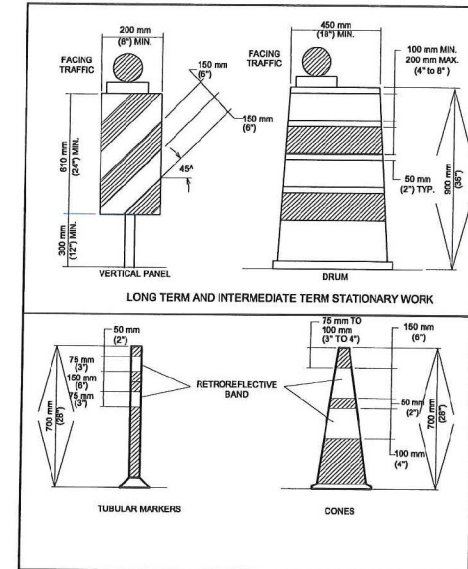

**CHANNELIZING DEVICES**

Typical Transition Lengths and Suggested Maximum Spacing of Devices

Speed KM/PH	Posted Speed MPH	Formula	Minimum Disturbance Taper Lengths (L)			Suggested Max. Device Spacing		Suggested Max. Sign Spacing Meters (Feet)
			Offset Meters (feet)	Offset Meters (feet)	Offset Meters (feet)	On a taper Meters (feet)	On a tangent Meters (feet)	
50	30	L = WS <sup>2</sup> 63	45 (150)	56 (185)	55 (180)	9 (30)	15-20 (50-75)	40 (120)
55	35		65 (205)	70 (225)	75 (245)	10 (35)	25-25 (70-90)	50 (160)
65	40		80 (265)	90 (295)	100 (320)	12 (40)	25-30 (80-100)	75 (240)
70	45	L = WS	135 (450)	150 (495)	165 (540)	13 (45)	25-30 (80-110)	100 (320)
80	50		150 (500)	165 (550)	180 (600)	15 (50)	30-35 (100-125)	120 (400)
90	55		165 (550)	185 (605)	200 (660)	16 (55)	35-40 (110-140)	150 (500)
95	60	L = WS	180 (600)	200 (660)	220 (720)	18 (60)	40-45 (120-150)	180 (600)
105	65		195 (650)	215 (715)	235 (780)	19 (65)	40-50 (130-165)	210 (700)
115	70		215 (705)	235 (770)	255 (840)	21 (70)	45-55 (140-175)	240 (800)

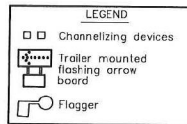

1. THESE CORRESPOND TO PHOTO LOCATIONS AND ORIENTATION. SEE SHEET # FOR SITE PHOTOGRAPHS.






NO.	DATE	ENG DESIGN	DRAFTING	COMMENT
3				AS-BUILT
2				REVISION # 1
1				ORIGINAL

**Level(3)**  
COMMUNICATIONS

LEVEL 3 ENGINEER: CRAIG BURNS  
ENGINEERING FIRM: TECH GROUP  
PROJECT NUMBER: N00XXXX  
LOCATION: 14675 DALLAS PARKWAY  
ADDISON, TEXAS  
DRAWING NAME: 16193.dwg  
CONFIDENTIAL/PROPRIETARY

# TYPICALS

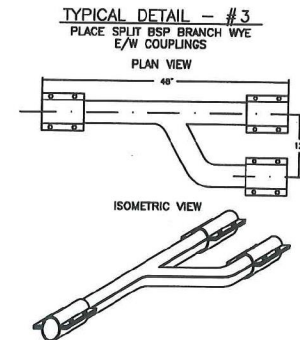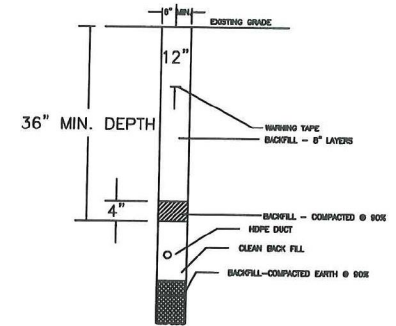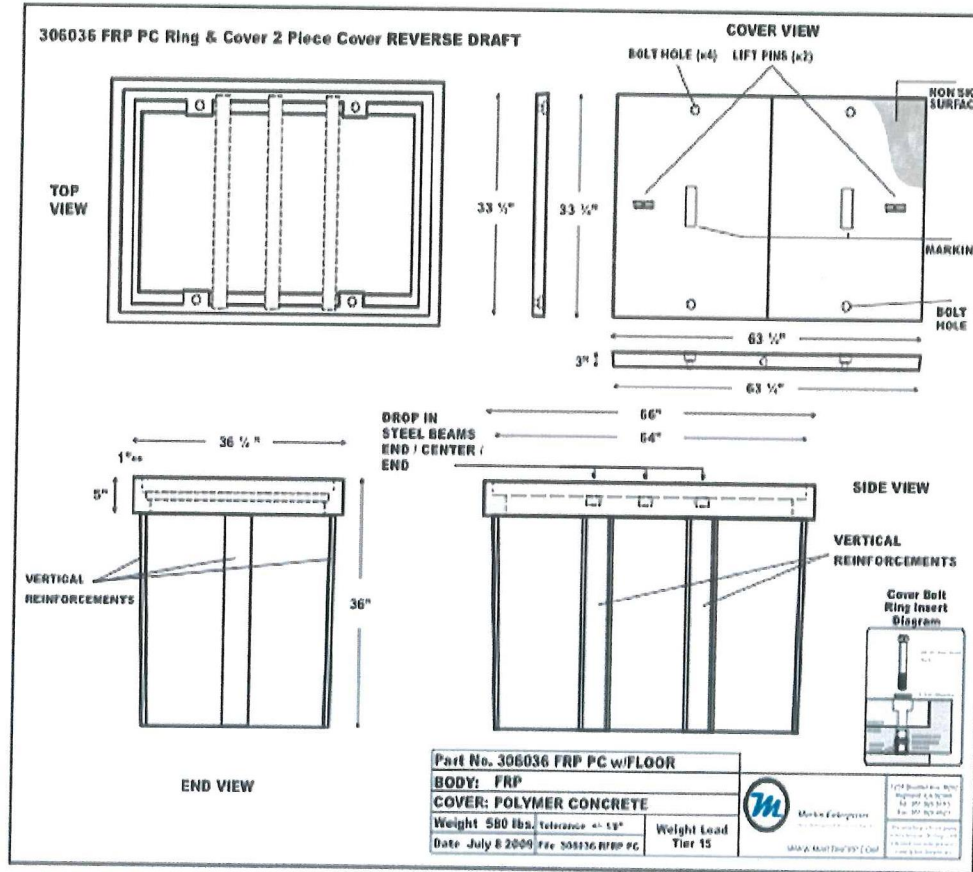

1 SYMBOL CORRESPONDS TO PHOTO LOCATIONS AND ORIENTATION. SEE SHEET # FOR SITE PHOTOGRAPHS.



3				AS-BUILT
2				REVISION # 1
1				ORIGINAL
NO.	DATE	ENG DESIGN	DRAFTING	COMMENT
<b>Level(3)</b> COMMUNICATIONS				
LEVEL 3 ENGINEER: CRAIG BURNS				
ENGINEERING FIRM: TECH GROUP				
PROJECT NUMBER: NXXXXXX				
LOCATION: 14675 DALLAS PARKWAY ADDISON, TEXAS				
DRAWING NAME: 16303.dwg				
CONFIDENTIAL/PROPRIETARY				