



FOR ADDISON USE ONLY
 Permit Number: W-1065
 Location: 16400 Ledgeмонт

APPLICATION

Right of Way Work Permit -FRANCHISE

(For Franchise Utility/CTP - Street Cut/Excavation/Lane Closure)

PLEASE PRINT LEGIBLY

Date of Application: 2-14-17

Facility Owner Company: Spectrum Company Phone #: _____

Utility/CTP Representative: Johana Delena Cell Phone #: 214-501-4300

Utility/CTP Representative E-Mail: _____

General Contractor: Beyond Broadband Solutions Company Phone #: 214-501-4300

Site Supervisor Name: Jovany Vazquez 24-hour phone #: 214-773-1054

Contractor E-Mail address: He@Beyondbroadbands.com Site Foreman E-Mail: _____

Work Site Address and Location: 16400 Ledgeмонт Ln Apt # 606, Addison, 75001

Purpose and general description of work: 45ft bury trench, SW-bore 4ft.

Proposed Start Work Date: 2-15-17 Estimated Completion Date: 2-20-17

Pavement Cut? Yes No Directional Bore/Boring? Yes No SW-Bore

Excavation? Yes No Lane Closure? Yes No Other: 4ft. ? Yes No

Applicant's Printed Name: Jovany Vazquez Signature: _____ Position with Company: Supervisor.

Applicant's Email: jovany.vazquez@beyondbroadbands.com Applicant's Phone Number: 214-773-1054

Direct Supervisor's Printed Name: Edgar Monge Phone Number: 214-243-3162 Company Name: BBS

Supervisor's E-Mail: emonge@bbs.com

FOR ADDISON USE ONLY

Received By: Nicole Simpson Entered? Yes No Received Date: 2-14-17

Approved By: [Signature] Inspector: JE Issue Date: 2/15/17

Plans Submitted? Yes No N/A Traffic Control Plan Submitted? Yes No N/A Expiration Date: 3/1/17



Insurance Provided? Yes No On File Performance/Maintenance Bond? Yes No On File N/A

Fee Paid: NA Receipt#: CTP Date: 2-16-17 Processed By: Nicole S.

Picked Up By: Jordan Company: Beyond Broad Date & Time: 2-16-17

TOWN OF ADDISON INFRASTRUCTURE AND DEVELOPMENT SERVICES
 DEPARTMENT ATTN.: RIGHT OF WAY PERMIT - DAVE WILDE 972-450-2847
 16801 WESTGROVE RD. ADDISON, TX 75001-9010
 PHONE: 972-450-2871 FAX: 972-450-2837

1:35PM

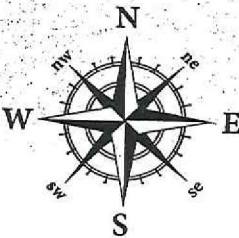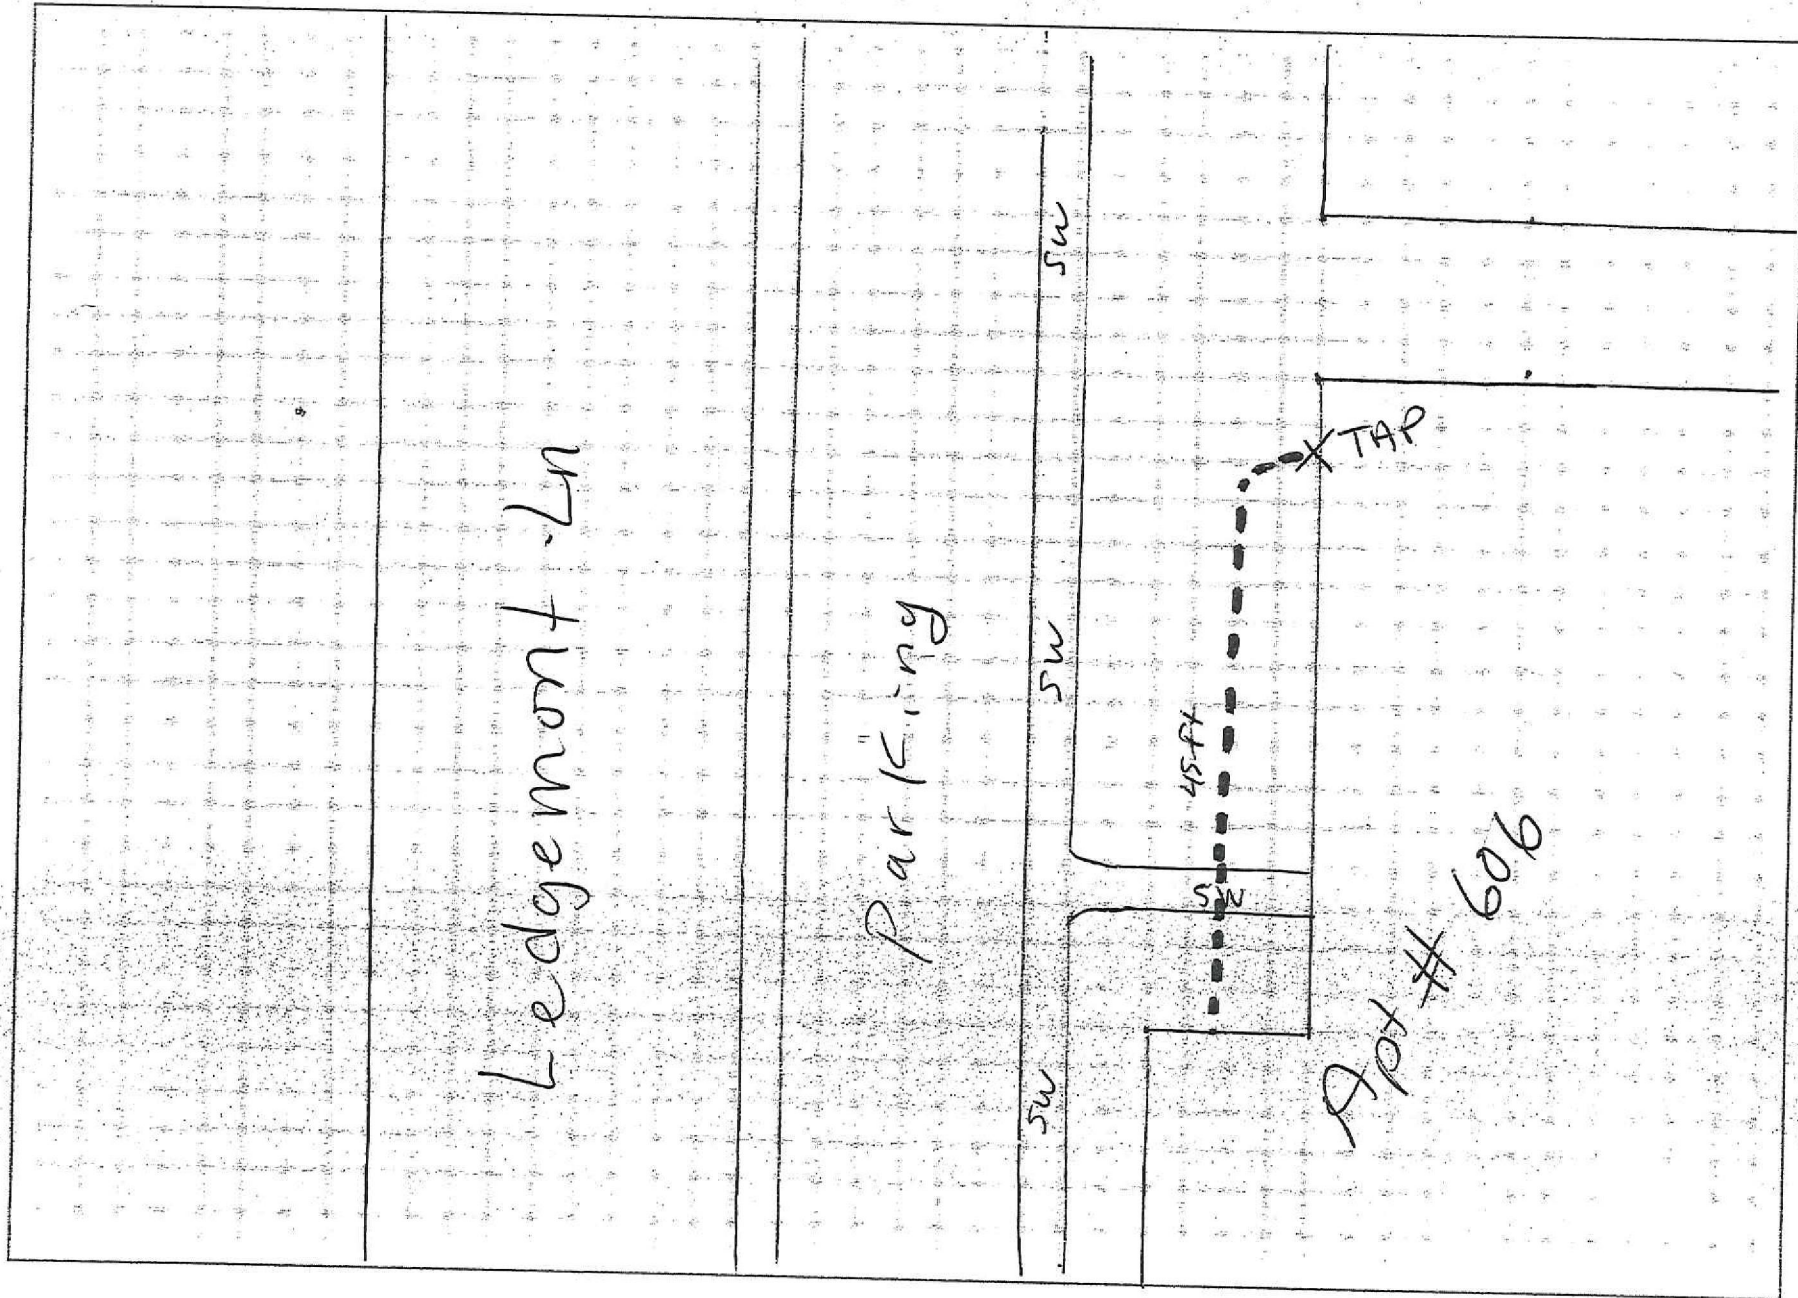

STREET NAME: 16400 Ledgemont Ln #606 CITY: Addison ZIP: 75001