



FOR ADDISON USE ONLY
 Permit Number: W-1079
 Location: 4451 Belt Line Rd.

APPLICATION

Right of Way Work Permit - PUBLIC UTILITY/CTP
 (For Public Utility/CTP - Street Cut/Excavation/Lane Closure)

PLEASE PRINT LEGIBLY

Date of application: 3/6/17

Facility Owner Company: _____ Company Phone #: _____
 Utility/CTP Representative: Atmos / Johnny Cell Phone #: 409.340.9301
 General Contractor: Boardwalk paving Company Phone #: 972.804.9965
 Site Supervisor Name: CT 24 hour phone #: 214-837-3375

Work Site Address and Location: 4451 Belt Line Rd.
 Purpose and general description of work: Micro hole repair - Atmos
 Proposed Start Work Date: 3-9-17 Estimated Completion Date: 3-13-17

Pavement Cut? Yes No Directional Bore/Boring? Yes No
 Excavation? Yes No Lane Closure? Yes No Other: _____ ? Yes No

Applicant's Printed Name: Stephanie Sytek Signature: [Signature] Position with Company: Ops Mgr.

Applicant's Email: Stephanie@boardwalkpaving.com Applicant's Phone Number: 972.804.9965

Direct Supervisor's Printed Name: _____ Phone Number: _____ Company Name: _____

FOR ADDISON USE ONLY

Received By: DW via Email Entered? Yes Received Date: 3/6/17 2:14 PM

Approved By: [Signature] Inspector: JF Issue Date: 3/7/17

Plans Submitted? Yes No N/A Traffic Control Plan Submitted? Yes No N/A Expiration Date: 3/21/17

Insurance Provided? Yes No On File Performance/Maintenance Bond? Yes No On File N/A

Fee Paid: NA Receipt#: FRANCHISE Date: 3-07-17 Processed By: Nicole S.

Picked Up By: Mike Company: Boardwalk Date & Time: 3-07-17 11:31 AM

TOWN OF ADDISON INFRASTRUCTURE AND DEVELOPMENT SERVICES
 DEPARTMENT ATTN.: RIGHT OF WAY PERMIT - DAVE WILDE 972-450-2847
 16801 WESTGROVE RD. ADDISON, TX 75001-9010
 PHONE: 972-450-2871 FAX: 972-450-2837

Pavement & Sidewalk Repair Order

080.52260

3rd Party Damage

Yes No

Permit Required

Yes No

Leak #

Cast Iron

Poly

Coated St

Bare St

Addison Twp		14C	4451 Beltline Rd				
	Project #	Task #	Ser Area	Co	CC	Acct	Sub
CAPITAL	<input type="checkbox"/> 5' to 99' Main Replacements		190000	080			
	<input type="checkbox"/> Repl. Service Lines		190000	080			
	<input type="checkbox"/> Install Service Lines		190000	080			
	<input type="checkbox"/> Permanent Leak Repairs		190000	080			
	<input type="checkbox"/> C/P Remediation (Distrib)		190000	080			
	<input type="checkbox"/> Retire Service Lines		190000	080			
	<input type="checkbox"/> C/P Remediation (Pipeline)		700000	080			
<input checked="" type="checkbox"/>	Project Number 080.52260						
O&M	<input type="checkbox"/> Other Maintenance - Distribution		190000	080		8870	06111
	<input type="checkbox"/> Maintenance of Mains		190000	080		8870	06111
	<input type="checkbox"/> Reg / Relief / Other work (Distrib)		190000	080		8890	06111
	<input type="checkbox"/> Other Maintenance - Pipeline		190000	080		8630	06111
	<input type="checkbox"/> Leak Repair on Pipeline Mains		190000	080		8630	06111


Description of Work Performed: Core hole

Cut Made By: Lacroix
Atmos Supervisor/FCC: Johnny Gonzalez

Description of Pavement or Sidewalk Cut	Concrete	Asphalt	Length & Width of Cut	Street	Alley	Sidewalk
Cut 1	<input checked="" type="checkbox"/>	<input type="checkbox"/>	Core hole	<input checked="" type="checkbox"/>		<input type="checkbox"/>
Cut 2	<input type="checkbox"/>	<input type="checkbox"/>		<input type="checkbox"/>	<input type="checkbox"/>	<input type="checkbox"/>
Curb Cut	<input type="checkbox"/>	<input checked="" type="checkbox"/>				

Description and Cost of Repairs	Concrete	Asphalt	Length & Width of Repair	Cost Per Ft or Sq Ft	Total Cost Per Cut
Cut 1	<input type="checkbox"/>	<input type="checkbox"/>			
Cut 2	<input type="checkbox"/>	<input type="checkbox"/>			
Curb Cut	<input type="checkbox"/>	<input checked="" type="checkbox"/>			

4451

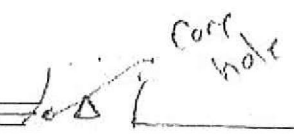

Draw a sketch of cut location.



Beltline Rd