

FOR ADDISON USE ONLY
 Permit Number: W-1132
 Location: 16390 Addison Rd

APPLICATION

Right of Way Work Permit -FRANCHISE

(For Franchise Utility/CTP - Street Cut/Excavation/Lane Closure)

PLEASE PRINT LEGIBLY

Date of Application: 5-8-17
 Facility Owner Company: Spectrum Company Phone #: ron.quest@charter.com
 Utility/CTP Representative: Ron Quest Cell Phone #: _____
 Utility/CTP Representative E-Mail: _____
 General Contractor: Beyond Broadband Solutions Company Phone #: 214-501-4300
 Site Supervisor Name: Jovany Vazquez 24-hour phone #: 214-773-1054
 Contractor E-Mail address: jvazquez@beyondbroadbands.com Site Foreman E-Mail: 11
 Work Site Address and Location: 16390 Addison Rd, Addison 75001
 Purpose and general description of work: 10ft bury trench, 6" deep
 Proposed Start Work Date: 5-8-17 Estimated Completion Date: 5-18-17
 Pavement Cut? Yes No Directional Bore/Boring? Yes No
 Excavation? Yes No Lane Closure? Yes No Other: _____ ? Yes No
 Applicant's Printed Name: Jovany Vazquez Signature: [Signature] Position with Company: Supervisor
 Applicant's Email: jvazquez@beyondbroadbands.com Applicant's Phone Number: 214-773-1054
 Direct Supervisor's Printed Name: Edgar Monge Phone Number: 214-243-3162 Company Name: Beyond Broadband Solutions
 Supervisor's E-Mail: emonge@beyondbroadbands.com

FOR ADDISON USE ONLY

Received By: Micole S. Entered? Yes Received Date: 5-8-17
 Approved By: [Signature] Inspector: JF Issue Date: 5/14/17
 Plans Submitted? Yes No N/A Traffic Control Plan Submitted? Yes No N/A Expiration Date: 5/24/17
 Insurance Provided? Yes No On File Performance/Maintenance Bond? Yes No On File N/A
 Fee Paid: NA Receipt#: CTP Date: 5-12-17 Processed By: Micole S.
 Picked Up By: JAWN Company: BBS Date & Time: 5-12-17 4:24 PM

TOWN OF ADDISON INFRASTRUCTURE AND DEVELOPMENT SERVICES
 DEPARTMENT ATTN.: RIGHT OF WAY PERMIT - DAVE WILDE 972-450-2847
 16801 WESTGROVE RD. ADDISON, TX 75001-9010
 PHONE: 972-450-2871 FAX: 972-450-2837



FOR ADDISON USE ONLY

Permit Number: W-1132

Location: 16390 Addison Rd

APPLICATION
Right of Way Work Permit -FRANCHISE
 (For Franchise Utility/CTP - Street Cut/Excavation/Lane Closure)

Sub-Contractor List

PLEASE PRINT LEGIBLY

General Contractor's Name: Beyond Broadband Solutions. **General Contractor's Phone #:** 214-507-4300

Sub-Contractor #1 Company Name: _____ Address: _____

Print Sub-Contractor's Name: _____ **Sub-Contractor's Phone #:** _____

Sub-Contractor's E-Mail: _____

Print Site Supervisor's Name: _____ Supervisor's Phone #: _____

Site Supervisor's E-Mail: _____

Insurance Provided? Yes No On File

Sub-Contractor #2 Company Name: _____ Address: _____

Print Sub-Contractor's Name: _____ Sub-Contractor's Phone #: _____

Sub-Contractor's E-Mail: _____

Print Supervisor's Name: _____ Supervisor's Phone #: _____

Site Supervisor's E-Mail: _____

Insurance Provided? Yes No On File

Sub-Contractor #3 Company Name: _____ Address: _____

Print Sub-Contractor's Name: _____ Sub-Contractor's Phone #: _____

Sub-Contractor's E-Mail: _____


Print Supervisor's Name: _____ Supervisor's Phone #: _____

Site Supervisor's E-Mail: _____

Insurance Provided? Yes No On File

TOWN OF ADDISON INFRASTRUCTURE AND DEVELOPMENT SERVICES
 DEPARTMENT ATTN.: RIGHT OF WAY PERMIT - DAVE WILDE 972-450-2847
 16801 WESTGROVE RD. ADDISON, TX 75001-9010
 PHONE: 972-450-2871 FAX: 972-450-2837

BEYOND BROADBAND SOLUTIONS INC.
OFFICE- 214-501-4300

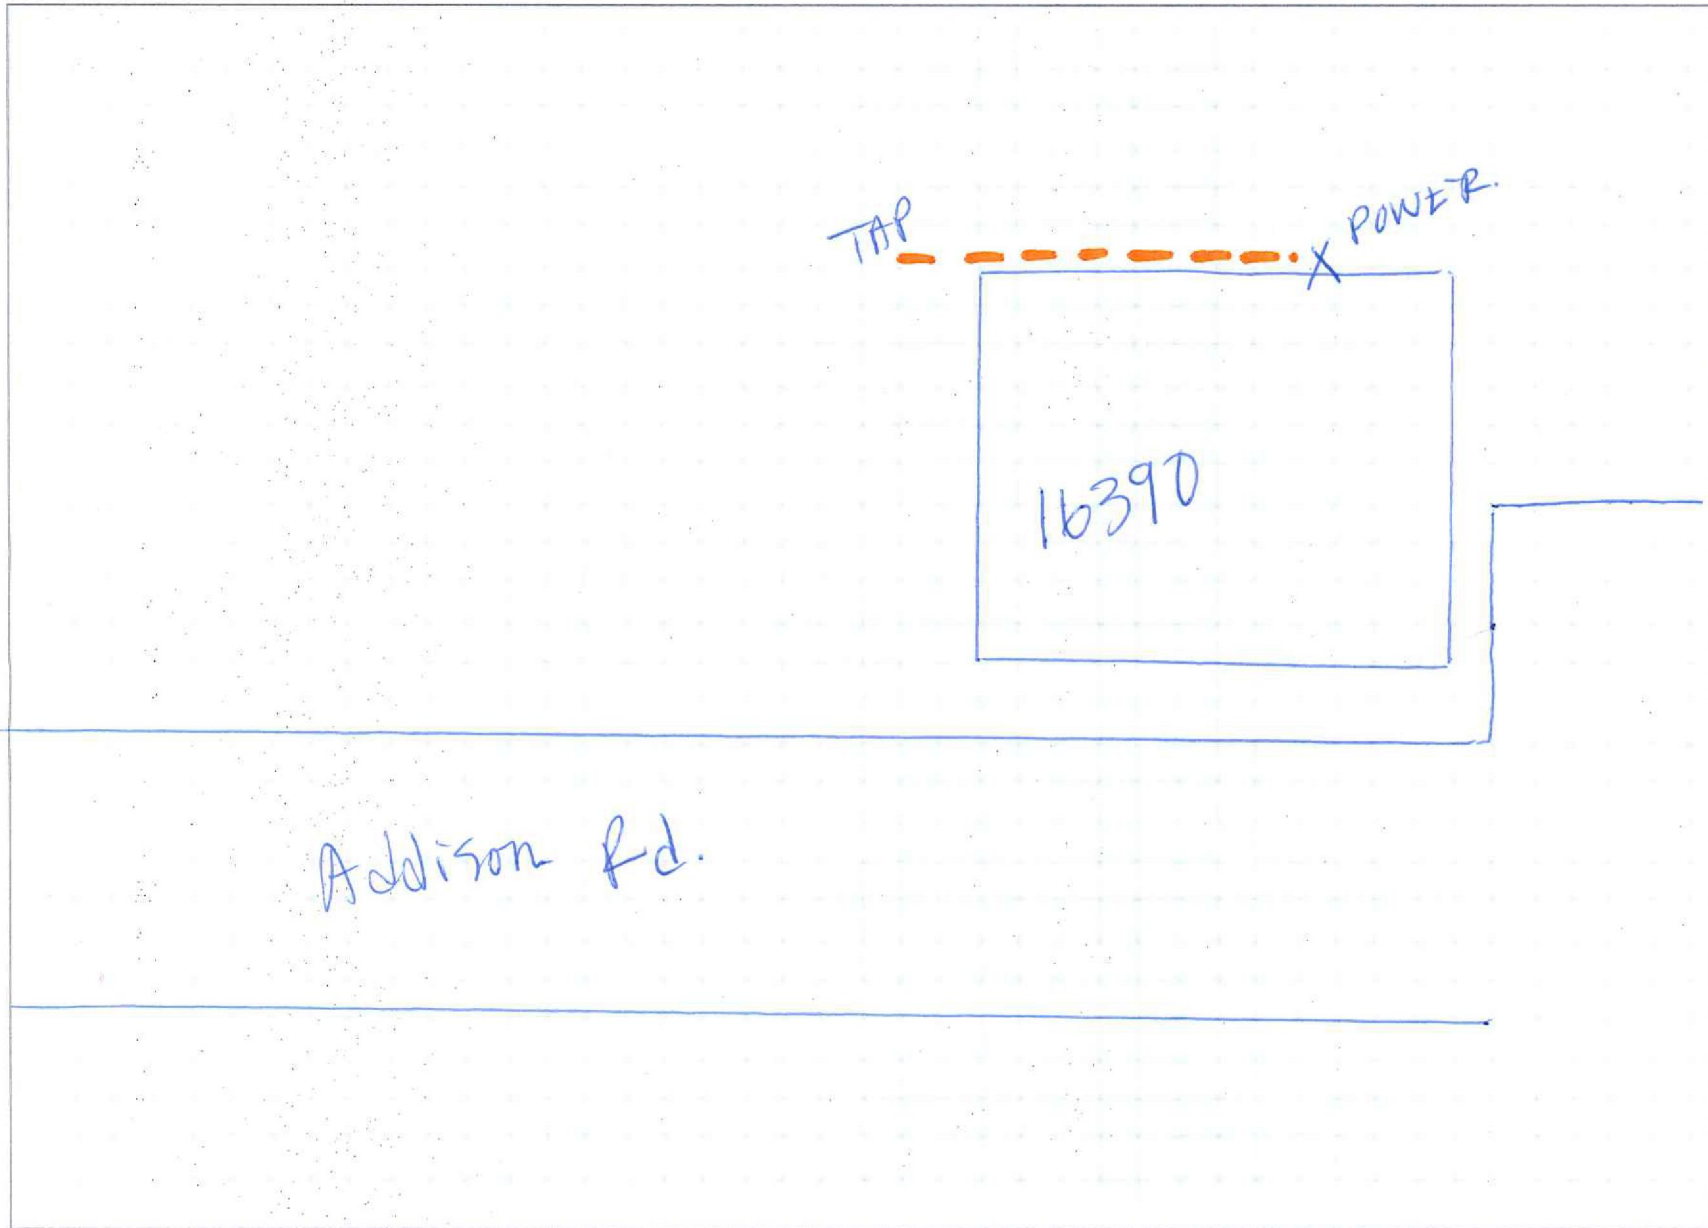

STREET NAME: 16390 Addison Rd. CITY: Addison ZIP: 75001