



FOR ADDISON USE ONLY	
Permit Number:	W-1150
Location:	14500 Winwood

**APPLICATION**

**Right of Way Work Permit -FRANCHISE**

(For Franchise Utility/CTP - Street Cut/Excavation/Lane Closure)

**PLEASE PRINT LEGIBLY**

Date of Application: 6/15/17

Facility Owner Company: AT+T Company Phone #: 800-924-9420

Utility/CTP Representative: Susan Esquivel Cell Phone #: 214-467-8276

Utility/CTP Representative E-Mail: \_\_\_\_\_

General Contractor: Tenex Construction Company Phone #: 972-913-8883

Site Supervisor Name: Rocky Stockman 24-hour phone #: 214-202-9093

Contractor E-Mail address: Rocky@tenexconstruction.com Site Foreman E-Mail: \_\_\_\_\_

Work Site Address and Location: 14500 Winwood Rd

Purpose and general description of work: Placement of Phone Service Drop

Proposed Start Work Date: 6/19/17 Estimated Completion Date: 6/30/17

Pavement Cut?  Yes  No Directional Bore/Boring?  Yes  No

Excavation?  Yes  No Lane Closure?  Yes  No Other: \_\_\_\_\_?  Yes  No

Kim Hines Kim Hines Office Manager  
Applicant's Printed Name Signature Position with Company

Applicant's Email: Kim@tenexconstruction.com Applicant's Phone Number: 972-913-883

Rocky Stockman 214-202-9093 Tenex Construction  
Direct Supervisor's Printed Name Phone Number Company Name

Supervisor's E-Mail: \_\_\_\_\_

**FOR ADDISON USE ONLY**

Received By: Melanie S. Entered?  Yes Received Date: 6-15-17

Approved By: Dave Wilde Inspector: SE Issue Date: 6/19/17


Plans Submitted?  Yes  No  N/A Traffic Control Plan Submitted?  Yes  No  N/A Expiration Date: 7/3/17

Insurance Provided?  Yes  No  On File Performance/Maintenance Bond?  Yes  No  On File  N/A

Fee Paid: NA Receipt#: CTP Date: 6-20-17 Processed By: Melanie S.

Picked Up By: Rocky Company: Tenex Date & Time: 3:32 PM 6-20-17

TOWN OF ADDISON INFRASTRUCTURE AND DEVELOPMENT SERVICES  
DEPARTMENT ATTN.: RIGHT OF WAY PERMIT - DAVE WILDE 972-450-2847  
16801 WESTGROVE RD. ADDISON, TX 75001-9010  
PHONE: 972-450-2871 FAX: 972-450-2837

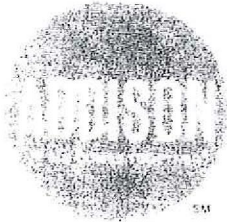

<b>FOR ADDISON USE ONLY</b>	
Permit Number:	<u>W-1150</u>
Location:	<u>14500 Winwood</u>

**APPLICATION**  
**Right of Way Work Permit -FRANCHISE**  
 (For Franchise Utility/CTP - Street Cut/Excavation/Lane Closure)

**Sub-Contractor List**

PLEASE PRINT LEGIBLY

General Contractor's Name: Tenex Construction General Contractor's Phone #: 972-913-8883

Sub-Contractor #1 Company Name: Magdalena Alvarez Address: \_\_\_\_\_

Print Sub-Contractor's Name: Magdalena Alvarez Sub-Contractor's Phone #: 972-872-5271

Sub-Contractor's E-Mail: \_\_\_\_\_

Print Site Supervisor's Name: Rocky Stockman Supervisor's Phone #: 214-202-9093

Site Supervisor's E-Mail: \_\_\_\_\_

Insurance Provided?  Yes  No  On File

Sub-Contractor #2 Company Name: Ascension Rodriguez Address: \_\_\_\_\_

Print Sub-Contractor's Name: Ascension Rodriguez Sub-Contractor's Phone #: 972-394-0971

Sub-Contractor's E-Mail: \_\_\_\_\_

Print Supervisor's Name: Rocky Stockman Supervisor's Phone #: 214-202-9093

Site Supervisor's E-Mail: \_\_\_\_\_

Insurance Provided?  Yes  No  On File

Sub-Contractor #3 Company Name: Tomacito Espinal Address: \_\_\_\_\_

Print Sub-Contractor's Name: Tomacito Espinal Sub-Contractor's Phone #: 1-214-218-5271



Sub-Contractor's E-Mail: \_\_\_\_\_

Print Supervisor's Name: Rocky Stockman Supervisor's Phone #: 214-202-9093

Site Supervisor's E-Mail: \_\_\_\_\_

Insurance Provided?  Yes  No  On File

AT+T/Tenex Const  
Log 8426056  
14500 Winnwood Rd  
Addison, Tx

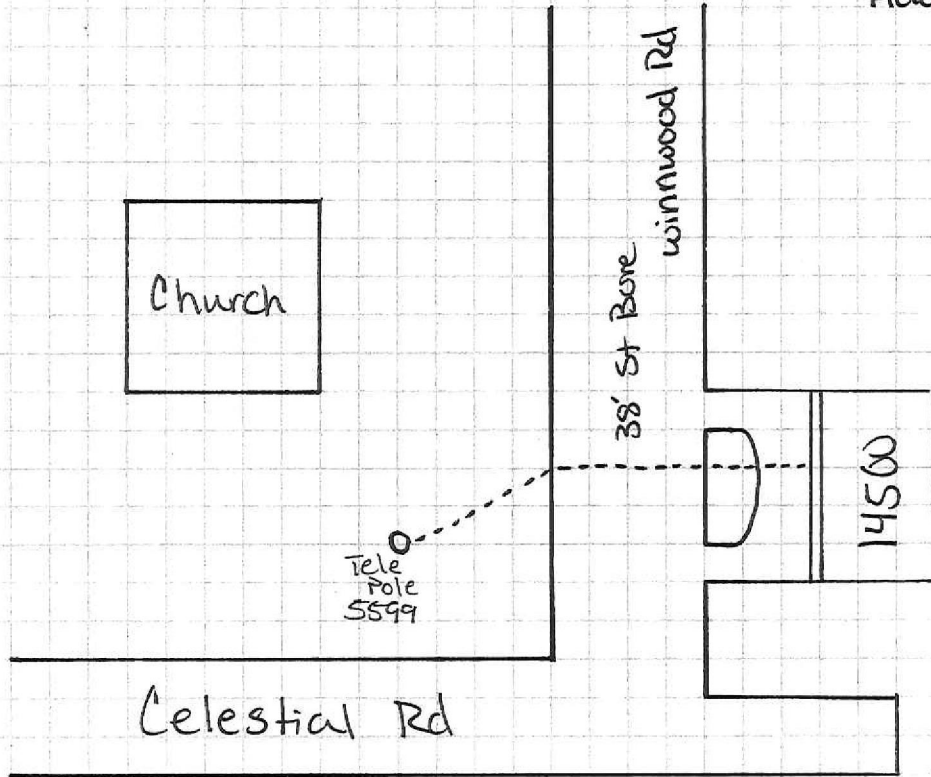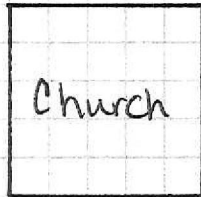

Celestial Rd

Tele Pole  
5599

38' St Bore  
Winnwood Rd

14500

Church