



FOR ADDISON USE ONLY
 Permit Number: W-1175
 Location: 4820 Westgrove

APPLICATION

Right of Way Work Permit -FRANCHISE

(For Franchise Utility/CTP - Street Cut/Excavation/Lane Closure)

PLEASE PRINT LEGIBLY

Date of Application: 7-18-17
 Facility Owner Company: Spectrum Company Phone #: 214-613-1584
 Utility/CTP Representative: Ron Guest Cell Phone #: _____
 Utility/CTP Representative E-Mail: _____
 General Contractor: Beyond Broadband Solutions Company Phone #: 214-613-1584
 Site Supervisor Name: Jovany Varquez 24-hour phone #: 214-773-1054
 Contractor E-Mail address: jvarquez@beyondbroadbands.com Site Foreman E-Mail: _____
 Work Site Address and Location: 4820 Westgrove dr Apt 705
 Purpose and general description of work: 70ft Drop bury, SW bore - 4ft.
 Proposed Start Work Date: 7-19-17 Estimated Completion Date: 7-19-17
 Pavement Cut? Yes No Directional Bore/Boring? Yes No
 Excavation? Yes No Lane Closure? Yes No Other: _____ ? Yes No
 Applicant's Printed Name: Jovany Varquez Signature: [Signature] Position with Company: Supervisor
 Applicant's Email: jvarquez@beyondbroadbands.com Applicant's Phone Number: 214-773-1054
 Direct Supervisor's Printed Name: Edgar Monge Phone Number: 214-243-3162 Company Name: BBS
 Supervisor's E-Mail: emonge@beyondbroadbands.com


FOR ADDISON USE ONLY

Received By: Nicole Simon Entered? Yes Received Date: 7/18/17
 Approved By: [Signature] Inspector: JF Issue Date: 7/24/17
 Plans Submitted? Yes No N/A Traffic Control Plan Submitted? Yes No N/A Expiration Date: 8/2/17
 Insurance Provided? Yes No On File Performance/Maintenance Bond? Yes No On File N/A
 Fee Paid: NA Receipt#: CTP Date: _____ Processed By: _____
 Picked Up By: [Signature] Company: BBS Date & Time: 7-27-17

TOWN OF ADDISON INFRASTRUCTURE AND DEVELOPMENT SERVICES
 DEPARTMENT ATTN.: RIGHT OF WAY PERMIT - DAVE WILDE 972-450-2847
 16801 WESTGROVE RD. ADDISON, TX 75001-9010
 PHONE: 972-450-2871 FAX: 972-450-2837

1:25pm

BEYOND BROADBAND SOLUTIONS INC.
OFFICE- 214-501-4300

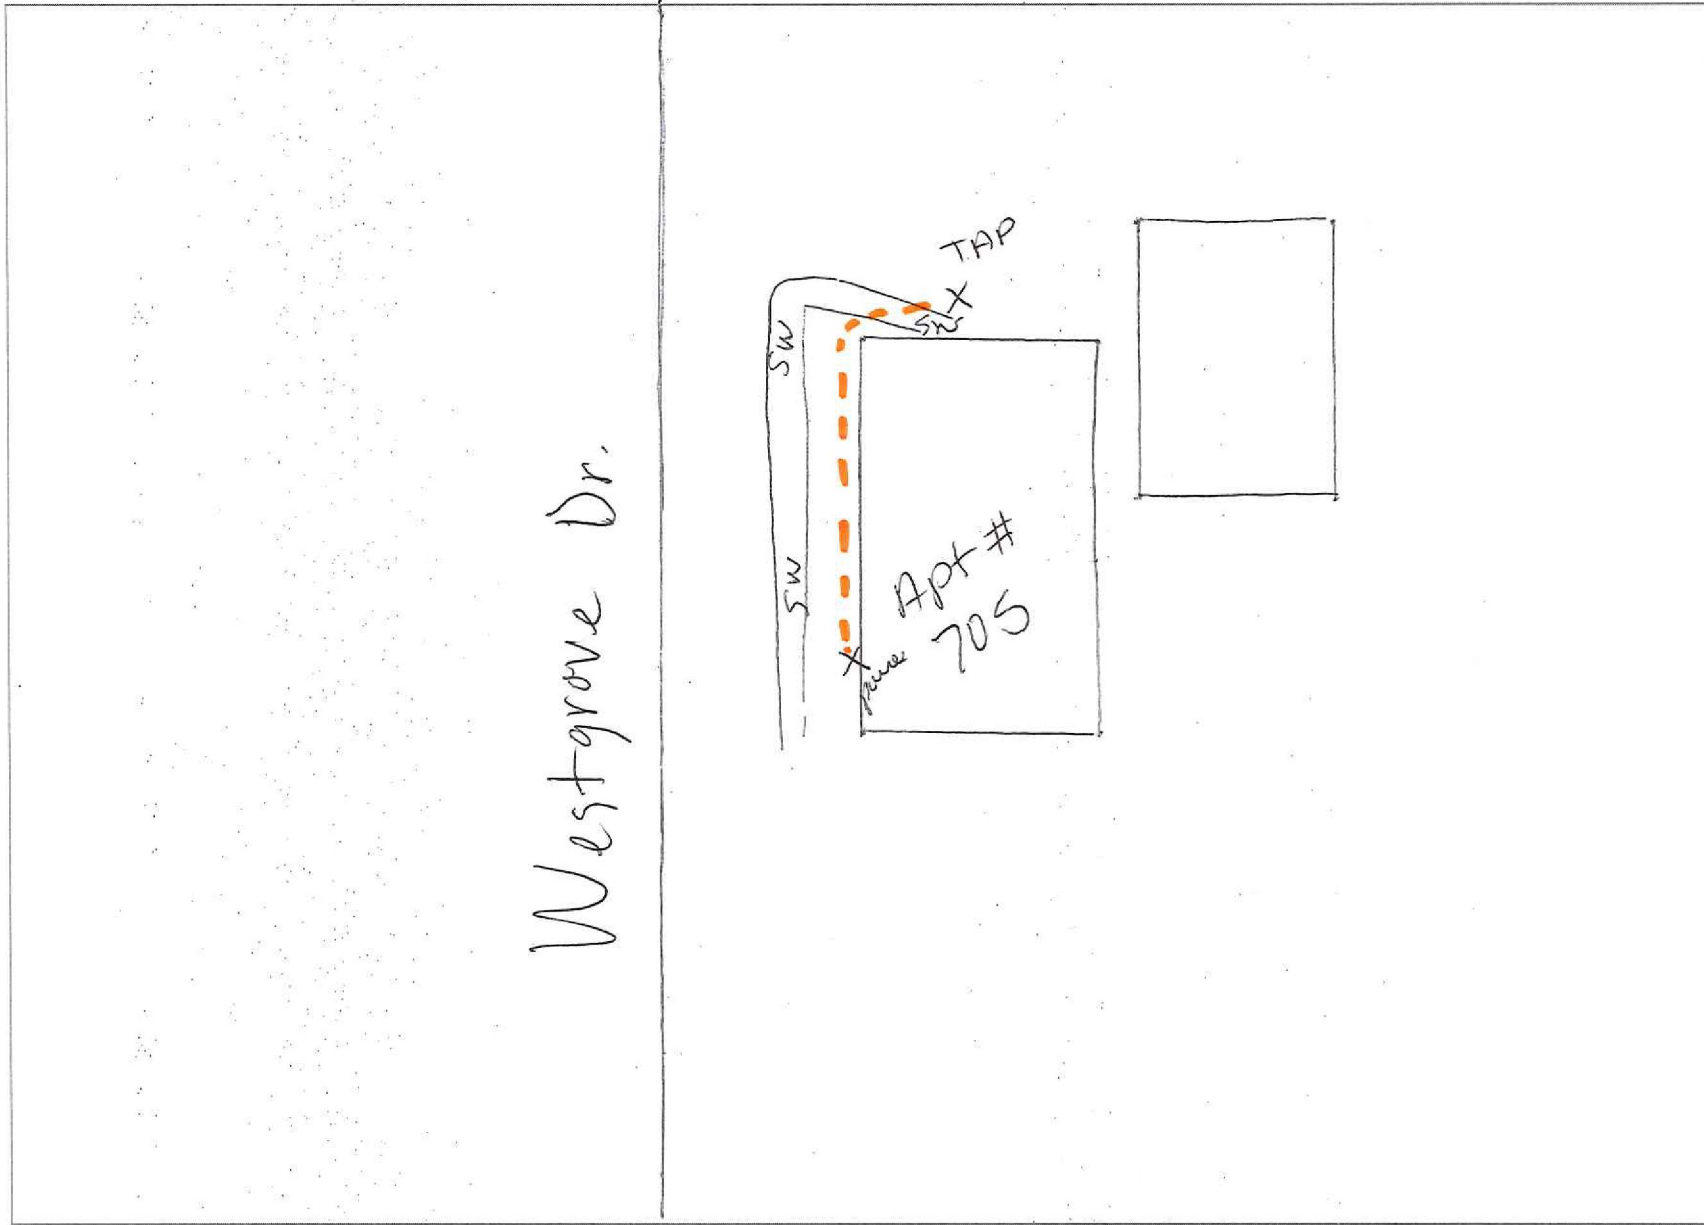

STREET NAME: 4820 Westgrove Dr CITY: Addison ZIP: 75001