



FOR ADDISON USE ONLY
 Permit Number: W-1166
 Location: 3915 Winterpark Ln.

APPLICATION

Right of Way Work Permit -FRANCHISE

(For Franchise Utility/CTP - Street Cut/Excavation/Lane Closure)

PLEASE PRINT LEGIBLY

Date of Application: 7/3/17

Facility Owner Company: AT+T Company Phone #: 800-924-9420

Utility/CTP Representative: Susan Esquivel Cell Phone #: 214-467-8276

Utility/CTP Representative E-Mail: _____

General Contractor: Tenex Construction Company Phone #: 972-913-8883

Site Supervisor Name: Rocky Stockman 24-hour phone #: 214-202-9093

Contractor E-Mail address: Rocky@tenexconstruction.com Site Foreman E-Mail: _____

Work Site Address and Location: 3915 WINTER PARK LN

Purpose and general description of work: Placement of Phone Service Drop

Proposed Start Work Date: 7/5/17 Estimated Completion Date: 7/19/17

Pavement Cut? Yes No Directional Bore/Boring? Yes No

Excavation? Yes No Lane Closure? Yes No Other: _____? Yes No

Kim Hines Kim Hines Office Manager
 Applicant's Printed Name Signature Position with Company

Applicant's Email: Kim@tenexconstruction.com Applicant's Phone Number: 972-913-8883

Rocky Stockman 214-202-9093 Tenex Construction
 Direct Supervisor's Printed Name Phone Number Company Name

Supervisor's E-Mail: _____

Received By: Michele S. **FOR ADDISON USE ONLY** Entered? Yes Received Date: 7-3-17

Approved By: Dave Wilde Inspector: JE Issue Date: 7/6/17


Plans Submitted? Yes No N/A Traffic Control Plan Submitted? Yes No N/A Expiration Date: 7/20/17

Insurance Provided? Yes No On File Performance/Maintenance Bond? Yes No On File N/A

Fee Paid: NA Receipt#: CTP Date: 7.6.17 Processed By: Michele S.

Picked Up By: Rocky Company: Tenex Date & Time: 3:54 PM

TOWN OF ADDISON INFRASTRUCTURE AND DEVELOPMENT SERVICES
 DEPARTMENT ATTN.: RIGHT OF WAY PERMIT - DAVE WILDE 972-450-2847
 16801 WESTGROVE RD. ADDISON, TX 75001-9010
 PHONE: 972-450-2871 FAX: 972-450-2837

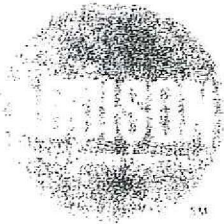

FOR ADDISON USE ONLY	
Permit Number:	_____
Location:	_____

APPLICATION
Right of Way Work Permit -FRANCHISE
 (For Franchise Utility/CTP - Street Cut/Excavation/Lane Closure)

Sub-Contractor List

PLEASE PRINT LEGIBLY

General Contractor's Name: Tenex Construction General Contractor's Phone #: 972-913-8883

Sub-Contractor #1 Company Name: Magdalena Alvarez Address: _____

Print Sub-Contractor's Name: Magdalena Alvarez Sub-Contractor's Phone #: 972-872-5271

Sub-Contractor's E-Mail: _____

Print Site Supervisor's Name: Rocky Stockman Supervisor's Phone #: 214-202-9093

Site Supervisor's E-Mail: _____

Insurance Provided? Yes No On File

Sub-Contractor #2 Company Name: Ascension Rodriguez Address: _____

Print Sub-Contractor's Name: Ascension Rodriguez Sub-Contractor's Phone #: 972-394-0971

Sub-Contractor's E-Mail: _____

Print Supervisor's Name: Rocky Stockman Supervisor's Phone #: 214-202-9093

Site Supervisor's E-Mail: _____

Insurance Provided? Yes No On File

Sub-Contractor #3 Company Name: Tomacito Espinal Address: _____

Print Sub-Contractor's Name: Tomacito Espinal Sub-Contractor's Phone #: 1-214-218-5271


Sub-Contractor's E-Mail: _____

Print Supervisor's Name: Rocky Stockman Supervisor's Phone #: 214-202-9093

Site Supervisor's E-Mail: _____

Insurance Provided? Yes No On File

TOWN OF ADDISON INFRASTRUCTURE AND DEVELOPMENT SERVICES
 DEPARTMENT ATTN.: RIGHT OF WAY PERMIT - DAVE WILDE 972-450-2847
 16801 WESTGROVE RD. ADDISON, TX 75001-9010
 PHONE: 972-450-2871 FAX: 972-450-2837

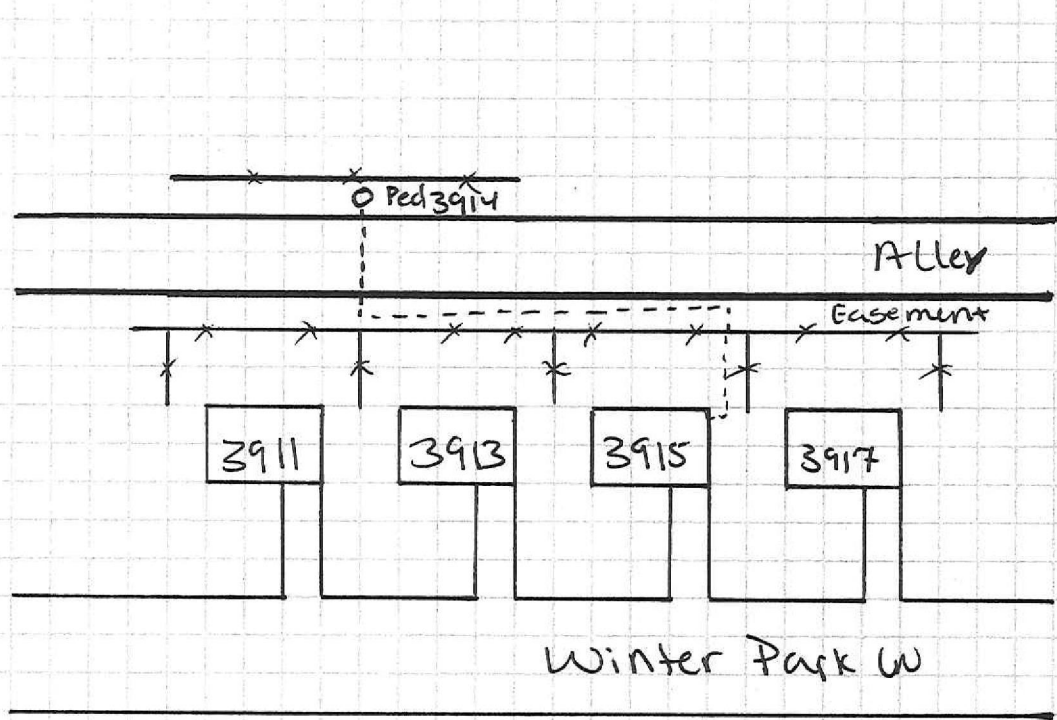

AT&T/Tenex Const
Log 8507105
3915 Winter Park Ln
Addison, TX