



FOR ADDISON USE ONLY
 Permit Number: W-1195
 Location: 5005 Meridian

APPLICATION
Right of Way Work Permit -FRANCHISE
 (For Franchise Utility/CTP - Street Cut/Excavation/Lane Closure)

PLEASE PRINT LEGIBLY

Date of Application: 8/10/17

Facility Owner Company: AT+T Company Phone #: 800-924-9420
 Utility/CTP Representative: Susan Esquivel Cell Phone #: 214-467-8276
 Utility/CTP Representative E-Mail: _____

General Contractor: Tenex Construction Company Phone #: 972-913-8883
 Site Supervisor Name: Rocky Stockman 24-hour phone #: 214-202-9093
 Contractor E-Mail address: Rocky@tenexconstruction.com Site Foreman E-Mail: _____

Work Site Address and Location: 5005 MERIDIAN LN / MERIDIAN SQUARE CONDOS
 Purpose and general description of work: Placement of Phone Service Drop
 Proposed Start Work Date: 8/14/17 Estimated Completion Date: 8/25/17

Pavement Cut? Yes No Directional Bore/Boring? Yes No
 Excavation? Yes No Lane Closure? Yes No Other: _____? Yes No

Kim Hines Kim Hines Office Manager
 Applicant's Printed Name Signature Position with Company

Applicant's Email: Kim@tenexconstruction.com Applicant's Phone Number: 972-913-8883
Rocky Stockman 214-202-9093 Tenex Construction
 Direct Supervisor's Printed Name Phone Number Company Name
 Supervisor's E-Mail: _____

FOR ADDISON USE ONLY

Received By: Nicole Simpson Entered? Yes Received Date: 8-10-17
 Approved By: [Signature] Inspector: JE Issue Date: 8/10/17
 Plans Submitted? Yes No N/A Traffic Control Plan Submitted? Yes No N/A Expiration Date: 8/29/17
 Insurance Provided? Yes No On File Performance/Maintenance Bond? Yes No On File N/A
 Fee Paid: NA Receipt#: CTP Date: 8-22-17 Processed By: Nicole J.
 Picked Up By: Rocky Company: TENEX Date & Time: 8-22-17
10:04 AM

TOWN OF ADDISON INFRASTRUCTURE AND DEVELOPMENT SERVICES
 DEPARTMENT ATTN.: RIGHT OF WAY PERMIT - DAVE WILDE 972-450-2847
 16801 WESTGROVE RD. ADDISON, TX 75001-9010
 PHONE: 972-450-2871 FAX: 972-450-2837



FOR ADDISON USE ONLY	
Permit Number:	<u>W-1195</u>
Location:	<u>8005 Meridian</u>

APPLICATION
Right of Way Work Permit -FRANCHISE
 (For Franchise Utility/CTP - Street Cut/Excavation/Lane Closure)

Sub-Contractor List

PLEASE PRINT LEGIBLY

General Contractor's Name: Tenex Construction General Contractor's Phone #: 972-913-8883

Sub-Contractor #1 Company Name: Magdeleno Alvarez Address: _____

Print Sub-Contractor's Name: Magdeleno Alvarez Sub-Contractor's Phone #: 972-872-5271

Sub-Contractor's E-Mail: _____

Print Site Supervisor's Name: Rocky Stockman Supervisor's Phone #: 214-202-9093

Site Supervisor's E-Mail: _____

Insurance Provided? Yes No On File

Sub-Contractor #2 Company Name: Ascension Rodriguez Address: _____

Print Sub-Contractor's Name: Ascension Rodriguez Sub-Contractor's Phone #: 972-394-0971

Sub-Contractor's E-Mail: _____

Print Supervisor's Name: Rocky Stockman Supervisor's Phone #: 214-202-9093

Site Supervisor's E-Mail: _____

Insurance Provided? Yes No On File

Sub-Contractor #3 Company Name: Tomacito Espinal Address: _____

Print Sub-Contractor's Name: Tomacito Espinal Sub-Contractor's Phone #: 1-214-218-5271

Sub-Contractor's E-Mail: _____

Print Supervisor's Name: Rocky Stockman Supervisor's Phone #: 214-202-9093

Site Supervisor's E-Mail: _____


Insurance Provided? Yes No On File

AT&T/Tenex Const
log # 88478
Meridian Square Condos
Addison Tx




Airport PKwy

Guorum Dr

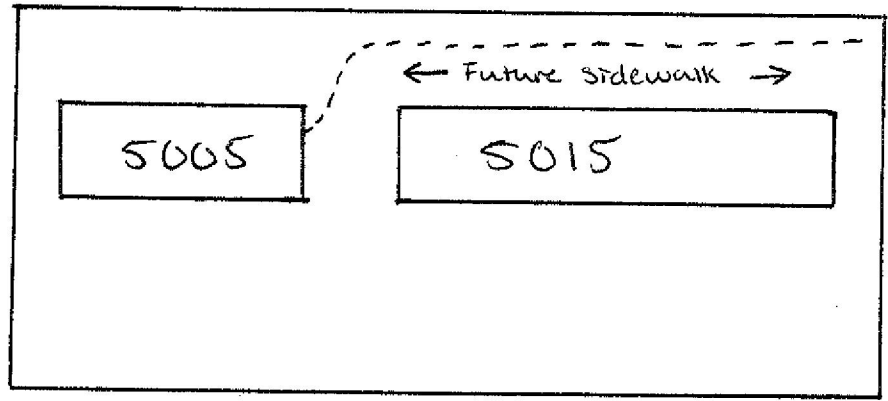

Meridian Ln

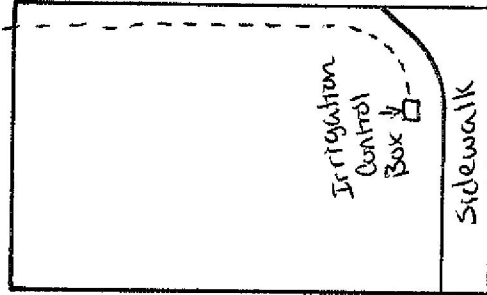

Spectrum Dr

Whisper Ln

Meridian Ln

