

FOR	ADDISON	USE	ONL	Y

Permit Number: W-1214

Location: 3887 Emerald

APPLICATION

Right of Way Work Permit -FRANCHISE

(For Franchise Utility/CTP - Street Cut/Excavation/Lane Closure)

Date of Application: 9/5/17				
Facility Owner Company: <u>AT+T</u>	_Company Phone #: 800 -974-9470			
Utility/CTP Representative: Susan Esquivel				
Utility/CTP Representative E-Mail:				
General Contractor: Tenex Construction	_Company Phone #: 97-2-913-8883			
Site Supervisor Name: Rocky Stockman	_24-hour phone #: <u>214-707-9093</u>			
Contractor E-Mail address: Bocky@tenex construction Cons				
Work Site Address and Location: 3887 Emeraco CT				
Purpose and general description of work: Placement of	F Phone Service Drop			
Proposed Start Work Date: 9/6/17 Estimates	ated Completion Date: 9//5//7			
Pavement Cut? □Yes ☑No Directional Bore/Boring? □Yes ☑No				
Excavation? □Yes ☑No Lane Closure? □Yes ☑No Applicant's Printed Name Lane Closure? □Yes ☑No Signature	Other ? DYes DNo OFFICE MANAGER Position with Company			
Applicant's Email: Kim @ tenexConstruction . Com Applicant's	s Phone Number: <u>9777-913-883</u>			
Nocky Stockman 214-202-9093 Direct Supervisor's Printed Name Phone Number				
Supervisor's E-Mail:				
Received By: FOR ADDISON USE OF Entered? □Yes	NLY Received Date: (小方・1つ			
Approved By: Duris Will Inspector:	Issue Date: 9/6/17			
Plans Submitted? ☐Yes ☐No ☐N/A Traffic Control Plan Submitted? ☐Y	Yes MNo □N/A Expiration Date: 9/20/17			
Insurance Provided?	enance Bond? CIYes CINo COn File ION/A			
- 1/ * VI ·	Processed By: Mul 1			
Picked Up By: Kally Company: Tun	<u> </u>			

TOWN OF ADDISON INFRASTRUCTURE AND DEVELOPMENT SERVICES DEPARTMENT ATTN.: RIGHT OF WAY PERMIT - DAVE WILDE 972-450-2847 16801 WESTGROVE RD. ADDISON, TX 75001-9010 PHONE: 972-450-2871 FAX: 972-450-2837



FOR ADDISON USE ONLY
Permit Number: 11-12/54
Location: 3 887 Enerals Ch

APPLICATION

Right of Way Work Permit -FRANCHISE


(For Franchise Utility/CTP - Street Cut/Excavation/Lane Closure)

Sub-Contractor List

PLEASE PRINT LEGIBLY

General Contractor's Name: Tenex Construction General Contractor's Phone #: 972-913-8883
Sub-Contractor #1 Company Name: Mandeleno Hmarez Address:
Sub-Contractor's E-Mail:Sub-Contractor's Phone #: 472-872-577
Print Site Supervisor's Name: Rocky Stockman Supervisor's Phone #: 214-202-9093 Site Supervisor's E-Mail:
Insurance Provided? Yes No for File
Sub-Contractor #2 Company Name: Ascension Rodriguez Address: Print Sub-Contractor's Name: Ascension Rodriguez Sub-Contractor's Phone #: 977-394-0971 Sub-Contractor's E-Mail: Print Supervisor's Name: Rocky Stockman Supervisor's Phone #: 214-707-9093
The state of the s
Insurance Provided? Tyes TNo Mon File Sub-Contractor #3 Company Name: Tomacito Espinal Address: Print Sub-Contractor's Name: Tomacito Espinal Sub-Contractor's Phone #: 1 - 214 - 218 - 5241 Sub-Contractor's E-Mail:
Print Supervisor's Name: Rocky Stockman Supervisor's Phone #: 214-207-9093 Site Supervisor's E-Mail:
nsurance Provided? ⊓Yes ⊓No เ⊮on File

TOWN OF ADDISON INFRASTRUCTURE AND DEVELOPMENT SERVICES DEPARTMENT ATTN.: RIGHT OF WAY PERMIT - DAVE WILDE 972-450-2847 16801 WESTGROVE RD. ADDISON, TX 75001-9010 PHONE: 972-450-2871 FAX: 972-450-2837

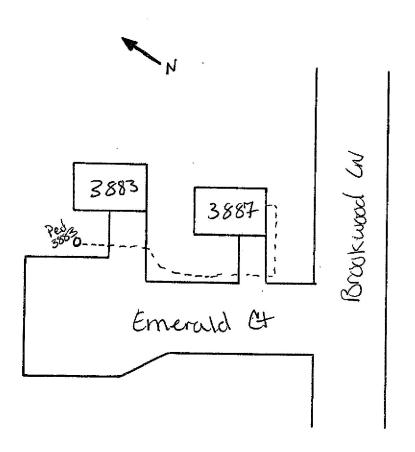

Att Tenex Const Log 8768684 3887 Emerald Ct Addison, TX