



FOR ADDISON USE ONLY
 Permit Number: W-1239
 Location: 14906 Landmark Blvd

APPLICATION
Right of Way Work Permit -FRANCHISE
 (For Franchise Utility/CTP - Street Cut/Excavation/Lane Closure)

PLEASE PRINT LEGIBLY

Date of Application: 10/09/2017
 Facility Owner Company: ONCOR ELECTRIC Company Phone #: _____
 Utility/CTP Representative: BILL WALDROP Cell Phone #: 469-261-2498
 Utility/CTP Representative E-Mail: BILL.WALDROP@ONCOR.COM
 General Contractor: STANDARD UTILITY Company Phone #: 817-738-8400
 Site Supervisor Name: JASON DEAN 24-hour phone #: 817-876-8046
 Contractor E-Mail address: jasondean@standard-utility.com Site Foreman E-Mail: _____

Work Site Address and Location: 14906 LANDMARK BLVD

Purpose and general description of work: cut concrete in median to make repairs to street light cables

Proposed Start Work Date: 10/13/2017 Estimated Completion Date: 11/13/2017

Pavement Cut? Yes No Directional Bore/Boring? Yes No

Excavation? Yes No Lane Closure? Yes No Other: concrete cut in median ? Yes No

JASON DEAN [Signature] ASSISTANT MANAGING FOREMAN
 Applicant's Printed Name Signature Position with Company

Applicant's Email: jasondean@standard-utility.com Applicant's Phone Number: 817-876-8046

Direct Supervisor's Printed Name _____ Phone Number _____ Company Name _____
 Supervisor's E-Mail: _____

Received By: [Signature] **FOR ADDISON USE ONLY** Entered? Yes Received Date: 10/9/17 10:26AM

Approved By: [Signature] Inspector: JF Issue Date: 10/10/17


Plans Submitted? Yes No N/A Traffic Control Plan Submitted? Yes No N/A Expiration Date: 10/24/17

Insurance Provided? Yes No On File Performance/Maintenance Bond? Yes No On File N/A

Fee Paid: NA Receipt#: FRANCHISE Date: _____ Processed By: _____

Picked Up By: _____ Company: _____ Date & Time: _____

TOWN OF ADDISON INFRASTRUCTURE AND DEVELOPMENT SERVICES
 DEPARTMENT ATTN.: RIGHT OF WAY PERMIT - DAVE WILDE 972-450-2847
 16801 WESTGROVE RD. ADDISON, TX 75001-8010
 PHONE: 972-450-2871 FAX: 972-450-2837

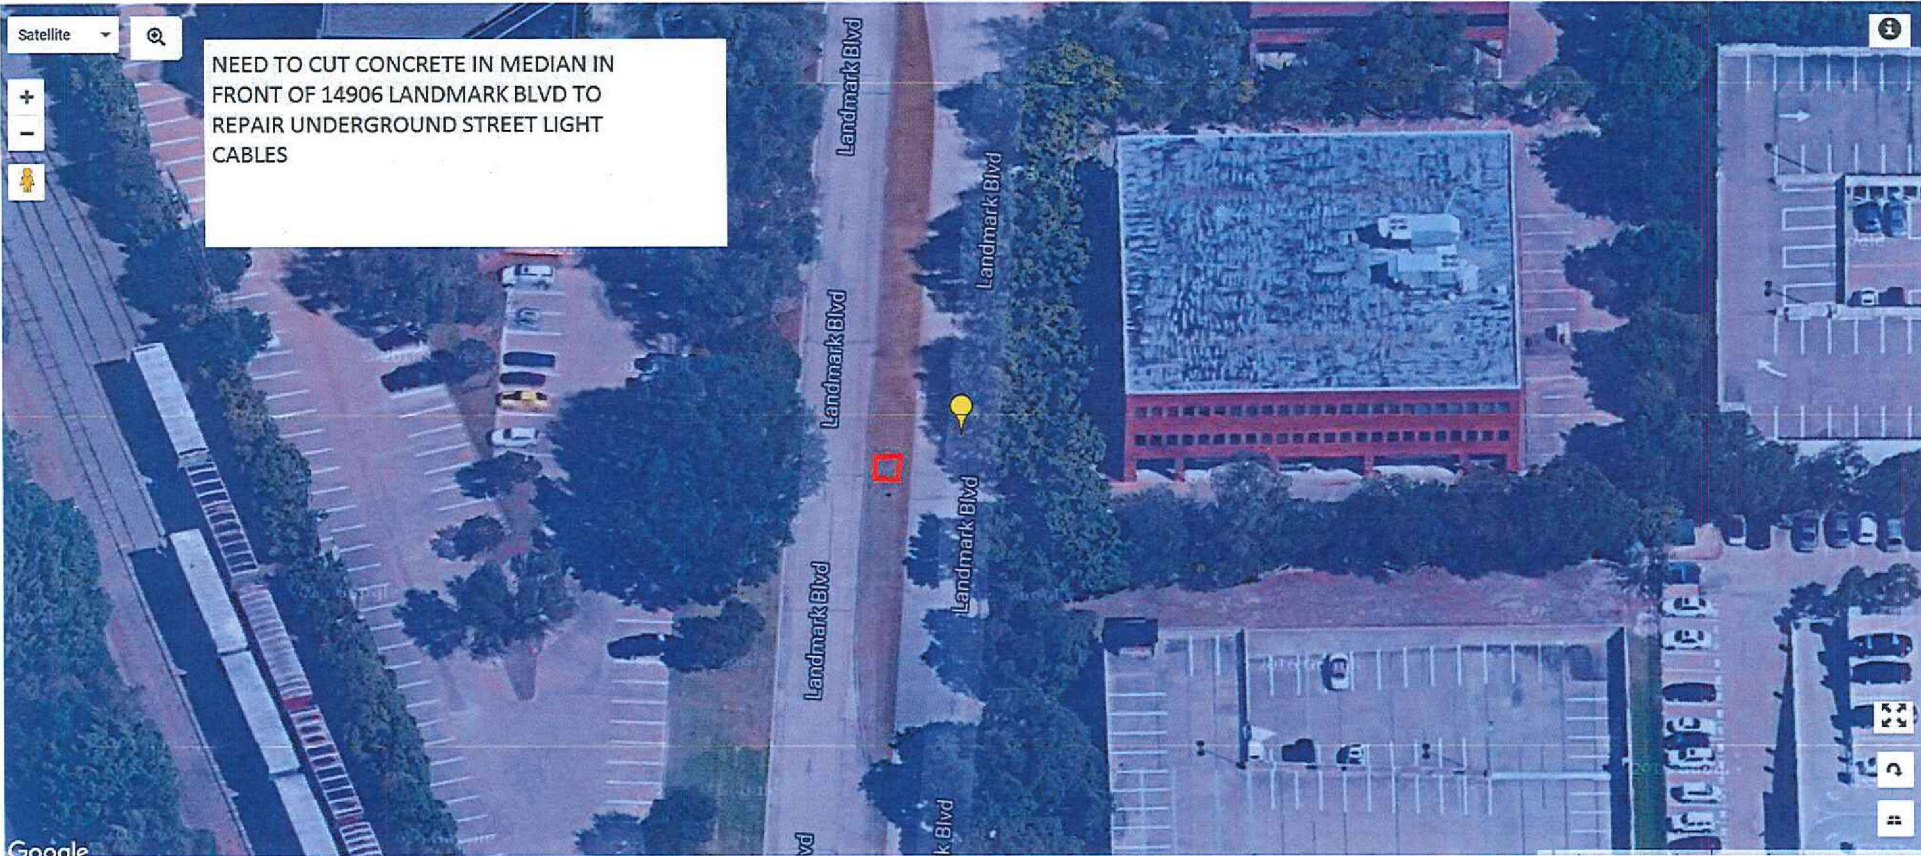

NEED TO CUT CONCRETE IN MEDIAN IN FRONT OF 14906 LANDMARK BLVD TO REPAIR UNDERGROUND STREET LIGHT CABLES