



FOR ADDISON USE ONLY

Permit Number: W-1243
Location: 17590-114 Planters Row

APPLICATION

Right of Way Work Permit -PUBLIC UTILITY/CTP

(For Public Utility/CTP - Street Cut/Excavation/Lane Closure)

PLEASE PRINT LEGIBLY

Date of application: 10-13-17

Facility Owner Company: Spectrum Company Phone #: 214-935-8747

Utility/CTP Representative: Lyle Bradley Cell Phone #: 214-846-5286

General Contractor: STC Utility Services Company Phone #: 214-295-5422

Site Supervisor Name: Chris Twidwell 24 hour phone #: 214-283-4706

Work Site Address and Location: 17090 to 17114 Planters Row Ticket# 81545

Purpose and general description of work: Directional bore and place new CATV conduit to replace damaged cable

Proposed Start Work Date: 10-16-17 Estimated Completion Date: 11-16-17

Pavement Cut? Yes No Directional Bore/Boring? Yes No

Excavation? Yes No Lane Closure? Yes No Other: _____? Yes No

Melissa Gonzalez Applicant's Printed Name [Signature] Signature Project Coordinator Position with Company

Applicant's Email: melissa.gonzalez@stcutility.com Applicant's Phone Number: 817-683-0478

Chris Twidwell Direct Supervisor's Printed Name 214-283-4706 Phone Number STC Utility Services Company Name

FOR ADDISON USE ONLY

Received By: [Signature] Entered? Yes Received Date: 10-12-17

Approved By: [Signature] Inspector: JF Issue Date: 10/16/17

Plans Submitted? Yes No N/A Traffic Control Plan Submitted? Yes No N/A Expiration Date: 10/30/17

Insurance Provided? Yes No On File Performance/Maintenance Bond? Yes No On File N/A

Fee Paid: NA Receipt#: CTP Date: _____ Processed By: _____

Picked Up By: Seth McCormick Company: STC Date & Time: 12:59

TOWN OF ADDISON INFRASTRUCTURE AND DEVELOPMENT SERVICES
DEPARTMENT ATTN.: RIGHT OF WAY PERMIT - DAVE WILDE 972-450-2847
16801 WESTGROVE RD. ADDISON, TX 75001-9010
PHONE: 972-450-2871 FAX: 972-450-2837



FOR ADDISON USE ONLY
 Permit Number: W-1243
 Location: 17090--114 Planters Row

APPLICATION
Right of Way Work Permit –PUBLIC UTILITY/CTP
 (For Public Utility/CTP - Street Cut/Excavation/Lane Closure)

Sub-Contractor List

PLEASE PRINT LEGIBLY

General Contractor's Name: STC Utiliy General Contractor's Phone #: 214-295-5422

Sub-Contractor #1 Company Name: _____ Address: _____

Print Sub-Contractor's Name: _____ Sub-Contractor Phone #: _____

Print Site Supervisor's Name: _____ Supervisor's Phone #: _____

Insurance Provided? Yes No On File

Sub-Contractor #2 Company Name: _____ Address: _____

Print Sub-Contractor's Name: _____ Sub-Contractor Phone #: _____

Print Supervisor's Name: _____ Supervisor's Phone #: _____

Insurance Provided? Yes No On File


Sub-Contractor #3 Company Name: _____ Address: _____

Print Sub-Contractor's Name: _____ Sub-Contractor Phone #: _____

Print Supervisor's Name: _____ Supervisor's Phone #: _____

Insurance Provided? Yes No On File

RIGHT OF WAY, EXCAVATION &
LANE CLOSURE PERMIT

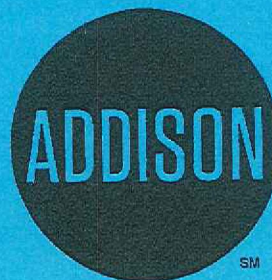

INFRASTRUCTURE &
DEVELOPMENT SERVICES

16801 WESTGROVE DRIVE
ADDISON, TEXAS 75001
972.450.2871

W-1243

PERMIT NUMBER

10/16/17

START DATE

11/16/17

EST. COMPLETION DATE

STC UTILITY SVCS

CONTRACTOR

SPECTRUM

FOR

17090—17114 PLANTERS ROW

LOCATION (ADDRESS)

IN UTILITY EASEMENT BETWEEN HOUSES

LOCATION (ACTUAL)

REPLACE DAMAGED CABLE – DIRECTIONAL BORE

TYPE OF WORK




THIS CARD MUST BE DISPLAYED ON THE JOB SITE AT ALL TIMES.

Peggy Price

From: RMO_Robot@charter.com
Sent: Tuesday, September 26, 2017 1:51 PM
To: Permits@kinetic-eng.com; Mike_Akard@kinetic-eng.com; RMO@kinetic-eng.com; david_huss@kinetic-eng.com; C-Joy.Heaton@charter.com; David.hatton@dfw-telecom.com; Vicki.moore@dfw-telecom.com; Dayna.lapoma@dfw-telecom.com; Laura Pedersen; Chris Pedersen; Chris Ottenhausen; Peggy Price; Chris Twidwell; Mike Cornett; DeeAnn Gentry; Melissa Gonzalez; Lyle.Bradley@Charter.com; C-Gage.Joyce@charter.com
Subject: RMO - New ticket #81545 - There is a ticket assigned to you.
Attachments: ATT00001.jpg; ATT00002.jpg
Importance: Low

There has been a ticket assigned to you. [Click to view.](#)

RMWO Ticket #:	81545
PRIN:	Dallas
Entered By:	Gary, Marvin
Authorized By:	Hopejr, James
Routed To:	STC-Utilities
Assigned To:	Bradley, Lyle
Date of Order:	9/16/2017
Date Completed:	
Completed By:	
Tech ID / Cell phone:	1490 / 9726708682
Node / Amp:	1k02 / d430
TDR Sent:	(X)Yes
Location:	from 17090to17114 planters rows ,Addison
Description:	replace cable from 14 to 12 to10 to 4
Type of Repair:	[X]UG
Repair of:	[X]Cable
Fiber count:	0 count [X]UG
Cable sizes	.625 CA [X]UG 120 feet
Direct bury?	(X)Yes
Conduit size:	[X]2"
Type of soil:	[X]Dirt
Is temp line placed?	(X)No

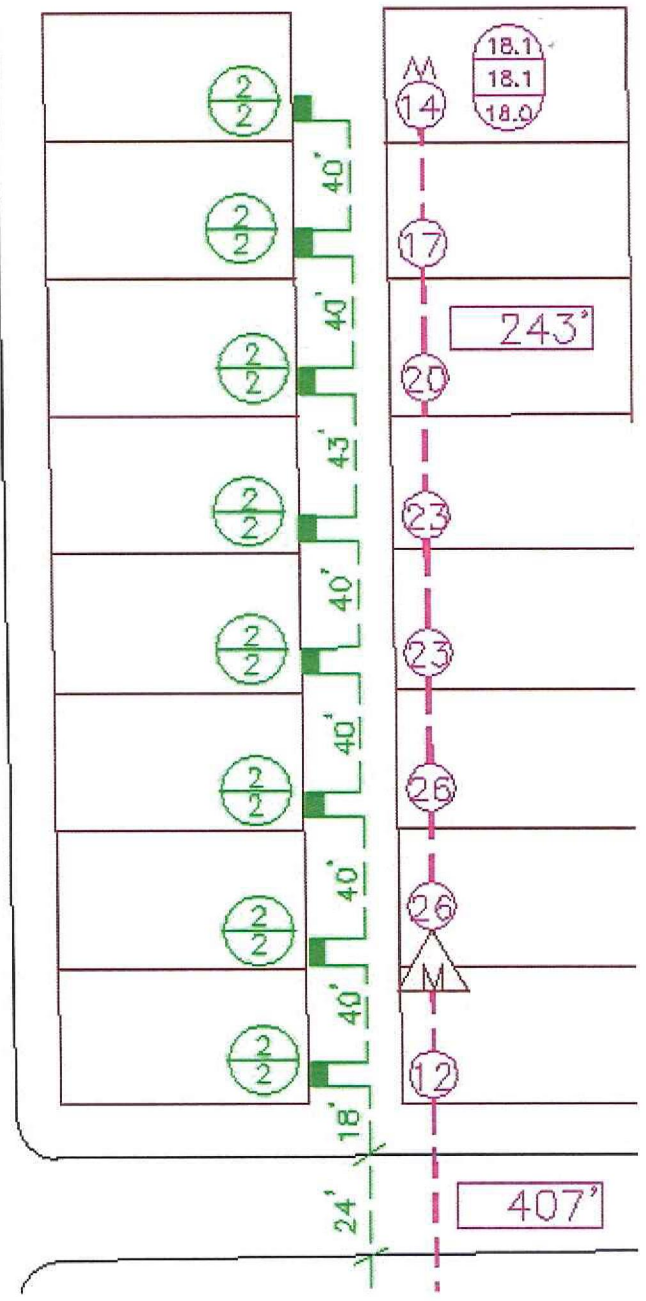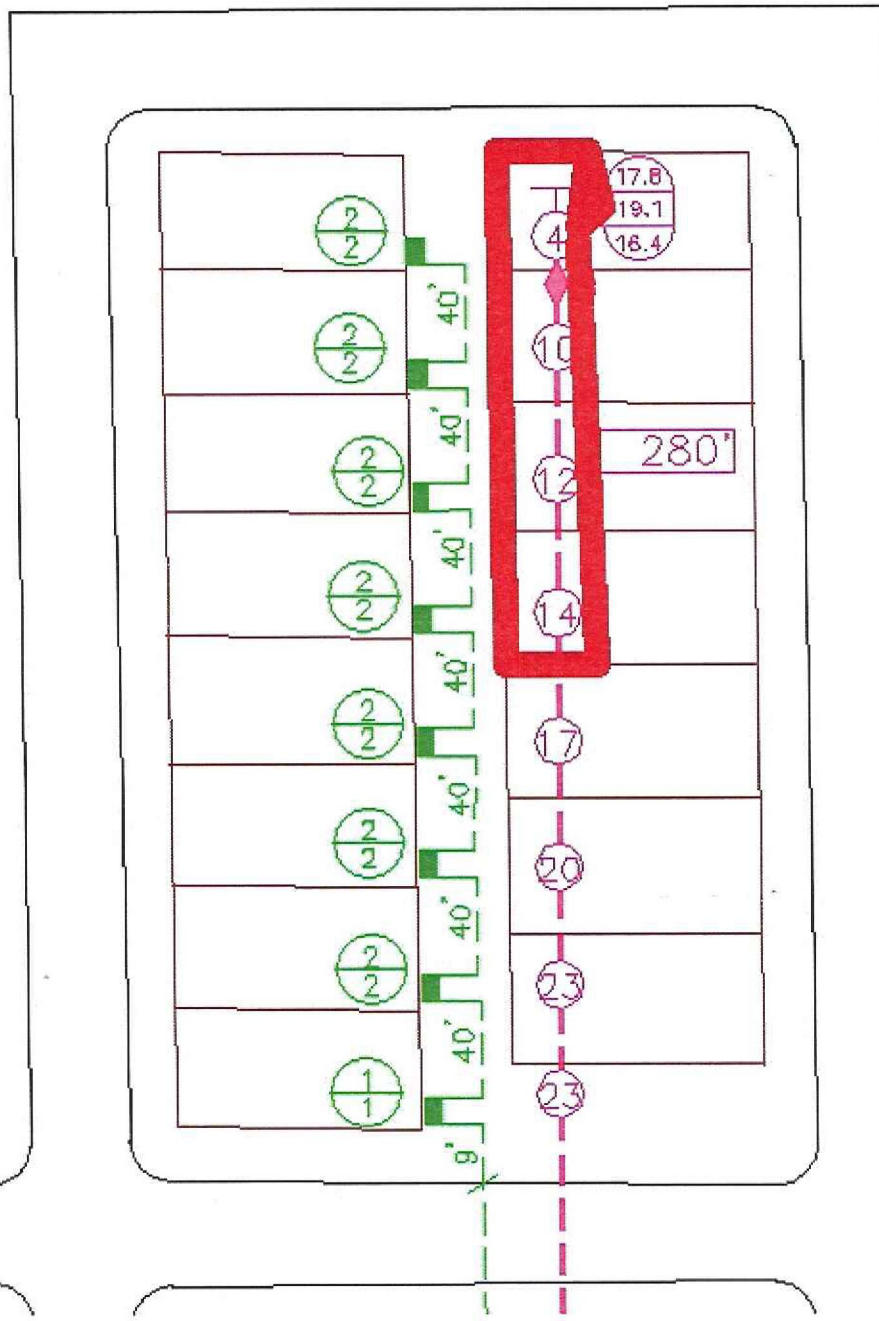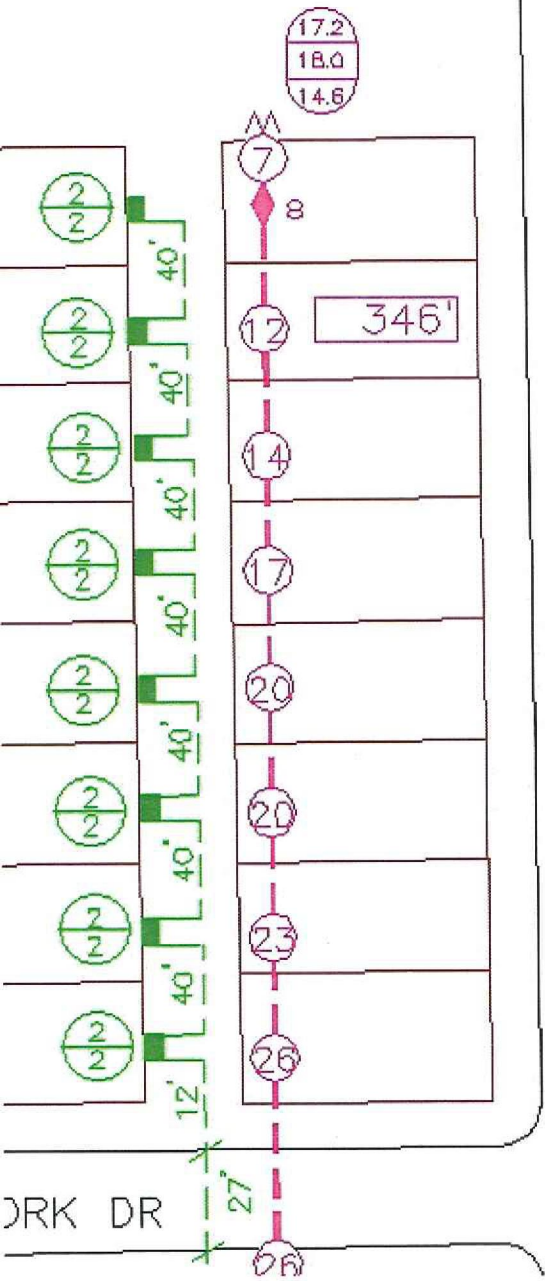



Right-of-Way Permit Application Check List

(Street Cut/Excavation/Lane Closure-Revised 04/28/15)

Required
 Completed/Received

Today's Date: 10/16/17

Permit Number: WJ-1243

Company: STK Utility Svcs

Applicant: Melissa Gonzalez

Work Site Address: 17090-114 Planters Row

Receive from applicant the following information:

- Performance and Maintenance Bond
- Proof of Insurance
- Traffic Control Plan
- Other: _____

Payment:

- No fee, Franchise (Oncor or Atmos) CTP (AT&T, Spectrum, etc.) Waived (work for Town)
- Collect \$50.00 Application Fee
- Connection Fees \$ _____

Complete a receipt

- Write permit number on receipt
- Record receipt information on the application at the bottom of the page
- Make a copy of receipt

Complete the "Picked Up By" portion of the Application at the bottom of the page

Make _____ copies of Permit Application (Page 2 &-if used-Page 3). If both - single side to double-side.

Give to Customer:

- Receipt
- 1 copy of Permit Application - Pages 1-3 Stamped
- Permit Placard (blue card)
- Other: _____

Give to ~~Days~~ Scan

- Original Permit Application
- 1 copies of Permit Application
- Submitted plans (1 copies)
- Copy of Permit Placard (blue card)
- Bond
- TCP
- Proof of Insurance
- Other: _____

Other notes: _____

Completed by: BOF Date: 10-19