

FOR ADDISON USE ONLY	
Permit Number:	<u>W-1272</u>
Location:	<u>9106 Riva</u>

APPLICATION
Right of Way Work Permit -FRANCHISE
 (For Franchise Utility/CTP - Street Cut/Excavation/Lane Closure)

Sub-Contractor List

PLEASE PRINT LEGIBLY

General Contractor's Name: Tenex Construction General Contractor's Phone #: 972-913-8883

Sub-Contractor #1 Company Name: Magdalena Alvarez Address: _____

Print Sub-Contractor's Name: Magdalena Alvarez Sub-Contractor's Phone #: 972-872-5271

Sub-Contractor's E-Mail: _____

Print Site Supervisor's Name: Rocky Stockman Supervisor's Phone #: 214-202-9093

Site Supervisor's E-Mail: _____

Insurance Provided? Yes No On File

Sub-Contractor #2 Company Name: Ascension Rodriguez Address: _____

Print Sub-Contractor's Name: Ascension Rodriguez Sub-Contractor's Phone #: 972-394-0971

Sub-Contractor's E-Mail: _____

Print Supervisor's Name: Rocky Stockman Supervisor's Phone #: 214-202-9093

Site Supervisor's E-Mail: _____

Insurance Provided? Yes No On File

Sub-Contractor #3 Company Name: Tomacito Espinal Address: _____

Print Sub-Contractor's Name: Tomacito Espinal Sub-Contractor's Phone #: 1-214-218-5271

Sub-Contractor's E-Mail: _____

Print Supervisor's Name: Rocky Stockman Supervisor's Phone #: 214-202-9093

Site Supervisor's E-Mail: _____

Insurance Provided? Yes No On File

TOWN OF ADDISON INFRASTRUCTURE AND DEVELOPMENT SERVICES
 DEPARTMENT ATTN.: RIGHT OF WAY PERMIT - DAVE WILDE 972-450-2847
 16801 WESTGROVE RD. ADDISON, TX 75001-9010
 PHONE: 972-450-2871 FAX: 972-450-2837



FOR ADDISON USE ONLY	
Permit Number:	<u>W-1272</u>
Location:	<u>4106 Rive</u>

APPLICATION

Right of Way Work Permit -FRANCHISE

(For Franchise Utility/CTP - Street Cut/Excavation/Lane Closure)

PLEASE PRINT LEGIBLY

Date of Application: 11/14/17

Facility Owner Company: AT&T Company Phone #: 800-924-9420

Utility/CTP Representative: Susan Esquivel Cell Phone #: 214-467-8276

Utility/CTP Representative E-Mail: _____

General Contractor: Tenex Construction Company Phone #: 972-913-8883

Site Supervisor Name: Rocky Stockman 24-hour phone #: 214-202-9093

Contractor E-Mail address: Rocky@tenexconstruction.com Site Foreman E-Mail: _____

Work Site Address and Location: 4106 RIVE LN

Purpose and general description of work: Placement of Phone Service Drop

Proposed Start Work Date: 11/15/17 Estimated Completion Date: 11/29/17

Pavement Cut? Yes No Directional Bore/Boring? Yes No

Excavation? Yes No Lane Closure? Yes No Other: _____? Yes No

Kim Hines Kim Hines Office Manager
Applicant's Printed Name Signature Position with Company

Applicant's Email: Kim@tenexconstruction.com Applicant's Phone Number: 972-913-883


Rocky Stockman 214-202-9093 Tenex Construction
Direct Supervisor's Printed Name Phone Number Company Name

Supervisor's E-Mail: _____


FOR ADDISON USE ONLY	
Received By: <u>Maree S.</u>	Entered? <input type="checkbox"/> Yes <input type="checkbox"/> No
Approved By: <u>Dave Wilde</u>	Received Date: <u>11/14/17</u>
Inspector: <u>JE</u>	Issue Date: <u>11/15/17</u>
Plans Submitted? <input checked="" type="checkbox"/> Yes <input type="checkbox"/> No <input type="checkbox"/> N/A	Traffic Control Plan Submitted? <input type="checkbox"/> Yes <input checked="" type="checkbox"/> No <input type="checkbox"/> N/A
Expiration Date: <u>12/01/17</u>	
Insurance Provided? <input type="checkbox"/> Yes <input type="checkbox"/> No <input checked="" type="checkbox"/> On File	Performance/Maintenance Bond? <input type="checkbox"/> Yes <input type="checkbox"/> No <input type="checkbox"/> On File <input checked="" type="checkbox"/> N/A
Fee Paid: <u>NA</u>	Receipt#: <u>CTP</u>
Date: _____	Processed By: <u>Maree S.</u>
Picked Up By: <u>Rocky</u>	Company: <u>Tenex</u>
Date & Time: _____	

TOWN OF ADDISON INFRASTRUCTURE AND DEVELOPMENT SERVICES
 DEPARTMENT ATTN.: RIGHT OF WAY PERMIT - DAVE WILDE 972-450-2847
 16801 WESTGROVE RD. ADDISON, TX 75001-9010
 PHONE: 972-450-2871 FAX: 972-450-2837

AT&T/Tenex Const
WO 9043185
41106 Rive LN
Addison, Tx

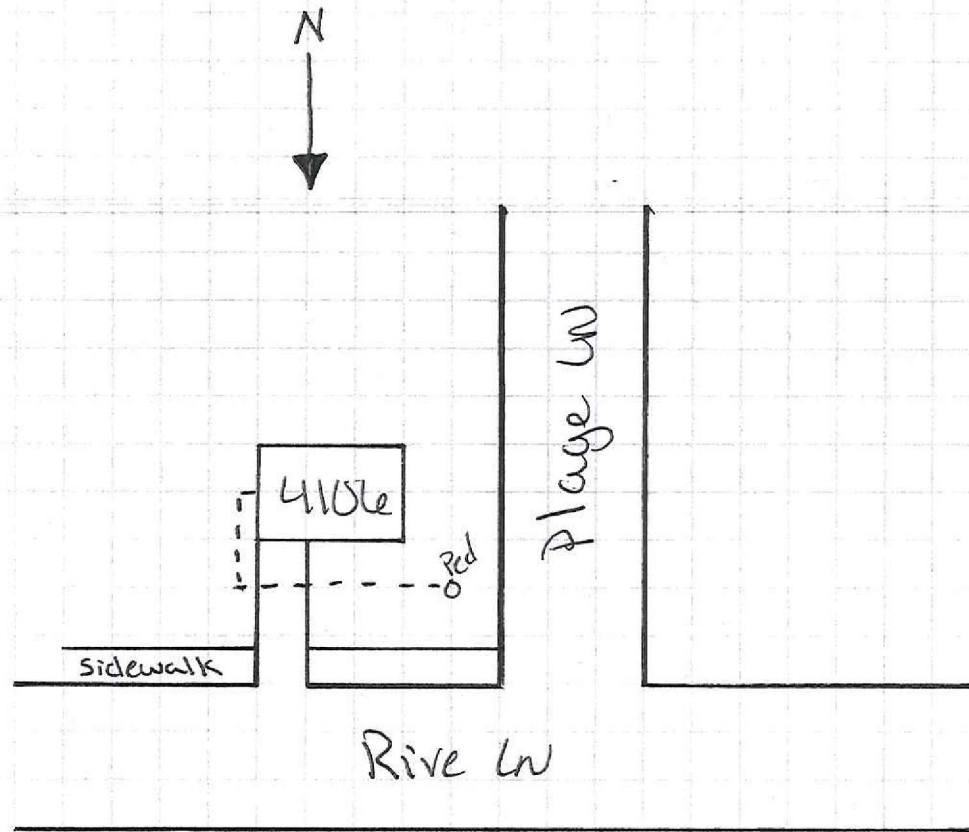

**RIGHT OF WAY, EXCAVATION &
LANE CLOSURE PERMIT**

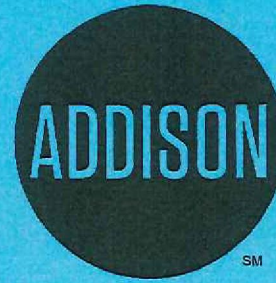

**INFRASTRUCTURE &
DEVELOPMENT SERVICES**

16801 WESTGROVE DRIVE
ADDISON, TEXAS 75001
972.450.2871

W-1272

PERMIT NUMBER

11/15/17

START DATE

11/29/17

EST. COMPLETION DATE

TENEX CONST

CONTRACTOR

AT&T

FOR

4106 RIVE LN

LOCATION (ADDRESS)

FROM PEDESTAL TO HOUSE

LOCATION (ACTUAL)

SERVICE TO ADDRESS

TYPE OF WORK