



**FOR ADDISON USE ONLY**  
 Permit Number: W-1275  
 Location: Kelso Westgrove  
 Revised 2/20/14

**APPLICATION**  
**Right of Way Work Permit-GENERAL**

(General Non-Franchise, Private Development, Work for the Town and Miscellaneous Work)

**PLEASE PRINT LEGIBLY**

Date of application: 4/14/17  
 Property Owner/Developer Name: Logix Communications Company Phone #: 972-978-3962  
 Property Owner Contact Name: Bryan Wilson Phone #: 972-978-3462  
 General Contractor Name: Gardner Telecommunications Phone #: 972-329-9933  
 Site Supervisor Name: Brandon Gafford 24 hour phone #: 469-571-4464  
 Work Site Address and Location: 10650 Westgrove Dr

Purpose and general description of work: Placement of Logix Fibers to new customer  
 Proposed Start Work Date: 11/15/17 Estimated Completion Date: 12/15/17

Pavement Cut?  Yes  No Directional Bore/Boring?  Yes  No Excavation?  Yes  No  
 Lane Closure?  Yes  No Other: \_\_\_\_\_?  Yes  No

Brandon Gafford 469-571-4464 Brandon Gafford Construction Supervisor  
 Applicant's Printed Name Phone Number Signature Position with Company

bgafford@gardner100.com GTI 972-329-9933  
 Applicant's Email Company Name & Phone Number

**FOR ADDISON USE ONLY**

Received By: [Signature] Entered?  Yes  No Received Date: 11-15-17

Approved By: [Signature] Inspector: JF Issue Date: 11/15/17

Plans Submitted?  Yes  No  N/A Traffic Control Plan submitted?  Yes  No  N/A Exp 12/4/17

Insurance Provided?  Yes  No  On File Performance/Maintenance Bond?  Yes  No  On File  N/A

<input type="checkbox"/> WA	<input type="checkbox"/> SW	.....	Number Of Connections	Size	@\$	each = \$
<input type="checkbox"/> WA	<input type="checkbox"/> SW	.....	Number Of Connections	Size	@\$	each = \$
<input type="checkbox"/> WA	<input type="checkbox"/> SW	.....	Number Of Connections	Size	@\$	each = \$
<input type="checkbox"/> WA	<input type="checkbox"/> SW	.....	Number Of Connections	Size	@\$	each = \$
<input type="checkbox"/> Other (Description)						= \$
Total						\$

Fee Paid: NA Receipt#: CTP Date: 11-17-17 Processed By: [Signature]  
 Picked Up By: [Signature] Company: GTI Date & Time: 11-17-17

TOWN OF ADDISON INFRASTRUCTURE OPERATIONS AND SERVICES DEPARTMENT  
 ATTN.: RIGHT OF WAY PERMIT - DAVE WILDE 972-450-2847  
 16801 WESTGROVE RD. ADDISON, TX 75001-9010  
 PHONE: 972-450-2871 FAX: 972-450-2837



FOR ADDISON USE ONLY  
Permit Number: W-1275  
Location: 1665 Westgrove  
Revised 2/20/14

**APPLICATION**

**Right of Way Work Permit-GENERAL**

(General Non-Franchise, Private Development, Work for the Town and Miscellaneous Work)

**Sub-Contractor List**

**PLEASE PRINT LEGIBLY**

General Contractor's Name: GTI General Contractor's Phone #: 972-329-9933

Sub-Contractor #1 Company Name: Customized Technicians Address: \_\_\_\_\_

Print Sub-Contractor's Name: Chris Clouse Sub-Contractor Phone #: \_\_\_\_\_

Print Site Supervisor's Name: Chris Clouse 24 Hour Telephone #: 214-242-6258

Insurance Provided? Yes No On File

Sub-Contractor #2 Company Name: \_\_\_\_\_ Address: \_\_\_\_\_

Print Sub-Contractor's Name: \_\_\_\_\_ Sub-Contractor Phone #: \_\_\_\_\_

Print Site Supervisor's Name: \_\_\_\_\_ 24 Hour Telephone #: \_\_\_\_\_

Insurance Provided? Yes No On File

Sub-Contractor #3 Company Name: \_\_\_\_\_ Address: \_\_\_\_\_


Print Sub-Contractor's Name: \_\_\_\_\_ Sub-Contractor Phone #: \_\_\_\_\_

Print Site Supervisor's Name: \_\_\_\_\_ 24 Hour Telephone #: \_\_\_\_\_

Insurance Provided? Yes No On File

TOWN OF ADDISON INFRASTRUCTURE OPERATIONS AND SERVICES DEPARTMENT  
ATTN.: RIGHT OF WAY PERMIT - DAVE WILDE 972-450-2847  
16801 WESTGROVE RD. ADDISON, TX 75001-9010  
PHONE: 972-450-2871 FAX: 972-450-2837

RIGHT OF WAY, EXCAVATION &  
LANE CLOSURE PERMIT

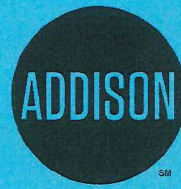

INFRASTRUCTURE &  
DEVELOPMENT SERVICES

16801 WESTGROVE DRIVE  
ADDISON, TEXAS 75001  
972.450.2871

**W-1275**

PERMIT NUMBER

**11/16/17**

START DATE

**12/15/17**

EST. COMPLETION DATE

**GTI**

CONTRACTOR

**LOGIX**

FOR

**16650 WESTGROVE DR**

LOCATION (ADDRESS)

**FROM POLE IN EASEMENT TO REAR OF ADDRESS**

LOCATION (ACTUAL)

**PLACE NEW FIBER FOR CUSTOMER SERVICE**


TYPE OF WORK

THIS CARD MUST BE DISPLAYED ON THE JOB SITE AT ALL TIMES.

# LOGIX

## WESTGROVE FIBER PARK ADDISON, TEXAS

VICINITY MAP

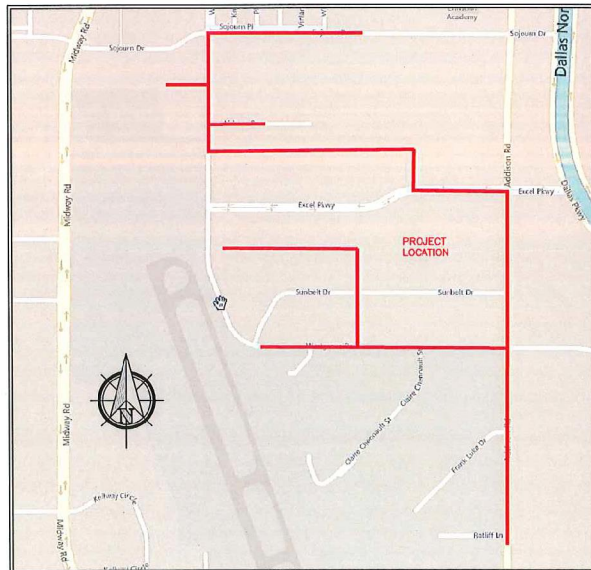

### GENERAL PROJECT NOTES

1. ALL CONSTRUCTION WORK WITHIN THE PUBLIC RIGHT-OF-WAY SHALL BE DONE IN ACCORDANCE WITH THE ORDINANCES AND REGULATIONS OF THE MUNICIPALITY IN WHICH THE WORK IS TO BE PERFORMED.
2. EXISTING UTILITY LOCATIONS SHOWN ARE TAKEN FROM AVAILABLE RECORDS AND MAY NOT BE ALL INCLUSIVE. UTILITY LOCATIONS ARE GENERALLY SCHEMATIC IN NATURE AND MAY NOT ACCURATELY REFLECT THE SIZE AND LOCATION OF EACH PARTICULAR UTILITY. THE CONSTRUCTION CONTRACTOR SHALL ASSUME RESPONSIBILITY FOR ACTUAL LINE LOCATES IN THE FIELD AND THE PROTECTION OF ALL EXISTING FACILITIES WHETHER SHOWN OR NOT. THE CONSTRUCTION CONTRACTOR SHALL ALSO ASSUME RESPONSIBILITY FOR REPAIRS TO ANY EXISTING FACILITY DAMAGED AS A DIRECT RESULT OF THE CONSTRUCTION ACTIVITIES WHETHER THE FACILITY IS SHOWN ON THE DRAWINGS OR NOT.
3. THE CONSTRUCTION CONTRACTOR SHALL BE RESPONSIBLE FOR CONTACTING ALL DEPARTMENTS WITHIN THE MUNICIPALITY AND THE UTILITY COMPANIES AT LEAST TWO WORKING DAYS PRIOR TO THE COMMENCEMENT OF WORK.

CALL BEFORE YOU DIG

811

IT'S THE LAW




4. IT SHALL BE THE RESPONSIBILITY OF THE CONSTRUCTION CONTRACTOR TO: A) PREVENT DAMAGE TO PRIVATE AND PUBLIC PROPERTY. B) RESTORE ALL AREAS EFFECTED BY THE CONSTRUCTION TO ORIGINAL OR BETTER CONDITION.
5. BARRICADING AND TRAFFIC CONTROL SHALL BE THE RESPONSIBILITY OF THE CONSTRUCTION CONTRACTOR AND SHALL CONFORM TO THE "TEXAS MANUAL ON UNIFORM TRAFFIC CONTROL DEVICES". TRAFFIC FLOW AND ACCESS SHALL BE MAINTAINED DURING ALL PHASES OF CONSTRUCTION. THE CONSTRUCTION CONTRACTOR IS RESPONSIBLE FOR PROVIDING TRAFFIC SAFETY MEASURES FOR WORK ON THE PROJECT. THE WORK SITE SHALL BE SUITABLY LIT AND BARRICADED AT NIGHT.
6. THE CONSTRUCTION CONTRACTOR SHALL ABIDE BY ALL APPLICABLE FEDERAL, STATE AND LOCAL LAWS GOVERNING EXCAVATION. THE CONSTRUCTION CONTRACTOR SHALL PROVIDE ALL TRENCH SAFETY SYSTEMS THAT COMPLY WITH ALL LAWS GOVERNING EXCAVATION. THE CONSTRUCTION CONTRACTOR SHALL BE SOLELY RESPONSIBLE FOR ALL ASPECTS OF WORK RELATED TO EXCAVATION.
7. ALL CONCRETE USED IN ANY ROADWAY SHALL BE IN COMPLIANCE WITH THE SPECIFIED CLASSES OF CONCRETE IN THE STANDARD SPECIFICATIONS 5.8 "PORTLAND CEMENT CONCRETE PAVEMENT" AND 7.4.5 "QUALITY OF CONCRETE" AS AMENDED BY THE ADDENDUM TO THE NORTH CENTRAL TEXAS STANDARD SPECIFICATIONS FOR PUBLIC WORKS CONSTRUCTION - 2004. ALL OTHER CONCRETE SHALL BE CLASS A CONCRETE.
8. ALL REINFORCING STEEL AND DOWEL BARS IN PAVEMENT SHALL BE SUPPORTED AND MAINTAINED AT THE CORRECT CLEARANCES BY THE USE OF BAR CHAINS OR OTHER APPROVED SUPPORT.
9. ALL CONDUIT MUST BE PLACED WITH A MINIMUM 42" OF COVER, UNLESS OTHERWISE SPECIFIED.
10. ALL BACKFILLING WILL BE MECHANICALLY TAMPED IN LIFTS TO A DENSITY OF 95% PROCTOR. THE REQUIRED DENSITY WILL BE OBTAINED BY USING TAMPERS, RAMMERS OR ROLLING EQUIPMENT. LIFTS MAY VARY ACCORDING TO THE TYPE OF EQUIPMENT USED TO OBTAIN THE REQUIRED DENSITY. SAND AND DEBRIS FREE MATERIAL WILL BE USED FOR BACKFILL.

DFWT CONTACT: DAVID HATTON 972.670.2113

PREPARED BY: DFW TELECOM, INC.

**LEGEND**

UG	PROPOSED CONDUIT
XX' BORE	BORE UNDER CONCRETE
---	EXISTING CONDUIT
---	EXISTING CUSTOMER CONDUIT
PP XX' PP	OVERHEAD: NEW BUILD
PP XX' PP	OVERHEAD: OVERLASH

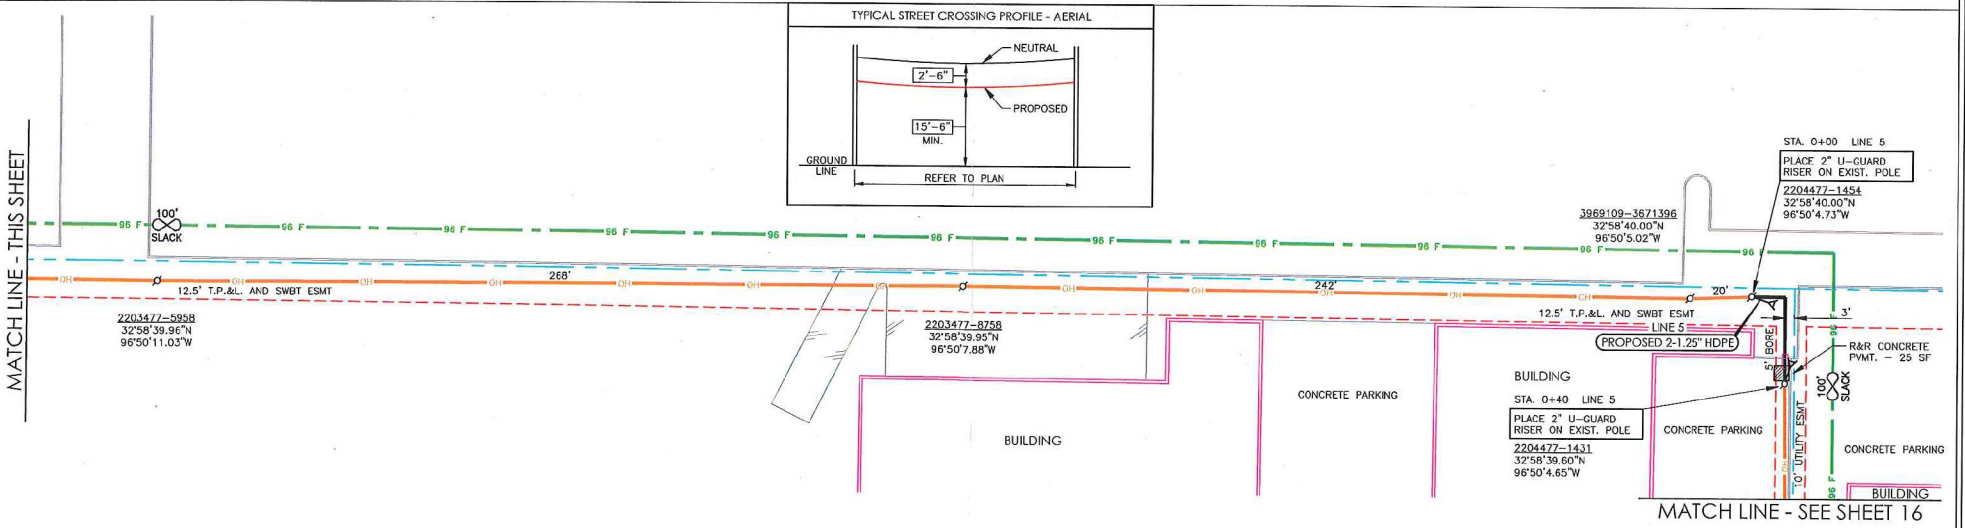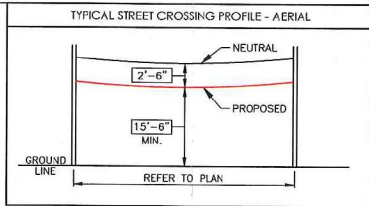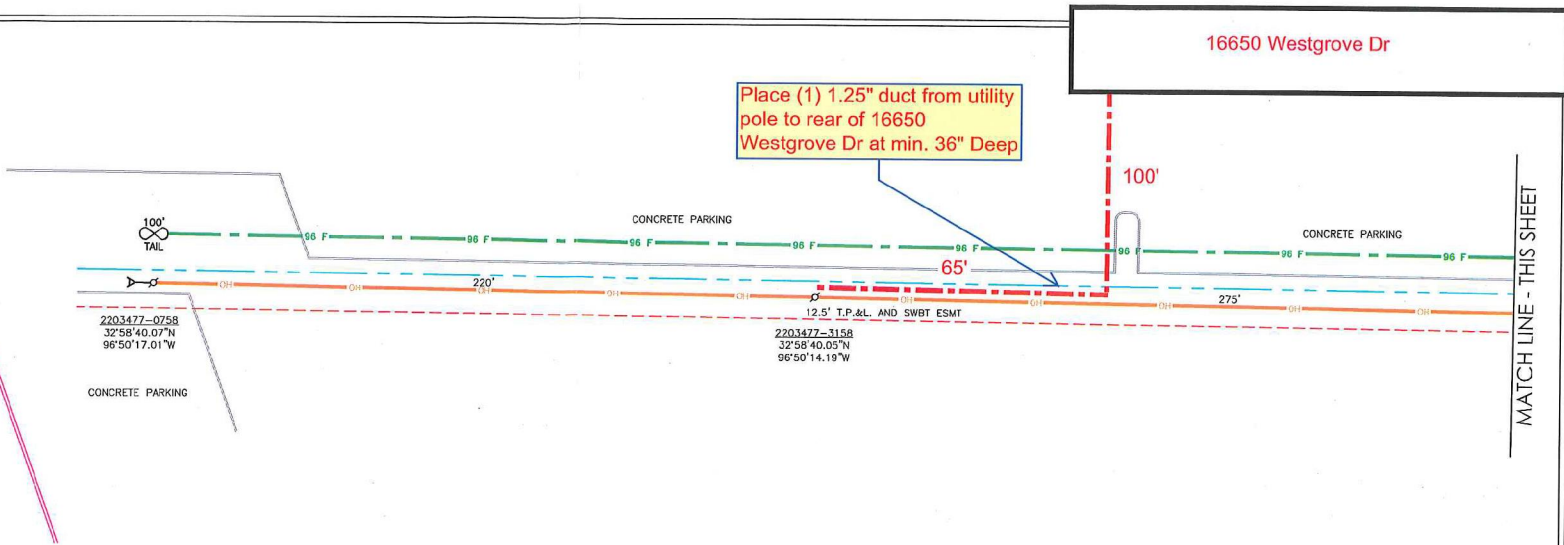

PREPARED BY:

DFWT CONTACT:  
DAVID HATTON 972.670.2113

**ESTIMATED SHEET TOTALS**

DESCRIPTION	QUANTITY	DESCRIPTION	QUANTITY
TRENCH & PLACE CONDUIT	35'	PLACE DURA VAULT	
BORE & PLACE CONDUIT	5'	PLACE PEDESTAL	
BORE & PLACE STEEL CASING		PLACE 3' X 5' X 4' HANDHOLE	
PULL THROUGH EXISTING CONDUIT		PLACE WALL BOX	
R & R CONCRETE SIDEWALK (SF)	25	PLACE DOWN GUY & ANCHOR	3
R & R CONCRETE PAVEMENT (SF)		PLACE 2" U-GUARD RISER	2
AERIAL: OVERLASH		AERIAL: NEW BUILD	1025'

NORTH

SHEET  
15 OF 16

PROJECT: WESTGROVE FIBER PARK

ADDRESS: N/A

CITY, STATE: ADDISON, TEXAS

HORIZONTAL SCALE 1" = 40'	VERTICAL SCALE 1" = 10'	DATE: 04-22-2016
------------------------------	----------------------------	---------------------