



COPY

| | |
|----------------------|--------------------------|
| FOR ADDISON USE ONLY | |
| Permit Number: | <u>W-1286</u> |
| Location: | <u>14555 Dallas Pkwy</u> |

APPLICATION

Right of Way Work Permit -FRANCHISE

(For Franchise Utility/CTP - Street Cut/Excavation/Lane Closure)

PLEASE PRINT LEGIBLY

Date of Application: 12-5-17

Facility Owner Company: ONCOR Company Phone #: 469-261-5255

Utility/CTP Representative: Rick Fielding Cell Phone #: 469-261-5255

Utility/CTP Representative E-Mail: Rick.Fielding@ONCOR.com

General Contractor: _____ Company Phone #: _____

Site Supervisor Name: Brian McDaniel 24-hour phone #: 469-964-1817

Contractor E-Mail address: _____ Site Foreman E-Mail: Robert.McDaniel@ONCOR.com

Work Site Address and Location: Cawley Center - S. OF LANDMARK BLVD.

Purpose and general description of work: INSTALL Pole

Proposed Start Work Date: 12-11-17 Estimated Completion Date: 01-15-18

Pavement Cut? Yes No Directional Bore/Boring? Yes No

Excavation? Yes No Lane Closure? Yes No Other: _____ ? Yes No

Applicant's Printed Name: Rick Fielding Signature: [Signature] Position with Company: PROJECT MANAGER

Applicant's Email: Rick.Fielding@ONCOR.com Applicant's Phone Number: 469-261-5255

Direct Supervisor's Printed Name: WAYNE MINTS Phone Number: 214-486-5017 Company Name: ONCOR

Supervisor's E-Mail: WAYNE.MINTS@ONCOR.COM

FOR ADDISON USE ONLY

Received By: Nicole S. Entered? Yes No Received Date: 12-5-17

Approved By: [Signature] Inspector: JFIELD Issue Date: 12/5/17


Plans Submitted? Yes No N/A Traffic Control Plan Submitted? Yes No N/A Expiration Date: 12/22/17

Insurance Provided? Yes No On File Performance/Maintenance Bond? Yes No On File N/A

Fee Paid: NA Receipt#: FRANCHISE Date: _____ Processed By: _____

Picked Up By: [Signature] Company: ONCOR Date & Time: 12-11-17 9:35 AM

TOWN OF ADDISON INFRASTRUCTURE AND DEVELOPMENT SERVICES
DEPARTMENT ATTN.: RIGHT OF WAY PERMIT - DAVE WILDE 972-450-2847
16801 WESTGROVE RD. ADDISON, TX 75001-9010
PHONE: 972-450-2871 FAX: 972-450-2837

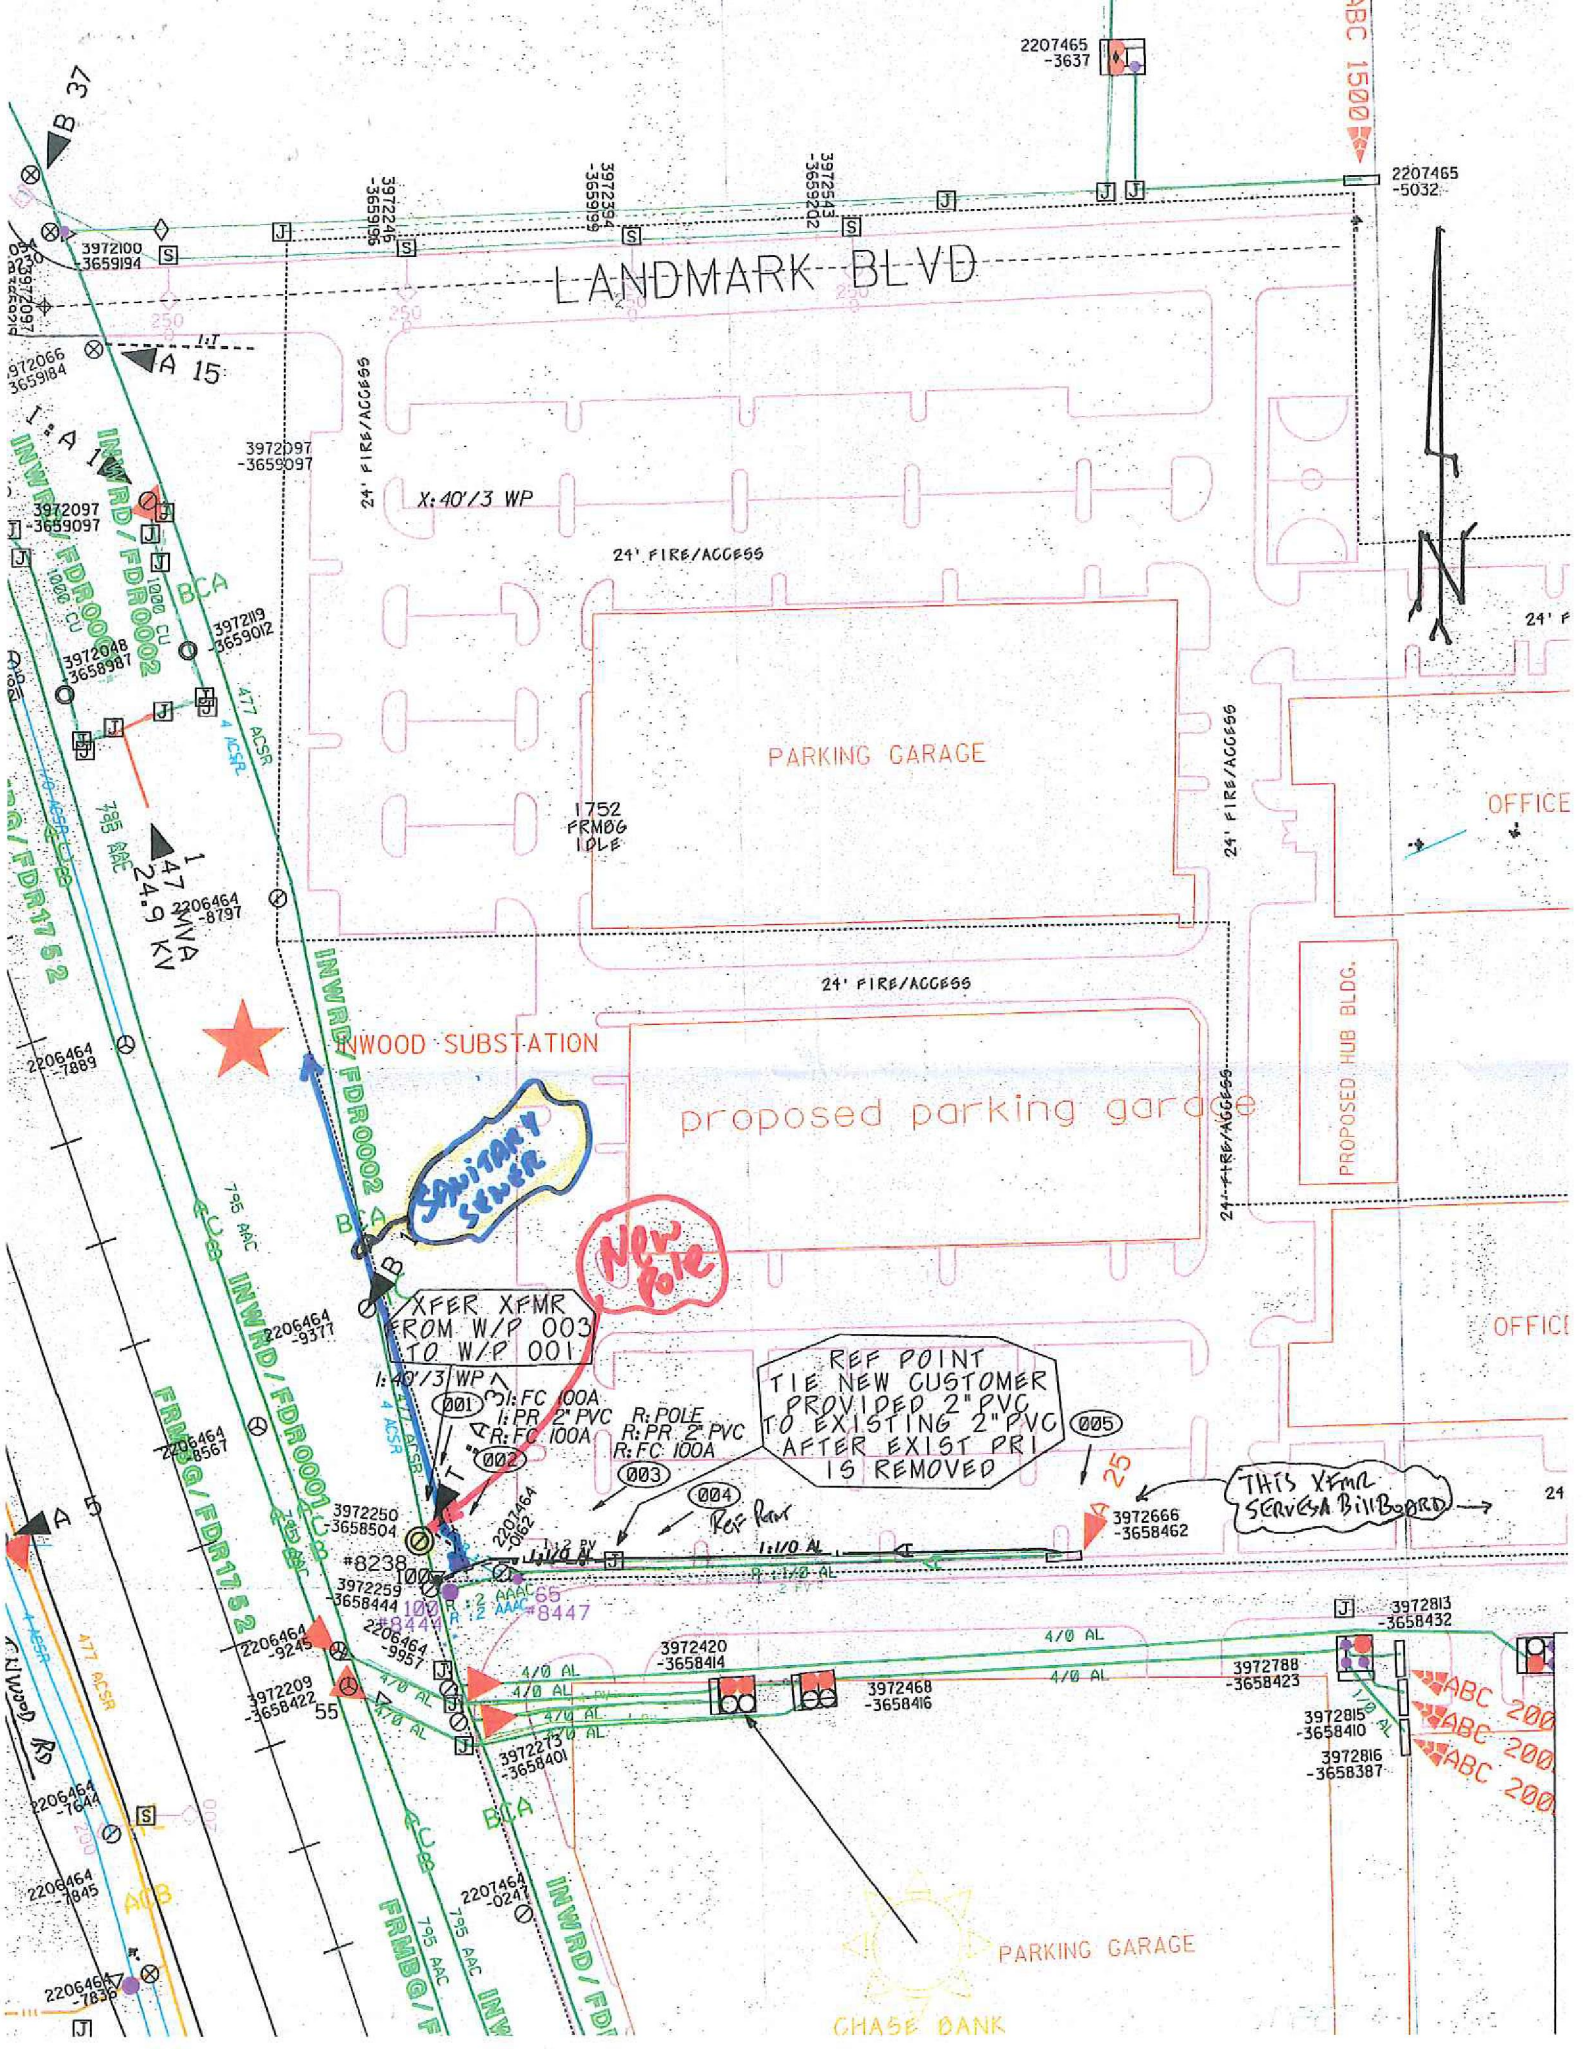

LANDMARK BLVD

X: 40' / 3 WP

24' FIRE/ACCESS

PARKING GARAGE

1752 FRMOG IDLE

24' FIRE/ACCESS

WOOD SUBSTATION

proposed parking garage

PROPOSED HUB BLDG.

OFFICE

OFFICE

Sanitary Sewer

New Pole

REF POINT TIE NEW CUSTOMER PROVIDED 2" PVC TO EXISTING 2" PVC AFTER EXIST PRI IS REMOVED

THIS Xfmr SERVES A Billboard

XFER XFMR FROM W/P 003 TO W/P 001

1: 40' / 3 W/P
 P: FC 100A
 L: PR 2" PVC
 R: FC 100A

R: POLE
 R: PR 2" PVC
 R: FC 100A

#8238
 #8447

3972420 -3658414

3972468 -3658416

3972788 -3658423

3972815 -3658410


3972816 -3658387

ABC 200
 ABC 200
 ABC 200

CHASE BANK

PARKING GARAGE

**RIGHT OF WAY, EXCAVATION &
LANE CLOSURE PERMIT**

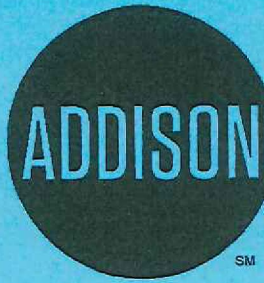

**INFRASTRUCTURE &
DEVELOPMENT SERVICES**

16801 WESTGROVE DRIVE
ADDISON, TEXAS 75001
972.450.2871

W-1286

PERMIT NUMBER

12/11/17

START DATE

01/15/18

EST. COMPLETION DATE

ONCOR

CONTRACTOR

ONCOR

FOR

14555 DALLAS PARKWAY

LOCATION (ADDRESS)

ALONG EASEMENT AT SW CORNER OF PROPERTY

LOCATION (ACTUAL)

INSTALL NEW POLE

TYPE OF WORK

THIS CARD MUST BE DISPLAYED ON THE JOB SITE AT ALL TIMES.