



FOR ADDISON USE ONLY

Permit Number: W-1278
Location: 4309 Lindbergh

APPLICATION

Right of Way Work Permit-FRANCHISE

(For Franchise Utility/CTP - Street Cut/Excavation/Lane Closure)

PLEASE PRINT LEGIBLY

Date of Application: 11/17/2017
Facility Owner Company: AT&T Company Phone #: 972-470-7238
Utility/CTP Representative: GREG ALLMON Cell Phone #: 972-743-8656
Utility/CTP Representative E-mail: GAY118@ATT.COM
General Contractor: BARKER UTILITY Company Phone # 817-455-8244
Site Supervisor Name: JAMES BARKER 24-hour Phone # 817-455-8244
Contractor E-mail: _____ Site Foreman E-mail: _____
Work Site Address and Location: 4309 LINDBERGH BLVD, ADDISON, TX

Purpose and general description of work: Bury from P4200B to cust, bore under Lindbergh Dr

Proposed Start Work Date: 11/20/2017 Estimated Completion Date: 12/19/17

Pavement Cut? Yes No Directional Bore/Boring? Yes No Excavation? Yes No
Lane Closure? Yes No Other: _____

STEVE ELLIOTT [Signature] DESIGN ENGINEER
Applicant's Printed Name Signature Position with Company

Applicant's E-mail: SE2157@ATT.COM Applicant's Phone #: 972-470-7238

Robert A. Hall 903-457-2221 AT&T - TEXAS
Direct Supervisor's Name Phone Number Company Name

Supervisor's E-mail: RH8425@ATT.COM

FOR ADDISON USE ONLY

Received By: [Signature] Entered? Yes No Received Date: 4/17/17

Approved By: [Signature] Inspector: JF Issue Date: 4/20/17

Plans Submitted? Yes No N/A Traffic Control Plan submitted? Yes No N/A Expiration Date: 12/6/17

Insurance Provided? Yes No On File Performance/Maintenance Bond? Yes No On File N/A

Fee Paid: NA Receipt #: CTP Processed By: [Signature]

Picked Up By: Terry Company: Barker Date & Time: 12-1-17 1:48 PM

TOWN OF ADDISON INFRASTRUCTURE AND DEVELOPMENT SERVICES DEPARTMENT
ATTN.: RIGHT OF WAY PERMIT - DAVE WILDE 972-450-2847
16801 WEST GROVE RD, ADDISON, TX 75001-8010
PHONE: 972-450-2871 FAX: 972-450-2837

RIGHT OF WAY, EXCAVATION &
LANE CLOSURE PERMIT



INFRASTRUCTURE &
DEVELOPMENT SERVICES

16801 WESTGROVE DRIVE
ADDISON, TEXAS 75001
972.450.2871

W-1278

PERMIT NUMBER

11/20/17

START DATE

12/19/17

EST. COMPLETION DATE

BARKER UTILITY

CONTRACTOR

AT&T

FOR

4309 LINDBERGH

LOCATION (ADDRESS)

FROM P4200B TO CUSTOMER


LOCATION (ACTUAL)

BORE UNDER LINDBERGH FOR SERVICE TO ADDRESS

TYPE OF WORK

THIS CARD MUST BE DISPLAYED ON THE JOB SITE AT ALL TIMES.



8066200

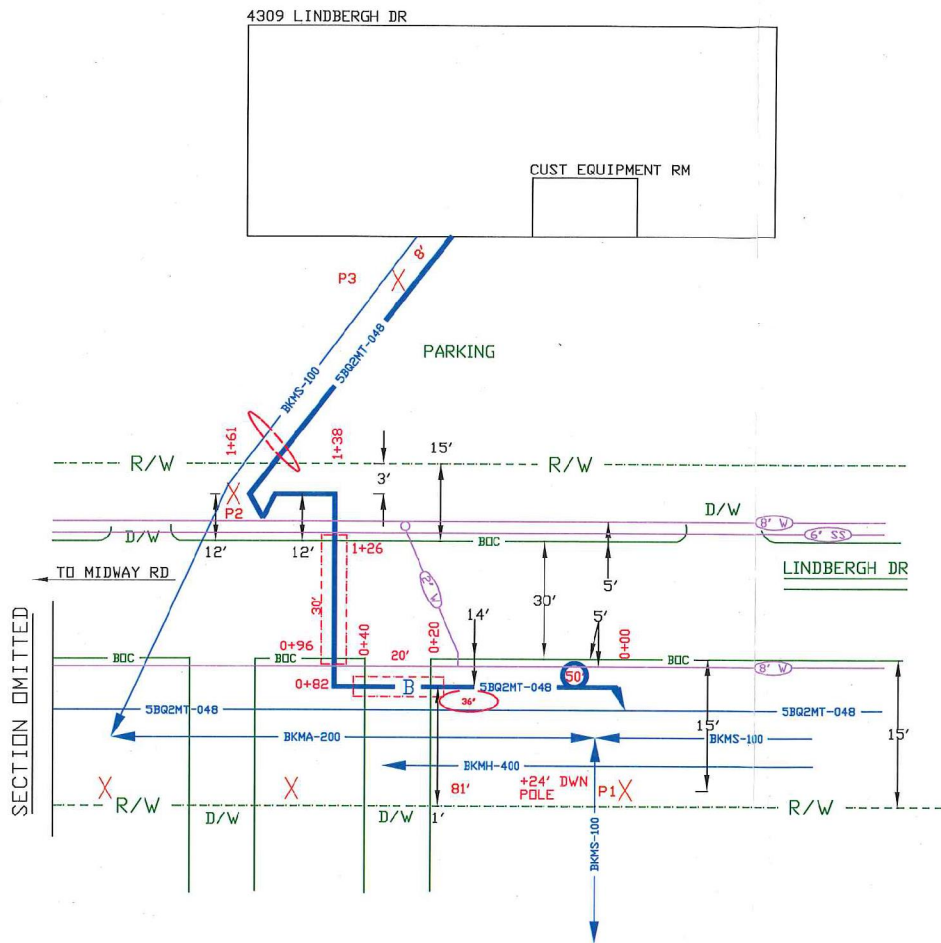

P1 4200B
UNK
ATT @ 20' 4"

P2 2203 470 5442
UNK-4
ATT @ 23' 11"

P3 2203 470 5851
40'-3
ATT @ 19' 1"

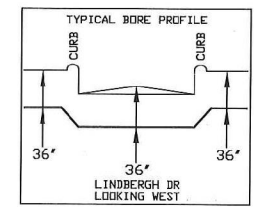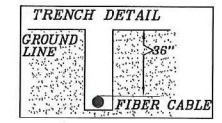

SPECIAL CIRCUITS N
6203 FORWARDED N
PERMIT REQUIRED N



OPERATING RANGE OF JOB STEPS
TASK 1 TO 5
MFRC 022C

TRANSMISSION ZONE
RZ 0 CZ 0 TAPER CODE 44302

CAUTION HIGH VOLTAGE
KV 7.20 AERIAL Y BURIED N

HIGHWAY PERMIT NO.

Utility CO DEIC - ONCOR ELECTRIC DELIVERY C
REP NAME DISPATCH
REP TEL NO. (800) 666-2614
POLE CONTACTS (+) 0 (-) 0

Utility CO
REP NAME
REP TEL NO.
POLE CONTACTS (+) 0 (-) 0

Utility CO
REP NAME
REP TEL NO.
POLE CONTACTS (+) 0 (-) 0

PROJECT NO A0155H5

TOT.PRINTS 5 PRINT NO. 4
NPA/NNX: 972-239 PRT:972239
EXCH. ADDISON
TAX DIST. DB007
GEO LOC. TM8239
ENGR. SEX DRAWN DK
TELEPHONE NO. (972) 470-7238
REC. REF. 697-645-66
MAP REF. F-14C
SCALE NONE
ISSUE DATE 10/18/2017
PROJ TITLE 4309 LINDBERGH BLVD-535982
REV. NUMBER 1
DATE REV. 11/17/2017

--Proprietary--
Not for use or disclosure outside the AT&T companies except under written agreement.