

FOR ADDISON USE ONLY
 Permit Number: W-1351
 Location: 4004-08 Bobbin

APPLICATION
Right of Way Work Permit -FRANCHISE
 (For Franchise Utility/CTP - Street Cut/Excavation/Lane Closure)

PLEASE PRINT LEGIBLY

Date of Application: 3/21/18
 Facility Owner Company: AT+T Company Phone #: 800-924-9420
 Utility/CTP Representative: Susan Esquivel Cell Phone #: 214-467-8276
 Utility/CTP Representative E-Mail: _____
 General Contractor: Tenex Construction Company Phone #: 972-913-8883
 Site Supervisor Name: Rocky Stockman 24-hour phone #: 214-202-9093
 Contractor E-Mail address: Rocky@tenexconstruction.com Site Foreman E-Mail: _____

Work Site Address and Location: 4004 AND 4008 BOBBIN LN
 Purpose and general description of work: Placement of Phone Service Drop
 Proposed Start Work Date: 3/23/18 Estimated Completion Date: 4/6/18


Pavement Cut? Yes No Directional Bore/Boring? Yes No
 Excavation? Yes No Lane Closure? Yes No Other: _____ ? Yes No
Kim Hines Kim Hines Office Manager
 Applicant's Printed Name Signature Position with Company

Applicant's Email: Kim@tenexconstruction.com Applicant's Phone Number: 972-913-8883
Rocky Stockman 214-202-9093 Tenex Construction
 Direct Supervisor's Printed Name Phone Number Company Name
 Supervisor's E-Mail: _____

FOR ADDISON USE ONLY

Received By: Mered S. Entered? Yes Received Date: 3-21-18
 Approved By: Dave Wilde Inspector: JF Issue Date: 3/23/18
 Plans Submitted? Yes No N/A Traffic Control Plan Submitted? Yes No N/A Expiration Date: 4/09/18
 Insurance Provided? Yes No On File Performance/Maintenance Bond? Yes No On File N/A
 Fee Paid: NA Receipt#: CTP Date: 3-29-18 Processed By: Mered S.
 Picked Up By: Rocky Company: Tenex Date & Time: 2:18AM

TOWN OF ADDISON INFRASTRUCTURE AND DEVELOPMENT SERVICES
 DEPARTMENT ATTN.: RIGHT OF WAY PERMIT - DAVE WILDE 972-450-2847
 16801 WESTGROVE RD. ADDISON, TX 75001-9010
 PHONE: 972-450-2871 FAX: 972-450-2837

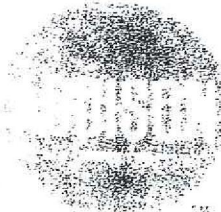

FOR ADDISON USE ONLY
 Permit Number: W-1357
 Location: 40044008 Bebbin

APPLICATION
Right of Way Work Permit -FRANCHISE
 (For Franchise Utility/CTP - Street Cut/Excavation/Lane Closure)

Sub-Contractor List

PLEASE PRINT LEGIBLY

General Contractor's Name: Tenex Construction General Contractor's Phone #: 972-913-8883

Sub-Contractor #1 Company Name: Magdalena Alvarez Address: _____
 Print Sub-Contractor's Name: Magdalena Alvarez Sub-Contractor's Phone #: 972-872-5271
 Sub-Contractor's E-Mail: _____

Print Site Supervisor's Name: Rocky Stockman Supervisor's Phone #: 214-202-9093
 Site Supervisor's E-Mail: _____

Insurance Provided? Yes No On File

Sub-Contractor #2 Company Name: Ascension Rodriguez Address: _____
 Print Sub-Contractor's Name: Ascension Rodriguez Sub-Contractor's Phone #: 972-394-0971
 Sub-Contractor's E-Mail: _____

Print Supervisor's Name: Rocky Stockman Supervisor's Phone #: 214-202-9093
 Site Supervisor's E-Mail: _____

Insurance Provided? Yes No On File


Sub-Contractor #3 Company Name: Tomacito Espinal Address: _____
 Print Sub-Contractor's Name: Tomacito Espinal Sub-Contractor's Phone #: 1-214-218-5271
 Sub-Contractor's E-Mail: _____

Print Supervisor's Name: Rocky Stockman Supervisor's Phone #: 214-202-9093
 Site Supervisor's E-Mail: _____

Insurance Provided? Yes No On File

TOWN OF ADDISON INFRASTRUCTURE AND DEVELOPMENT SERVICES
 DEPARTMENT ATTN.: RIGHT OF WAY PERMIT - DAVE WILDE 972-450-2847
 16801 WESTGROVE RD. ADDISON, TX 75001-9010
 PHONE: 972-450-2871 FAX: 972-450-2837

AT&T / TENEX CONSTRUCTION
WO#: 9425809 & 972239
4004 & 4008 BOBBIN LN
ADDISON, TX

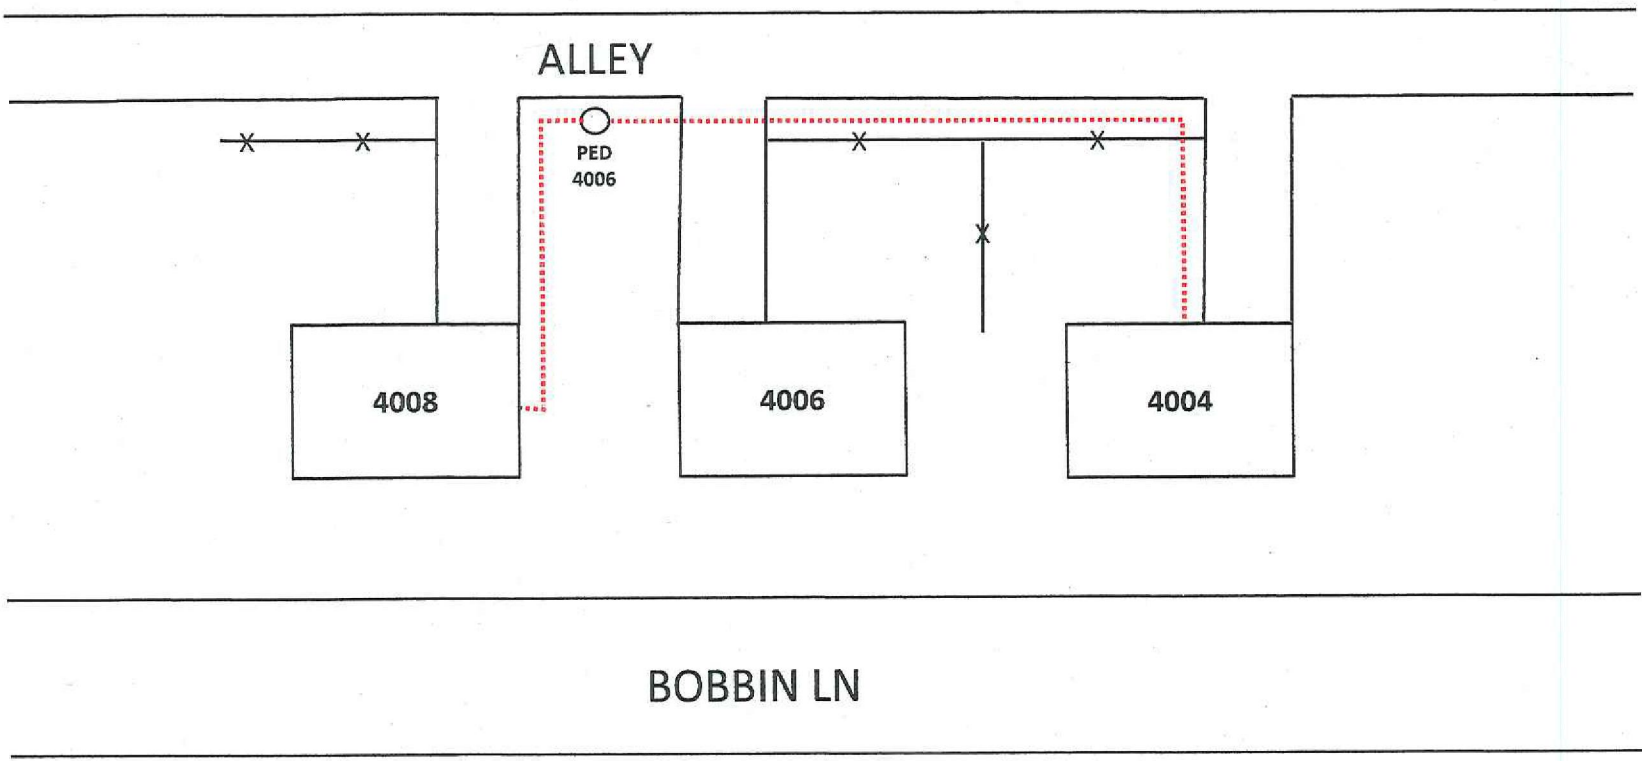

**RIGHT OF WAY, EXCAVATION &
LANE CLOSURE PERMIT**

W-1351

PERMIT NUMBER

3/26/18

START DATE

4/06/18

EST. COMPLETION DATE



**INFRASTRUCTURE &
DEVELOPMENT SERVICES**

16801 WESTGROVE DRIVE
ADDISON, TEXAS 75001
972.450.2871

TENEX CONST AT&T

CONTRACTOR

FOR

4004 & 4008 BOBBIN LANE

LOCATION (ADDRESS)

IN ALLEY, FROM PEDESTAL AT 4006 TO EACH ADDRESS

LOCATION (ACTUAL)

PLACE PHONE SERVICE DROP

TYPE OF WORK

THIS CARD MUST BE DISPLAYED ON THE JOB SITE AT ALL TIMES.