



**FOR ADDISON USE ONLY**  
 Permit Number: W-1369  
 Location: 14803 Le Grande

**APPLICATION**  
**Right of Way Work Permit -FRANCHISE**  
 (For Franchise Utility/CTP - Street Cut/Excavation/Lane Closure)

**PLEASE PRINT LEGIBLY**

Date of Application: 4/13/18

Facility Owner Company: AT+T Company Phone #: 800-924-9420  
 Utility/CTP Representative: Susan Esquivel Cell Phone #: 214-467-8276  
 Utility/CTP Representative E-Mail: \_\_\_\_\_

General Contractor: Tenex Construction Company Phone #: 972-913-8883  
 Site Supervisor Name: Rocky Stockman 24-hour phone #: 214-202-9093  
 Contractor E-Mail address: Rocky@tenexconstruction.com Site Foreman E-Mail: \_\_\_\_\_

Work Site Address and Location: 14803 LE GRANDE DR

Purpose and general description of work: Placement of Phone Service Drop

Proposed Start Work Date: 4/16/18 Estimated Completion Date: 4/27/18

Pavement Cut?  Yes  No Directional Bore/Boring?  Yes  No

Excavation?  Yes  No Lane Closure?  Yes  No Other: \_\_\_\_\_ ?  Yes  No

Kim Hines Applicant's Printed Name Kim Hines Signature Office Manager Position with Company

Applicant's Email: Kim@tenexconstruction.com Applicant's Phone Number: 972-913-883  
Rocky Stockman Direct Supervisor's Printed Name 214-202-9093 Phone Number Tenex Construction Company Name

Supervisor's E-Mail: \_\_\_\_\_

**FOR ADDISON USE ONLY**

Received By: Michelle S. Entered?  Yes Received Date: 4-13-18

Approved By: David E. [Signature] Inspector: JK Issue Date: 4/16/18

Plans Submitted?  Yes  No  N/A Traffic Control Plan Submitted?  Yes  No  N/A Expiration Date: 4/30/18

Insurance Provided?  Yes  No  On File Performance/Maintenance Bond?  Yes  No  On File  N/A

Fee Paid: NA Receipt#: CTP Date: 4-18-18 Processed By: Michelle S.

Picked Up By: Rocky Company: Tenex Date & Time: 4-18-18

TOWN OF ADDISON INFRASTRUCTURE AND DEVELOPMENT SERVICES  
 DEPARTMENT ATTN.: RIGHT OF WAY PERMIT - DAVE WILDE 972-450-2847  
 16801 WESTGROVE RD. ADDISON, TX 75001-9010  
 PHONE: 972-450-2871 FAX: 972-450-2837

8:32 AM



FOR ADDISON USE ONLY  
 Permit Number: W-1369  
 Location: 14803 LEGRANDE

**APPLICATION**  
**Right of Way Work Permit -FRANCHISE**  
 (For Franchise Utility/CTP - Street Cut/Excavation/Lane Closure)

**Sub-Contractor List**

PLEASE PRINT LEGIBLY

General Contractor's Name: Tenex Construction General Contractor's Phone #: 972-913-8883

Sub-Contractor #1 Company Name: Magdalena Alvarez Address: \_\_\_\_\_  
 Print Sub-Contractor's Name: Magdalena Alvarez Sub-Contractor's Phone #: 972-872-5271  
 Sub-Contractor's E-Mail: \_\_\_\_\_

Print Site Supervisor's Name: Rocky Stockman Supervisor's Phone #: 214-202-9093  
 Site Supervisor's E-Mail: \_\_\_\_\_

Insurance Provided?  Yes  No  On File

Sub-Contractor #2 Company Name: Ascension Rodriguez Address: \_\_\_\_\_  
 Print Sub-Contractor's Name: Ascension Rodriguez Sub-Contractor's Phone #: 972-394-0971  
 Sub-Contractor's E-Mail: \_\_\_\_\_

Print Supervisor's Name: Rocky Stockman Supervisor's Phone #: 214-202-9093  
 Site Supervisor's E-Mail: \_\_\_\_\_

Insurance Provided?  Yes  No  On File


Sub-Contractor #3 Company Name: Tomacito Espinal Address: \_\_\_\_\_  
 Print Sub-Contractor's Name: Tomacito Espinal Sub-Contractor's Phone #: 1-214-218-5271  
 Sub-Contractor's E-Mail: \_\_\_\_\_

Print Supervisor's Name: Rocky Stockman Supervisor's Phone #: 214-202-9093  
 Site Supervisor's E-Mail: \_\_\_\_\_

Insurance Provided?  Yes  No  On File

TOWN OF ADDISON INFRASTRUCTURE AND DEVELOPMENT SERVICES  
 DEPARTMENT ATTN.: RIGHT OF WAY PERMIT - DAVE WILDE 972-450-2847  
 16801 WESTGROVE RD. ADDISON, TX 75001-9010  
 PHONE: 972-450-2871 FAX: 972-450-2837

AT&T / TENEX CONSTRUCTION  
WO#: 9519327  
14803 LE GRANDE DR  
ADDISON

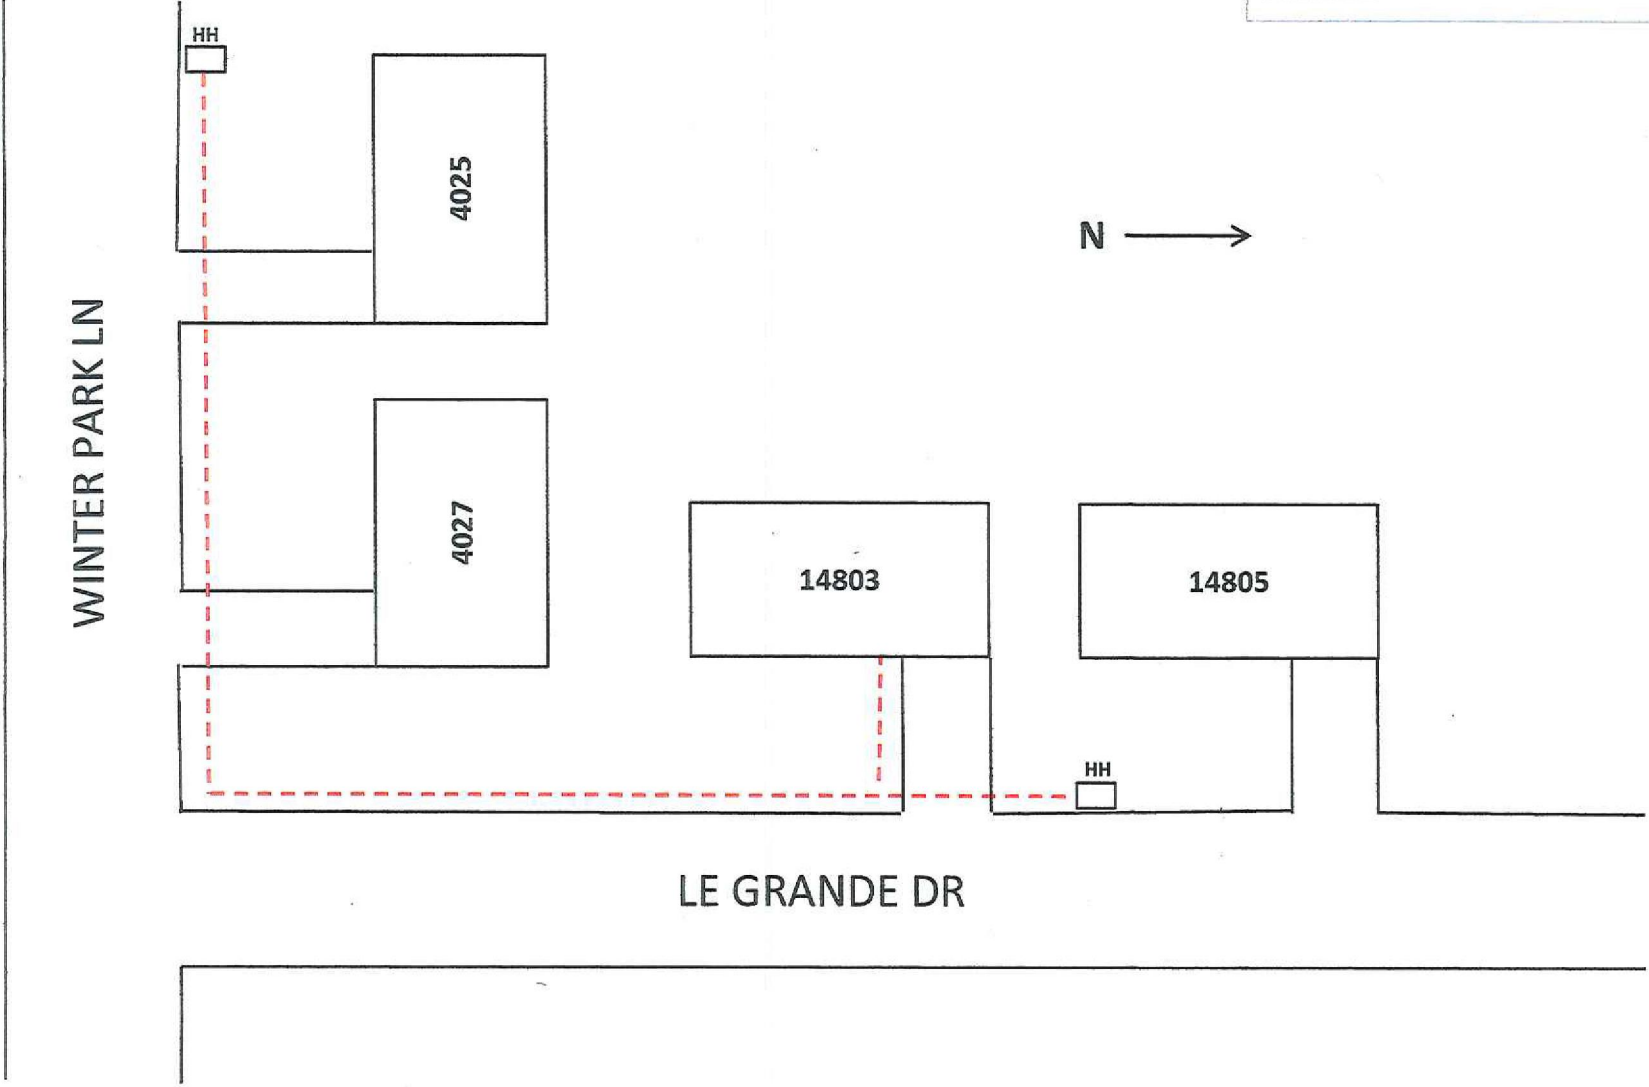

WINTER PARK LN

4025

4027

14803

14805


LE GRANDE DR



HH

HH

RIGHT OF WAY, EXCAVATION &  
LANE CLOSURE PERMIT

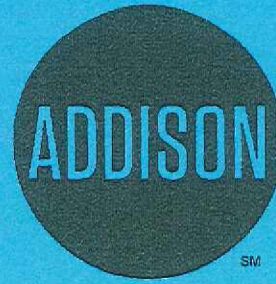

INFRASTRUCTURE &  
DEVELOPMENT SERVICES

16801 WESTGROVE DRIVE  
ADDISON, TEXAS 75001  
972.450.2871

**W-1369**

PERMIT NUMBER

**4/16/18**

START DATE

**4/27/18**

EST. COMPLETION DATE

**TENEX CONSTRUCTION**

CONTRACTOR

**AT&T**

FOR

**14803 LEGRANDE DR**

LOCATION (ADDRESS)

**FROM HANDHOLES @ 4025 WINTERPARK & 14805 LEGRANDE TO ADDRESS**

LOCATION (ACTUAL)

**PLACE SERVICE DROP TO ADDRESS**

TYPE OF WORK

THIS CARD MUST BE DISPLAYED ON THE JOB SITE AT ALL TIMES.