



FOR ADDISON USE ONLY

Permit Number: W-1379  
Location: 14818 LeGrand

APPLICATION

Right of Way Work Permit -FRANCHISE

(For Franchise Utility/CTP - Street Cut/Excavation/Lane Closure)

PLEASE PRINT LEGIBLY

Date of Application: 4/18/18

Facility Owner Company: AT+T Company Phone #: 800-924-9420

Utility/CTP Representative: Susan Esquivel Cell Phone #: 214-467-8276

Utility/CTP Representative E-Mail: \_\_\_\_\_

General Contractor: Tenex Construction Company Phone #: 972-913-8883

Site Supervisor Name: Rocky Stockman 24-hour phone #: 214-202-9093

Contractor E-Mail address: Rocky@tenexconstruction.com Site Foreman E-Mail: \_\_\_\_\_

Work Site Address and Location: 14818 LE GRAND DR

Purpose and general description of work: Placement of Phone Service Drop

Proposed Start Work Date: 4/20/18 Estimated Completion Date: 5/4/18

Pavement Cut? Yes No Directional Bore/Boring? Yes No

Excavation? Yes No Lane Closure? Yes No Other: \_\_\_\_\_? Yes No

Kim Hines Kim Hines Office Manager  
Applicant's Printed Name Signature Position with Company

Applicant's Email: Kim@tenexconstruction.com Applicant's Phone Number: 972-913-8883

Rocky Stockman 214-202-9093 Tenex Construction  
Direct Supervisor's Printed Name Phone Number Company Name

Supervisor's E-Mail: \_\_\_\_\_

FOR ADDISON USE ONLY

Received By: Nicole S Entered? Yes Received Date: 4-18-18

Approved By: Dave Wilde Inspector: JE Issue Date: 4/19/18

Plans Submitted? Yes No N/A Traffic Control Plan Submitted? Yes No N/A Expiration Date: 5/3/18

Insurance Provided? Yes No On File Performance/Maintenance Bond? Yes No On File N/A

Fee Paid: NA Receipt#: CTP Date: 4-20-18 Processed By: Nicole S

Picked Up By: Rocky Company: Tenex Date & Time: 10:13AM

4-20-18

TOWN OF ADDISON INFRASTRUCTURE AND DEVELOPMENT SERVICES  
DEPARTMENT ATTN.: RIGHT OF WAY PERMIT - DAVE WILDE 972-450-2847  
16801 WESTGROVE RD. ADDISON, TX 75001-9010  
PHONE: 972-450-2871 FAX: 972-450-2837



FOR ADDISON USE ONLY	
Permit Number:	<u>65-1379</u>
Location:	<u>14818 Helgenade</u>

**APPLICATION**  
**Right of Way Work Permit -FRANCHISE**  
 (For Franchise Utility/CTP - Street Cut/Excavation/Lane Closure)

**Sub-Contractor List**

PLEASE PRINT LEGIBLY

General Contractor's Name: Tenex Construction General Contractor's Phone #: 972-913-8883

Sub-Contractor #1 Company Name: Magdalena Alvarez Address: \_\_\_\_\_

Print Sub-Contractor's Name: Magdalena Alvarez Sub-Contractor's Phone #: 972-872-5271

Sub-Contractor's E-Mail: \_\_\_\_\_

Print Site Supervisor's Name: Rocky Stockman Supervisor's Phone #: 214-202-9093

Site Supervisor's E-Mail: \_\_\_\_\_

Insurance Provided?  Yes  No  On File

Sub-Contractor #2 Company Name: Ascension Rodriguez Address: \_\_\_\_\_

Print Sub-Contractor's Name: Ascension Rodriguez Sub-Contractor's Phone #: 972-394-0971

Sub-Contractor's E-Mail: \_\_\_\_\_

Print Supervisor's Name: Rocky Stockman Supervisor's Phone #: 214-202-9093

Site Supervisor's E-Mail: \_\_\_\_\_

Insurance Provided?  Yes  No  On File

Sub-Contractor #3 Company Name: Tomacito Espinal Address: \_\_\_\_\_


Print Sub-Contractor's Name: Tomacito Espinal Sub-Contractor's Phone #: 1-214-218-5271

Sub-Contractor's E-Mail: \_\_\_\_\_

Print Supervisor's Name: Rocky Stockman Supervisor's Phone #: 214-202-9093

Site Supervisor's E-Mail: \_\_\_\_\_


Insurance Provided?  Yes  No  On File

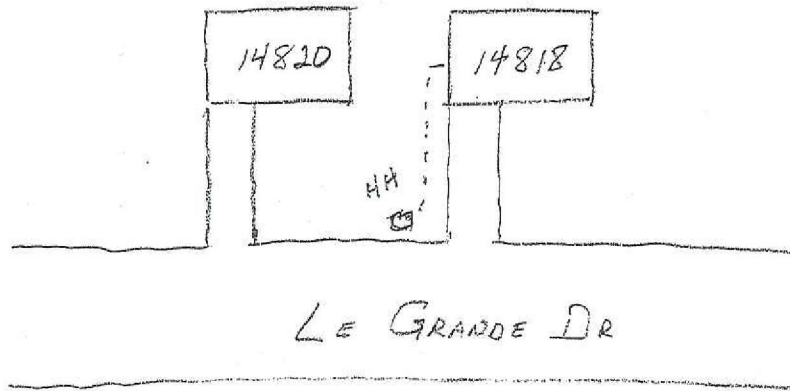

← N

AT&T / TENEX CONST  
WD 9544297  
14818 LE GRANDE DR  
ADDISON

**RIGHT OF WAY, EXCAVATION &  
LANE CLOSURE PERMIT**

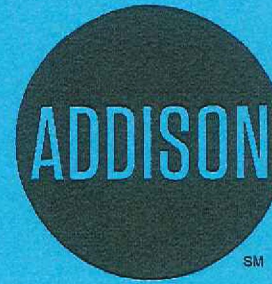

**INFRASTRUCTURE &  
DEVELOPMENT SERVICES**

16801 WESTGROVE DRIVE  
ADDISON, TEXAS 75001  
972.450.2871

**W-1379**

PERMIT NUMBER

**4/20/18**

START DATE

**5/04/18**

EST. COMPLETION DATE

**TENEX CONSTRUCTION**

CONTRACTOR

**AT&T**

FOR

**14818 LeGRANDE**

LOCATION (ADDRESS)

**FROM HANDHOLE TO NORTH SIDE OF ADDRESS**

LOCATION (ACTUAL)

**PLACE SERVICE DROP TO ADDRESS**

TYPE OF WORK

THIS CARD MUST BE DISPLAYED ON THE JOB SITE AT ALL TIMES.