

FOR ADDISON USE ONLY
 Permit Number: W-1361
 Location: 4029 RIVE Ln.

APPLICATION
Right of Way Work Permit -FRANCHISE
 (For Franchise Utility/CTP - Street Cut/Excavation/Lane Closure)

PLEASE PRINT LEGIBLY

Date of Application: 4/9/18

Facility Owner Company: AT&T Company Phone #: 800-924-9420
 Utility/CTP Representative: Susan Esquivel Cell Phone #: 214-467-8276
 Utility/CTP Representative E-Mail: _____

General Contractor: Tenex Construction Company Phone #: 972-913-8883
 Site Supervisor Name: Rocky Stockman 24-hour phone #: 214-202-9093
 Contractor E-Mail address: Rocky@tenexconstruction.com Site Foreman E-Mail: _____

Work Site Address and Location: 4029 RIVE Ln

Purpose and general description of work: Placement of Phone Service Drop

Proposed Start Work Date: 4/9/18 Estimated Completion Date: 4/20/18

Pavement Cut? Yes No Directional Bore/Boring? Yes No

Excavation? Yes No Lane Closure? Yes No Other: _____ ? Yes No

Kim Hines Applicant's Printed Name Kim Hines Signature Office Manager Position with Company

Applicant's Email: Kim@tenexconstruction.com Applicant's Phone Number: 972-913-8883

Rocky Stockman Direct Supervisor's Printed Name 214-202-9093 Phone Number Tenex Construction Company Name

Supervisor's E-Mail: _____

FOR ADDISON USE ONLY

Received By: Nicole S. Entered? Yes Received Date: 4-4-18

Approved By: Dave Wilde Inspector: JF Issue Date: 4/5/18


Plans Submitted? Yes No N/A Traffic Control Plan Submitted? Yes No N/A Expiration Date: 4/19/18

Insurance Provided? Yes No On File Performance/Maintenance Bond? Yes No On File N/A

Fee Paid: NA Receipt#: CTP Date: 4-9-18 Processed By: Nicole S.

Picked Up By: Rocky Company: Tenex Date & Time: 4-9-18
10:45AM

TOWN OF ADDISON INFRASTRUCTURE AND DEVELOPMENT SERVICES
 DEPARTMENT ATTN.: RIGHT OF WAY PERMIT - DAVE WILDE 972-450-2847
 16801 WESTGROVE RD. ADDISON, TX 75001-9010
 PHONE: 972-450-2871 FAX: 972-450-2837

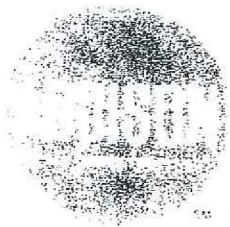

FOR ADDISON USE ONLY	
Permit Number:	<u>W-1361</u>
Location:	<u>4029 Rio C Ln</u>

APPLICATION
Right of Way Work Permit -FRANCHISE
 (For Franchise Utility/CTP - Street Cut/Excavation/Lane Closure)

Sub-Contractor List

PLEASE PRINT LEGIBLY

General Contractor's Name: Tenex Construction General Contractor's Phone #: 972-913-8883

Sub-Contractor #1 Company Name: Magdalena Alvarez Address: _____

Print Sub-Contractor's Name: Magdalena Alvarez Sub-Contractor's Phone #: 972-872-5271

Sub-Contractor's E-Mail: _____

Print Site Supervisor's Name: Rocky Stockman Supervisor's Phone #: 214-202-9093

Site Supervisor's E-Mail: _____

Insurance Provided? Yes No On File

Sub-Contractor #2 Company Name: Ascension Rodriguez Address: _____

Print Sub-Contractor's Name: Ascension Rodriguez Sub-Contractor's Phone #: 972-394-0971

Sub-Contractor's E-Mail: _____

Print Supervisor's Name: Rocky Stockman Supervisor's Phone #: 214-202-9093

Site Supervisor's E-Mail: _____

Insurance Provided? Yes No On File

Sub-Contractor #3 Company Name: Tomacito Espinal Address: _____

Print Sub-Contractor's Name: Tomacito Espinal Sub-Contractor's Phone #: 1-214-218-5271

Sub-Contractor's E-Mail: _____



Print Supervisor's Name: Rocky Stockman Supervisor's Phone #: 214-202-9093

Site Supervisor's E-Mail: _____


Insurance Provided? Yes No On File

TOWN OF ADDISON INFRASTRUCTURE AND DEVELOPMENT SERVICES
 DEPARTMENT ATTN.: RIGHT OF WAY PERMIT - DAVE WILDE 972-450-2847
 16801 WESTGROVE RD. ADDISON, TX 75001-9010
 PHONE: 972-450-2871 FAX: 972-450-2837


AT&T / TENEX CONSTRUCTION
WO#: 9469711
4029 RIVE LN
ADDISON, TX

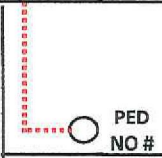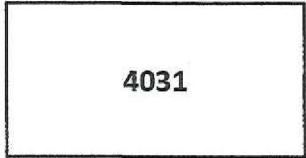

RIVE LN

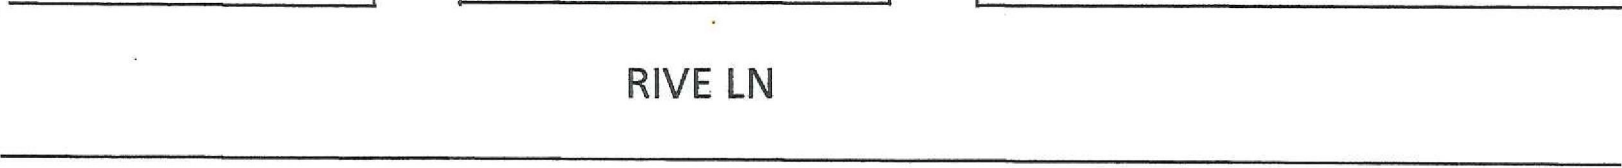

**RIGHT OF WAY, EXCAVATION &
LANE CLOSURE PERMIT**

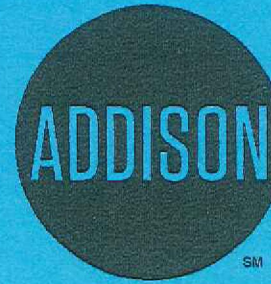

**INFRASTRUCTURE &
DEVELOPMENT SERVICES**

16801 WESTGROVE DRIVE
ADDISON, TEXAS 75001
972.450.2871

W-1361

PERMIT NUMBER

4/09/18

START DATE

4/20/18

EST. COMPLETION DATE

TENEX CONSTRUCTION AT&T

CONTRACTOR

FOR

4029 RIVE LN

LOCATION (ADDRESS)

FROM PEDESTAL TO HOUSE

LOCATION (ACTUAL)

INSTALL CABLE FACILITIES FOR SERVICE TO HOUSE

TYPE OF WORK

THIS CARD MUST BE DISPLAYED ON THE JOB SITE AT ALL TIMES.