



FOR ADDISON USE ONLY
 Permit Number: W-1380
 Location: 14818 Sopras Cir

APPLICATION

Right of Way Work Permit -FRANCHISE

(For Franchise Utility/CTP - Street Cut/Excavation/Lane Closure)

PLEASE PRINT LEGIBLY

Date of Application: 4/18/18

Facility Owner Company: AT+T Company Phone #: 800-924-9420

Utility/CTP Representative: Susan Esquivel Cell Phone #: 214-467-8276

Utility/CTP Representative E-Mail: _____

General Contractor: Tenex Construction Company Phone #: 972-913-8883

Site Supervisor Name: Rocky Stockman 24-hour phone #: 214-202-9093

Contractor E-Mail address: Rocky@tenexconstruction.com Site Foreman E-Mail: _____

Work Site Address and Location: 14818 Sopras Cir

Purpose and general description of work: Placement of Phone Service Drop

Proposed Start Work Date: 4/30/18 Estimated Completion Date: 5/4/18

Pavement Cut? Yes No Directional Bore/Boring? Yes No

Excavation? Yes No Lane Closure? Yes No Other: _____? Yes No

Kim Hines Kim Hines Office Manager
 Applicant's Printed Name Signature Position with Company

Applicant's Email: Kim@tenexconstruction.com Applicant's Phone Number: 972-913-8883

Rocky Stockman 214-202-9093 Tenex Construction
 Direct Supervisor's Printed Name Phone Number Company Name

Supervisor's E-Mail: _____

FOR ADDISON USE ONLY

Received By: Michelle S. Entered? Yes Received Date: 4-18-18

Approved By: Dave Wilde Inspector: CTF Issue Date: 4/19/18

Plans Submitted? Yes No N/A Traffic Control Plan Submitted? Yes No N/A Expiration Date: 4/30/18

Insurance Provided? Yes No On File Performance/Maintenance Bond? Yes No On File N/A

Fee Paid: NA Receipt#: CTP Date: 4-20-18 Processed By: Michelle S.

Picked Up By: Rocky Company: Tenex Date & Time: 4-20-18

10:30AM

TOWN OF ADDISON INFRASTRUCTURE AND DEVELOPMENT SERVICES
 DEPARTMENT ATTN.: RIGHT OF WAY PERMIT - DAVE WILDE 972-450-2847
 16801 WESTGROVE RD. ADDISON, TX 75001-9010
 PHONE: 972-450-2871 FAX: 972-450-2837



FOR ADDISON USE ONLY	
Permit Number:	<u>W-1380</u>
Location:	<u>14818 Spras Cir</u>

APPLICATION
Right of Way Work Permit -FRANCHISE
 (For Franchise Utility/CTP - Street Cut/Excavation/Lane Closure)

Sub-Contractor List

PLEASE PRINT LEGIBLY

General Contractor's Name: Tenex Construction General Contractor's Phone #: 972-913-8883

Sub-Contractor #1 Company Name: Magdalena Alvarez Address: _____

Print Sub-Contractor's Name: Magdalena Alvarez Sub-Contractor's Phone #: 972-872-5271

Sub-Contractor's E-Mail: _____

Print Site Supervisor's Name: Rocky Stockman Supervisor's Phone #: 214-202-9093

Site Supervisor's E-Mail: _____

Insurance Provided? Yes No On File

Sub-Contractor #2 Company Name: Ascension Rodriguez Address: _____

Print Sub-Contractor's Name: Ascension Rodriguez Sub-Contractor's Phone #: 972-394-0971

Sub-Contractor's E-Mail: _____

Print Supervisor's Name: Rocky Stockman Supervisor's Phone #: 214-202-9093

Site Supervisor's E-Mail: _____

Insurance Provided? Yes No On File

Sub-Contractor #3 Company Name: Tomacito Espinal Address: _____


Print Sub-Contractor's Name: Tomacito Espinal Sub-Contractor's Phone #: 1-214-218-5271

Sub-Contractor's E-Mail: _____

Print Supervisor's Name: Rocky Stockman Supervisor's Phone #: 214-202-9093

Site Supervisor's E-Mail: _____


Insurance Provided? Yes No On File

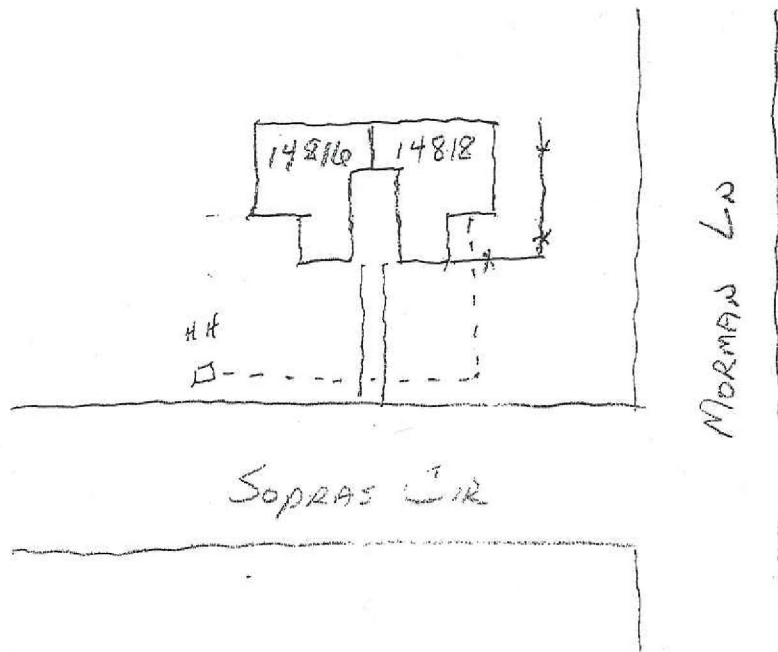

← N

AT&T/TEXEX CONST
WO 9545045
14818 SOPRAS CIR
ADDISSN

**RIGHT OF WAY, EXCAVATION &
LANE CLOSURE PERMIT**

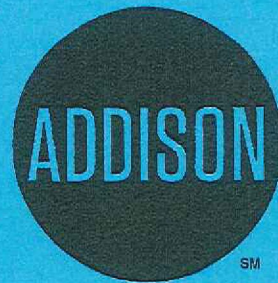

**INFRASTRUCTURE &
DEVELOPMENT SERVICES**

16801 WESTGROVE DRIVE
ADDISON, TEXAS 75001
972.450.2871

W-1380

PERMIT NUMBER

4/20/18

START DATE

5/04/18

EST. COMPLETION DATE

TENEX CONSTRUCTION

CONTRACTOR

AT&T

FOR

14818 SOPRAS CIRCLE

LOCATION (ADDRESS)

FROM HANDHOLE @ 14816 TO WEST SIDE OF ADDRESS

LOCATION (ACTUAL)

PLACE SERVICE DROP TO ADDRESS

TYPE OF WORK

THIS CARD MUST BE DISPLAYED ON THE JOB SITE AT ALL TIMES.