



**FOR ADDISON USE ONLY**  
 Permit Number: W-1420  
 Location: 14592 Camelot Ct

**APPLICATION**  
**Right of Way Work Permit-FRANCHISE**

(For Franchise Utility/CTP – Street Cut/Excavation/Lane Closure)

PLEASE PRINT LEGIBLY

Date of Application: 5/14/18  
 Facility Owner Company: AT&T Company Phone #: 800-924-9920  
 Utility/CTP Representative: Ramon Aziz Cell Phone #: 214-538-5536  
 Utility/CTP Representative E-mail: \_\_\_\_\_  
 General Contractor: Tenex Construction Company Phone #: 972-913-8883  
 Site Supervisor Name: Rocky Stockman 24-hour Phone #: 214-202-9093  
 Contractor E-mail: \_\_\_\_\_ Site Foreman E-mail: Rocky@tenexconstruction.com  
 Work Site Address and Location: 14592 CAMELOT CT  
 Purpose and general description of work: Placement of Phone Service Drop  
 Proposed Start Work Date: 5/16/18 Estimated Completion Date: 5/25/18  
 Pavement Cut?  Yes  No Directional Bore/Boring?  Yes  No Excavation?  Yes  No  
 Lane Closure?  Yes  No Other: \_\_\_\_\_  
 Applicant's Printed Name: Kim Hines Signature: Kim Hines Position with Company: Office Manager  
 Applicant's E-mail: Kim@tenexconstruction.com Applicant's Phone #: 972-913-8883  
 Direct Supervisor's Name: Rocky Stockman Phone Number: 214-202-9093 Company Name: Tenex Construction  
 Supervisor's E-mail: \_\_\_\_\_

**FOR ADDISON USE ONLY**

Received By: [Signature] Entered?  Yes  No Received Date: 5/14/18  
 Approved By: [Signature] Inspector: JF Issue Date: 5/18/18  
 Plans Submitted?  Yes  No  N/A Traffic Control Plan submitted?  Yes  No  N/A Expiration Date: 6/14/18  
 Insurance Provided?  Yes  No  On File Performance/Maintenance Bond?  Yes  No  On File  N/A  
 Fee Paid: NA Receipt #: CTP Processed By: [Signature]  
 Picked Up By: Rocky Company: Tenex Date & Time: 5/21/18

TOWN OF ADDISON INFRASTRUCTURE AND DEVELOPMENT SERVICES DEPARTMENT  
 ATTN.: RIGHT OF WAY PERMIT - DAVE WILDE 972-450-2847  
 16801 WESTGROVE RD. ADDISON, TX 75001-9010  
 PHONE: 972-450-2871 FAX: 972-450-2837

FOR ADDISON USE ONLY  
Permit Number: W-1420  
Location: 14592 Comelot Ct,

**APPLICATION**  
**Right of Way Work Permit -FRANCHISE**  
(For Franchise Utility/CTP - Street Cut/Excavation/Lane Closure)

**Sub-Contractor List**

PLEASE PRINT LEGIBLY

General Contractor's Name: Tenex Construction General Contractor's Phone #: 972-913-8883

Sub-Contractor #1 Company Name: Magdeleno Alvarez Address: \_\_\_\_\_  
Print Sub-Contractor's Name: Magdeleno Alvarez Sub-Contractor's Phone #: 972-872-5271  
Sub-Contractor's E-Mail: \_\_\_\_\_

Print Site Supervisor's Name: Rocky Stockman Supervisor's Phone #: 214-202-9093  
Site Supervisor's E-Mail: \_\_\_\_\_

Insurance Provided?  Yes  No  On File

Sub-Contractor #2 Company Name: Ascension Rodriguez Address: \_\_\_\_\_  
Print Sub-Contractor's Name: Ascension Rodriguez Sub-Contractor's Phone #: 972-394-0971  
Sub-Contractor's E-Mail: \_\_\_\_\_


Print Supervisor's Name: Rocky Stockman Supervisor's Phone #: 214-202-9093  
Site Supervisor's E-Mail: \_\_\_\_\_

Insurance Provided?  Yes  No  On File

Sub-Contractor #3 Company Name: Tomacito Espinal Address: \_\_\_\_\_  
Print Sub-Contractor's Name: Tomacito Espinal Sub-Contractor's Phone #: 1-214-218-5271  
Sub-Contractor's E-Mail: \_\_\_\_\_

Print Supervisor's Name: Rocky Stockman Supervisor's Phone #: 214-202-9093  
Site Supervisor's E-Mail: \_\_\_\_\_

Insurance Provided?  Yes  No  On File

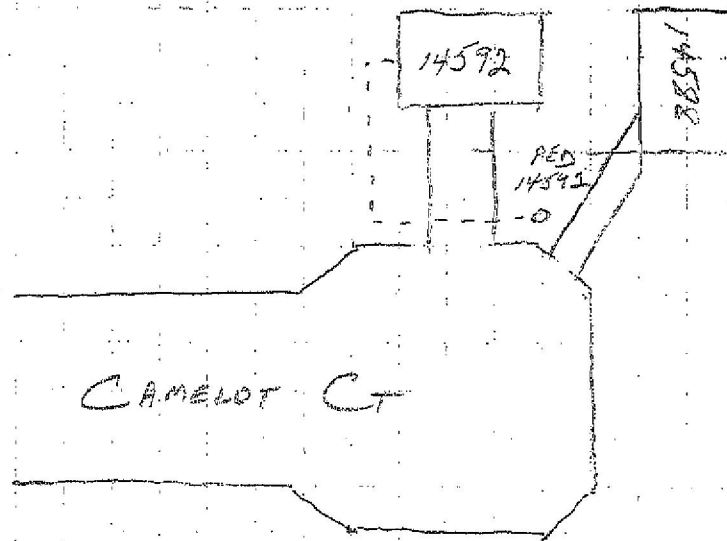

ATTN/TELEX CONST  
WO 9647279  
14592 CAMELOT CT  
ADDISON



**RIGHT OF WAY, EXCAVATION &  
LANE CLOSURE PERMIT**



**INFRASTRUCTURE &  
DEVELOPMENT SERVICES**

16801 WESTGROVE DRIVE  
ADDISON, TEXAS 75001  
972.450.2871

**W-1420**

PERMIT NUMBER

**5/18/18**

START DATE

**5/30/18 TENEX CONST.**

EST. COMPLETION DATE

CONTRACTOR

**AT&T**

FOR

**14592 CAMELOT CT**

LOCATION (ADDRESS)

**FROM HANDHOLE TO NORTH SIDE OF ADDRESS**

LOCATION (ACTUAL)

**PHONE SERVICE DROP TO ADDRESS**

TYPE OF WORK

THIS CARD MUST BE DISPLAYED ON THE JOB SITE AT ALL TIMES.