



**FOR ADDISON USE ONLY**

Permit Number: W-1409

Location: 3910 Dome

**APPLICATION**  
**Right of Way Work Permit-FRANCHISE**

(For Franchise Utility/CTP - Street Cut/Excavation/Lane Closure)

**PLEASE PRINT LEGIBLY**

Date of Application: 5/14/18

Facility Owner Company: AT&T Company Phone #: 800-924-9420

Utility/CTP Representative: Ramon Aziz Cell Phone #: 214-538-5536

Utility/CTP Representative E-mail: \_\_\_\_\_

General Contractor: Tenex Construction Company Phone #: 972-913-8883

Site Supervisor Name: Rocky Stockman 24-hour Phone #: 214-202-9093

Contractor E-mail: \_\_\_\_\_ Site Foreman E-mail: Rocky@tenexconstruction.com

Work Site Address and Location: 3910 DOME DR

Purpose and general description of work: Placement of Phone Service Drop

Proposed Start Work Date: 5/20/18 Estimated Completion Date: 5/25/18

Pavement Cut?  Yes  No Directional Bore/Boring?  Yes  No Excavation?  Yes  No

Lane Closure?  Yes  No Other: \_\_\_\_\_

Applicant's Printed Name: Kim Hines Signature: Kim Hines Position with Company: Office Manager

Applicant's E-mail: Kim@tenexconstruction.com Applicant's Phone #: 972-913-8883

Direct Supervisor's Name: Rocky Stockman Phone Number: 214-202-9093 Company Name: Tenex Construction

Supervisor's E-mail: \_\_\_\_\_

**FOR ADDISON USE ONLY**

Received By: Wilde Entered?  Yes  No Received Date: 5.14.18

Approved By: Dave Wilde Inspector: JF Issue Date: 5/18/18

Plans Submitted?  Yes  No  N/A Traffic Control Plan submitted?  Yes  No  N/A Expiration Date: 6/4/18

Insurance Provided?  Yes  No  On File Performance/Maintenance Bond?  Yes  No  On File  N/A

Fee Paid: NA Receipt #: CTP Processed By: Wilde

Picked Up By: Rocky Company: Tenex Date & Time: 5-21-18

TOWN OF ADDISON INFRASTRUCTURE AND DEVELOPMENT SERVICES DEPARTMENT  
ATTN.: RIGHT OF WAY PERMIT - DAVE WILDE 972-450-2847  
16801 WESTGROVE RD. ADDISON, TX 75001-9010  
PHONE: 972-450-2871 FAX: 972-450-2837

FOR ADDISON USE ONLY	
Permit Number:	<u>W-1409</u>
Location:	<u>3910 Dome</u>

**APPLICATION**  
**Right of Way Work Permit -FRANCHISE**  
 (For Franchise Utility/CTP - Street Cut/Excavation/Lane Closure)

**Sub-Contractor List**

PLEASE PRINT LEGIBLY

General Contractor's Name: Tenex Construction General Contractor's Phone #: 972-913-8883

Sub-Contractor #1 Company Name: Magdalena Alvarez Address: \_\_\_\_\_  
 Print Sub-Contractor's Name: Magdalena Alvarez Sub-Contractor's Phone #: 972-872-5271  
 Sub-Contractor's E-Mail: \_\_\_\_\_

Print Site Supervisor's Name: Rocky Stockman Supervisor's Phone #: 214-202-9093  
 Site Supervisor's E-Mail: \_\_\_\_\_

Insurance Provided?  Yes  No  On File

Sub-Contractor #2 Company Name: Ascension Rodriguez Address: \_\_\_\_\_  
 Print Sub-Contractor's Name: Ascension Rodriguez Sub-Contractor's Phone #: 972-394-0971  
 Sub-Contractor's E-Mail: \_\_\_\_\_


Print Supervisor's Name: Rocky Stockman Supervisor's Phone #: 214-202-9093  
 Site Supervisor's E-Mail: \_\_\_\_\_

Insurance Provided?  Yes  No  On File

Sub-Contractor #3 Company Name: Tomacito Espinal Address: \_\_\_\_\_  
 Print Sub-Contractor's Name: Tomacito Espinal Sub-Contractor's Phone #: 1-214-218-5271  
 Sub-Contractor's E-Mail: \_\_\_\_\_

Print Supervisor's Name: Rocky Stockman Supervisor's Phone #: 214-202-9093  
 Site Supervisor's E-Mail: \_\_\_\_\_

Insurance Provided?  Yes  No  On File

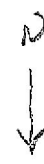

3910


PARK

AT&T/TELEX CONST  
WO 9638059  
3910 DOME DR  
ADDISON

HP

SIDEWALK

DOME DR

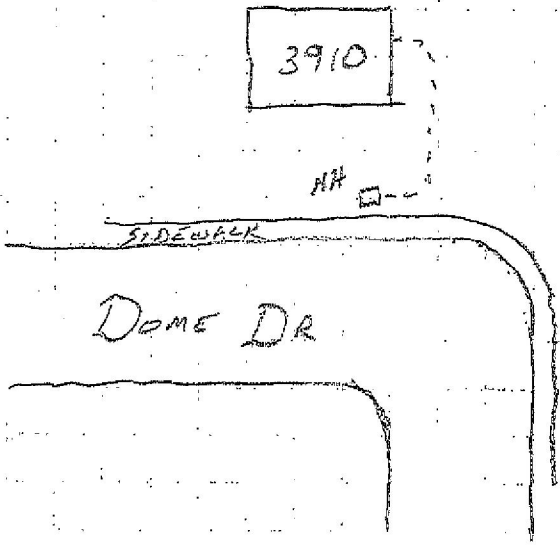

**RIGHT OF WAY, EXCAVATION &  
LANE CLOSURE PERMIT**



**INFRASTRUCTURE &  
DEVELOPMENT SERVICES**

16801 WESTGROVE DRIVE  
ADDISON, TEXAS 75001  
972.450.2871

**W-1409**

PERMIT NUMBER

**5/18/18**

START DATE

**5/30/18**

EST. COMPLETION DATE

**TENEX CONST.**

CONTRACTOR

**AT&T**

FOR

**3910 DOME**

LOCATION (ADDRESS)

**FROM HANDHOLE TO WEST SIDE OF ADDRESS**

LOCATION (ACTUAL)

**PLACE PHONE SERVICE DROP**

TYPE OF WORK

THIS CARD MUST BE DISPLAYED ON THE JOB SITE AT ALL TIMES.