



**FOR ADDISON USE ONLY**  
 Permit Number: W-1411  
 Location: 14825 Le Grande

**APPLICATION**  
**Right of Way Work Permit-FRANCHISE**

(For Franchise Utility/CTP - Street Cut/Excavation/Lane Closure)

**PLEASE PRINT LEGIBLY**

Date of Application: 5/14/18  
 Facility Owner Company: AT&T Company Phone #: 800-924-9420  
 Utility/CTP Representative: Ramon Aziz Cell Phone #: 214-538-5536  
 Utility/CTP Representative E-mail: \_\_\_\_\_  
 General Contractor: Tenex Construction Company Phone #: 972-913-8883  
 Site Supervisor Name: Rocky Stockman 24-hour Phone #: 214-202-9093  
 Contractor E-mail: \_\_\_\_\_ Site Foreman E-mail: Rocky@tenexconstruction.com  
 Work Site Address and Location: 14825 LE GRANDE DR  
 Purpose and general description of work: Placement of Phone Service Drop  
 Proposed Start Work Date: 5/16/18 Estimated Completion Date: 5/35/18  
 Pavement Cut?  Yes  No Directional Bore/Boring?  Yes  No Excavation?  Yes  No  
 Lane Closure?  Yes  No Other: \_\_\_\_\_  
 Applicant's Printed Name: Kim Hines Signature: Kim Hines Position with Company: Office Manager  
 Applicant's E-mail: Kim@tenexconstruction.com Applicant's Phone #: 972-913-8883  
 Direct Supervisor's Name: Rocky Stockman Phone Number: 214-202-9093 Company Name: Tenex Construction  
 Supervisor's E-mail: \_\_\_\_\_

**FOR ADDISON USE ONLY**

Received By: Marie S Entered?  Yes Received Date: 5.14.18  
 Approved By: Dave Wilde Inspector: TF Issue Date: 5/18/18  
 Plans Submitted?  Yes  No  N/A Traffic Control Plan submitted?  Yes  No  N/A Expiration Date: 6/4/18  
 Insurance Provided?  Yes  No  On File Performance/Maintenance Bond?  Yes  No  On File  N/A  
 Fee Paid: NA Receipt #: CTP Processed By: Marie S  
 Picked Up By: Rocky Company: Tenex Date & Time: 5.21.18

TOWN OF ADDISON INFRASTRUCTURE AND DEVELOPMENT SERVICES DEPARTMENT  
 ATTN.: RIGHT OF WAY PERMIT - DAVE WILDE 972-450-2847  
 16801 WESTGROVE RD. ADDISON, TX 75001-9010  
 PHONE: 972-450-2871 FAX: 972-450-2837

FOR ADDISON USE ONLY

Permit Number: W-1461

Location: 14825 La Grande

## APPLICATION

### Right of Way Work Permit -FRANCHISE

(For Franchise Utility/CTP - Street Cut/Excavation/Lane Closure)

### Sub-Contractor List

PLEASE PRINT LEGIBLY

General Contractor's Name: Tenex Construction General Contractor's Phone #: 972-913-8883

Sub-Contractor #1 Company Name: Magdalena Alvarez Address: \_\_\_\_\_

Print Sub-Contractor's Name: Magdalena Alvarez Sub-Contractor's Phone #: 972-872-5271

Sub-Contractor's E-Mail: \_\_\_\_\_

Print Site Supervisor's Name: Rocky Stockman Supervisor's Phone #: 214-202-9093

Site Supervisor's E-Mail: \_\_\_\_\_

Insurance Provided?  Yes  No  On File

Sub-Contractor #2 Company Name: Ascension Rodriguez Address: \_\_\_\_\_

Print Sub-Contractor's Name: Ascension Rodriguez Sub-Contractor's Phone #: 972-394-0971

Sub-Contractor's E-Mail: \_\_\_\_\_

Print Supervisor's Name: Rocky Stockman Supervisor's Phone #: 214-202-9093

Site Supervisor's E-Mail: \_\_\_\_\_

Insurance Provided?  Yes  No  On File

Sub-Contractor #3 Company Name: Tomacito Espinal Address: \_\_\_\_\_

Print Sub-Contractor's Name: Tomacito Espinal Sub-Contractor's Phone #: 1-214-218-5271

Sub-Contractor's E-Mail: \_\_\_\_\_


Print Supervisor's Name: Rocky Stockman Supervisor's Phone #: 214-202-9093

Site Supervisor's E-Mail: \_\_\_\_\_

Insurance Provided?  Yes  No  On File

TOWN OF ADDISON INFRASTRUCTURE AND DEVELOPMENT SERVICES  
DEPARTMENT ATTN.: RIGHT OF WAY PERMIT - DAVE WILDE 972-450-2847  
16801 WESTGROVE RD. ADDISON, TX 75001-9010  
PHONE: 972-450-2871 FAX: 972-450-2837

ATO/T/ TENET CONST  
DL0 9635537  
14825 LE GRANDE DR  
ADDISON

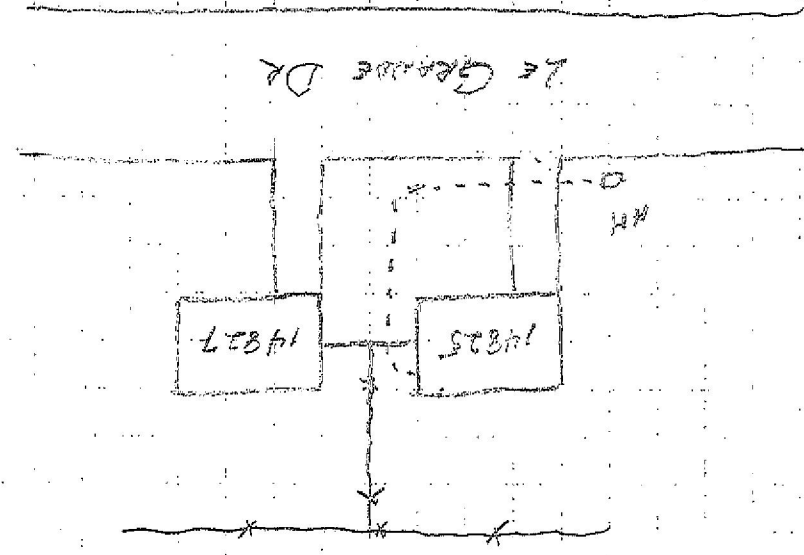

**RIGHT OF WAY, EXCAVATION &  
LANE CLOSURE PERMIT**



**INFRASTRUCTURE &  
DEVELOPMENT SERVICES**

16801 WESTGROVE DRIVE  
ADDISON, TEXAS 75001  
972.450.2871

**W-1411**

PERMIT NUMBER

**5/18/18**

START DATE

**5/30/18**

EST. COMPLETION DATE

**TENEX CONST.**

CONTRACTOR

**AT&T**

FOR

**14825 LeGRANDE**

LOCATION (ADDRESS)

**FROM HANDHOLE TO NORTH SIDE OF ADDRESS**

LOCATION (ACTUAL)

**PLACE PHONE SERVICE DROP**

TYPE OF WORK

THIS CARD MUST BE DISPLAYED ON THE JOB SITE AT ALL TIMES.