



FOR ADDISON USE ONLY

Permit Number: W-1415

Location: 4114 Rush

APPLICATION
Right of Way Work Permit-FRANCHISE

(For Franchise Utility/CTP - Street Cut/Excavation/Lane Closure)

PLEASE PRINT LEGIBLY

Date of Application: 5/14/18

Facility Owner Company: AT&T Company Phone #: 800-924-9920

Utility/CTP Representative: Ramon Aziz Cell Phone #: 214-538-5536

Utility/CTP Representative E-mail: _____

General Contractor: Tenex Construction Company Phone #: 972-913-8883

Site Supervisor Name: Rocky Stockman 24-hour Phone #: 214-202-9093

Contractor E-mail: _____ Site Foreman E-mail: Rocky@tenexconstruction.com

Work Site Address and Location: 4114 RUSH CIR

Purpose and general description of work: Placement of Phone Service Drop

Proposed Start Work Date: 5/16/18 Estimated Completion Date: 5/25/18

Pavement Cut? Yes No Directional Bore/Boring? Yes No Excavation? Yes No

Lane Closure? Yes No Other: _____

Applicant's Printed Name: Kim Hines Signature: Kim Hines Position with Company: Office Manager

Applicant's E-mail: kim@tenexconstruction.com Applicant's Phone #: 972-913-8883

Direct Supervisor's Name: Rocky Stockman Phone Number: 214-202-9093 Company Name: Tenex Construction

Supervisor's E-mail: _____

FOR ADDISON USE ONLY

Received By: Maria S Entered? Yes No Received Date: 5/14/18

Approved By: Dave Wilde Inspector: Jt Issue Date: 5/18/18

Plans Submitted? Yes No N/A Traffic Control Plan submitted? Yes No N/A Expiration Date: 6/1/18

Insurance Provided? Yes No On File Performance/Maintenance Bond? Yes No On File N/A

Fee Paid: NA Receipt #: CTP Processed By: Maria S

Picked Up By: Rocky Company: Tenex Date & Time: 5/21/18

TOWN OF ADDISON INFRASTRUCTURE AND DEVELOPMENT SERVICES DEPARTMENT
ATTN.: RIGHT OF WAY PERMIT - DAVE WILDE 972-450-2847
16801 WESTGROVE RD. ADDISON, TX 75001-9010
PHONE: 972-450-2871 FAX: 972-450-2837

FOR ADDISON USE ONLY
Permit Number: W-1415
Location: 4114 Rush

APPLICATION
Right of Way Work Permit -FRANCHISE
(For Franchise Utility/CTP - Street Cut/Excavation/Lane Closure)

Sub-Contractor List

PLEASE PRINT LEGIBLY

General Contractor's Name: Tenex Construction General Contractor's Phone #: 972-913-8883

Sub-Contractor #1 Company Name: Magdalena Alvarez Address: _____

Print Sub-Contractor's Name: Magdalena Alvarez Sub-Contractor's Phone #: 972-872-5271

Sub-Contractor's E-Mail: _____

Print Site Supervisor's Name: Rocky Stockman Supervisor's Phone #: 214-202-9093

Site Supervisor's E-Mail: _____

Insurance Provided? Yes No On File

Sub-Contractor #2 Company Name: Ascension Rodriguez Address: _____

Print Sub-Contractor's Name: Ascension Rodriguez Sub-Contractor's Phone #: 972-394-0971

Sub-Contractor's E-Mail: _____

Print Supervisor's Name: Rocky Stockman Supervisor's Phone #: 214-202-9093

Site Supervisor's E-Mail: _____

Insurance Provided? Yes No On File

Sub-Contractor #3 Company Name: Tomacito Espinal Address: _____

Print Sub-Contractor's Name: Tomacito Espinal Sub-Contractor's Phone #: 1-214-218-5271


Sub-Contractor's E-Mail: _____

Print Supervisor's Name: Rocky Stockman Supervisor's Phone #: 214-202-9093

Site Supervisor's E-Mail: _____

Insurance Provided? Yes No On File

← N

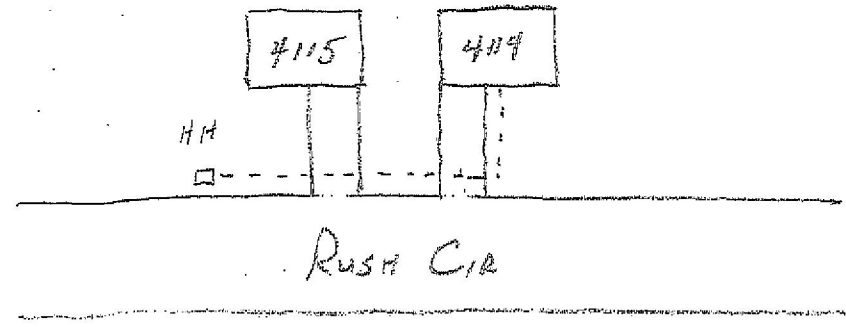

AT&T / TENER. CONST
WD 9643775
4114. RUSH CIR
ADDISON

**RIGHT OF WAY, EXCAVATION &
LANE CLOSURE PERMIT**



**INFRASTRUCTURE &
DEVELOPMENT SERVICES**

16801 WESTGROVE DRIVE
ADDISON, TEXAS 75001
972.450.2871

W-1415

PERMIT NUMBER

5/18/18

START DATE

5/30/18

EST. COMPLETION DATE

TENEX CONST.

CONTRACTOR

AT&T

FOR

4114 RUSH CIRCLE

LOCATION (ADDRESS)

FROM HANDHOLE TO WEST SIDE OF ADDRESS

LOCATION (ACTUAL)

PLACE PHONE SERVICE DROP

TYPE OF WORK

THIS CARD MUST BE DISPLAYED ON THE JOB SITE AT ALL TIMES.