



FOR ADDISON USE ONLY
 Permit Number: W-1440
 Location: 1482/LeGrande

APPLICATION

Right of Way Work Permit-FRANCHISE

(For Franchise Utility/CTP – Street Cut/Excavation/Lane Closure)

PLEASE PRINT LEGIBLY

Date of Application: 6/11/18
 Facility Owner Company: AT+T Company Phone #: 800-924-9420
 Utility/CTP Representative: Ramon Aziz Cell Phone #: 214-538-5536
 Utility/CTP Representative E-mail: _____
 General Contractor: Tenex Construction Company Phone #: 972-913-8883
 Site Supervisor Name: Rocky Stockman 24-hour Phone #: 214-202-9093
 Contractor E-mail: _____ Site Foreman E-mail: Rocky@tenexconstruction.com
 Work Site Address and Location: 14821 LEGRANDE DR
 Purpose and general description of work: Placement of Phone Service Drop
 Proposed Start Work Date: 6/4/18 Estimated Completion Date: 6/15/18
 Pavement Cut? Yes No Directional Bore/Boring? Yes No Excavation? Yes No
 Lane Closure? Yes No Other: _____
Kim Hines Applicant's Printed Name Kim Hines Signature Office Manager Position with Company
 Applicant's E-mail: kim@tenexconstruction.com Applicant's Phone #: 972-913-8883
Rocky Stockman Direct Supervisor's Name 214-202-9093 Phone Number Tenex Construction Company Name
 Supervisor's E-mail: _____

FOR ADDISON USE ONLY

Received By: Mire S Entered? Yes Received Date: 6-1-18
 Approved By: [Signature] Inspector: JE Issue Date: 6/4/18
 Plans Submitted? Yes No N/A Traffic Control Plan submitted? Yes No N/A Expiration Date: 6/18/18
 Insurance Provided? Yes No On File Performance/Maintenance Bond? Yes No On File N/A
 Fee Paid: NA Receipt #: LTP Processed By: _____
 Picked Up By: _____ Company: _____ Date & Time: _____

TOWN OF ADDISON INFRASTRUCTURE AND DEVELOPMENT SERVICES DEPARTMENT
 ATTN.: RIGHT OF WAY PERMIT - DAVE WILDE 972-450-2847
 16801 WESTGROVE RD. ADDISON, TX 75001-9010
 PHONE: 972-450-2871 FAX: 972-450-2837



| | |
|-----------------------------|-----------------------|
| FOR ADDISON USE ONLY | |
| Permit Number: | <u>W-1440</u> |
| Location: | <u>1485 La Grande</u> |

APPLICATION
Right of Way Work Permit -FRANCHISE
 (For Franchise Utility/CTP - Street Cut/Excavation/Lane Closure)

Sub-Contractor List

PLEASE PRINT LEGIBLY

General Contractor's Name: Tenex Construction General Contractor's Phone #: 972-913-8883

Sub-Contractor #1 Company Name: Magdeleno Almaraz Address: _____

Print Sub-Contractor's Name: Magdeleno Almaraz Sub-Contractor Phone #: 972-872-5271

Sub-Contractor's E-mail: _____

Print Site Supervisor's Name: Rocky Stockman Supervisor's Phone #: 214-202-9093

Site Supervisor's E-mail: _____

Insurance Provided? Yes No On File

Sub-Contractor #2 Company Name: Ascension Rodriguez Address: _____

Print Sub-Contractor's Name: Ascension Rodriguez Sub-Contractor Phone #: 972-394-0971

Sub-Contractor's E-mail: _____

Print Supervisor's Name: Rocky Stockman Supervisor's Phone #: 214-202-9093

Site Supervisor's E-mail: _____

Insurance Provided? Yes No On File

Sub-Contractor #3 Company Name: Tomacito Espinal Address: _____


Print Sub-Contractor's Name: Tomacito Espinal Sub-Contractor Phone #: 1-214-218-5271

Sub-Contractor's E-mail: _____

Print Supervisor's Name: Rocky Stockman Supervisor's Phone #: 214-202-9093


Site Supervisor's E-mail: _____

Insurance Provided? Yes No On File

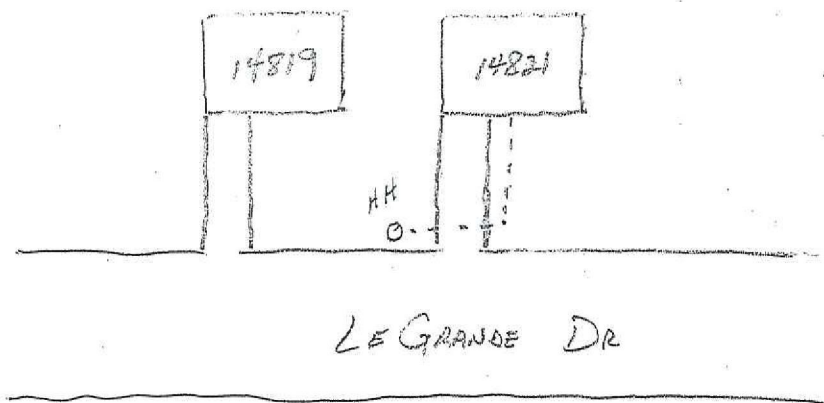

AT&T / TELEX CONST
WO 9688192
14821 LE GRANDE DR
ADDISON

**RIGHT OF WAY, EXCAVATION &
LANE CLOSURE PERMIT**

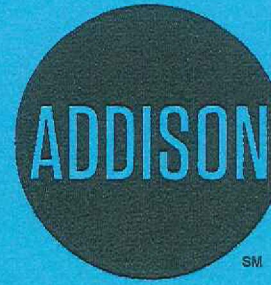

**INFRASTRUCTURE &
DEVELOPMENT SERVICES**

16801 WESTGROVE DRIVE
ADDISON, TEXAS 75001
972.450.2871

W-1440

PERMIT NUMBER

6/04/18

START DATE

6/15/18

EST. COMPLETION DATE

TENEX CONST

CONTRACTOR

AT&T

FOR

14821 LeGRANDE

LOCATION (ADDRESS)

FROM HANDHOLE TO EAST SIDE OF ADDRESS

LOCATION (ACTUAL)

INSTALL CABLE FACILITIES TO PROVIDE SERVICE TO ADDRESS

TYPE OF WORK

THIS CARD MUST BE DISPLAYED ON THE JOB SITE AT ALL TIMES.