



**FOR ADDISON USE ONLY**  
 Permit Number: W-1405  
 Location: 3913 Bobbin

**APPLICATION**  
**Right of Way Work Permit-FRANCHISE**

(For Franchise Utility/CTP – Street Cut/Excavation/Lane Closure)

**PLEASE PRINT LEGIBLY**

Date of Application: 6/22/18  
 Facility Owner Company: AT&T Company Phone #: 800-924-9420  
 Utility/CTP Representative: Ramon Aziz Cell Phone #: 214-538-5536  
 Utility/CTP Representative E-mail: \_\_\_\_\_  
 General Contractor: Tenex Construction Company Phone #: 972-913-8883  
 Site Supervisor Name: Rocky Stockman 24-hour Phone #: 214-202-9093  
 Contractor E-mail: \_\_\_\_\_ Site Foreman E-mail: Rocky@tenexconstruction.com  
 Work Site Address and Location: 3913 Bobbin Ln

Purpose and general description of work: Placement of Phone Service Drop  
 Proposed Start Work Date: 6/25/18 Estimated Completion Date: 7/6/18

Pavement Cut?  Yes  No Directional Bore/Boring?  Yes  No Excavation?  Yes  No  
 Lane Closure?  Yes  No Other: \_\_\_\_\_

Kim Hines Applicant's Printed Name      Kim Hines Signature      Office Manager Position with Company  
 Applicant's E-mail: Kim@tenexconstruction.com Applicant's Phone #: 972-913-8883  
Rocky Stockman Direct Supervisor's Name      214-202-9093 Phone Number      Tenex Construction Company Name

Supervisor's E-mail: \_\_\_\_\_

**FOR ADDISON USE ONLY**

Received By: Unore S Entered?  Yes      Received Date: 6-22-18  
 Approved By: [Signature] Inspector: JE Issue Date: 6/26/18  
 Plans Submitted?  Yes  No  N/A Traffic Control Plan submitted?  Yes  No  N/A Expiration Date: 7/11/18  
 Insurance Provided?  Yes  No  On File Performance/Maintenance Bond?  Yes  No  On File  N/A  
 Fee Paid: NA Receipt #: CTP Processed By: Unore S  
 Picked Up By: Rocky Company: Tenex Date & Time: 6/26/18

TOWN OF ADDISON INFRASTRUCTURE AND DEVELOPMENT SERVICES DEPARTMENT  
 ATTN.: RIGHT OF WAY PERMIT - DAVE WILDE 972-450-2847  
 16801 WESTGROVE RD. ADDISON, TX 75001-9010  
 PHONE: 972-450-2871 FAX: 972-450-2837

3:12PM



**FOR ADDISON USE ONLY**  
 Permit Number: W-1455  
 Location: 3913 Bobbin

**APPLICATION**  
**Right of Way Work Permit -FRANCHISE**  
 (For Franchise Utility/CTP - Street Cut/Excavation/Lane Closure)

**Sub-Contractor List**

PLEASE PRINT LEGIBLY

General Contractor's Name: Tenex Construction General Contractor's Phone #: 972-913-8883

**Sub-Contractor #1** Company Name: Magdeleno Almaraz Address: \_\_\_\_\_

Print Sub-Contractor's Name: Magdeleno Almaraz Sub-Contractor Phone #: 972-872-5271

Sub-Contractor's E-mail: \_\_\_\_\_

Print Site Supervisor's Name: Rocky Stockman Supervisor's Phone #: 214-202-9093

Site Supervisor's E-mail: \_\_\_\_\_

Insurance Provided?  Yes  No  On File

**Sub-Contractor #2** Company Name: Ascension Rodriguez Address: \_\_\_\_\_

Print Sub-Contractor's Name: Ascension Rodriguez Sub-Contractor Phone #: 972-394-0971

Sub-Contractor's E-mail: \_\_\_\_\_

Print Supervisor's Name: Rocky Stockman Supervisor's Phone #: 214-202-9093

Site Supervisor's E-mail: \_\_\_\_\_

Insurance Provided?  Yes  No  On File

**Sub-Contractor #3** Company Name: Tomacito Espinal Address: \_\_\_\_\_



Print Sub-Contractor's Name: Tomacito Espinal Sub-Contractor Phone #: 1-214-218-5271

Sub-Contractor's E-mail: \_\_\_\_\_

Print Supervisor's Name: Rocky Stockman Supervisor's Phone #: 214-202-9093


Site Supervisor's E-mail: \_\_\_\_\_

Insurance Provided?  Yes  No  On File

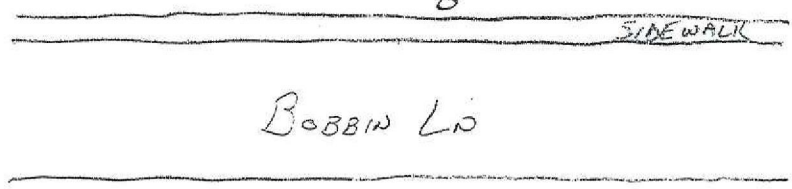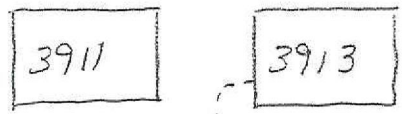

AT&T/TELEX CONST  
WD 9768422  
3913 BOBBIN LN  
ADDISON

**RIGHT OF WAY, EXCAVATION &  
LANE CLOSURE PERMIT**

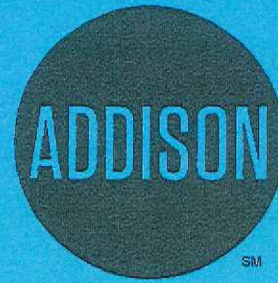

**INFRASTRUCTURE &  
DEVELOPMENT SERVICES**

16801 WESTGROVE DRIVE  
ADDISON, TEXAS 75001  
972.450.2871

**W-1455**

PERMIT NUMBER

**6/26/18**

START DATE

**7/06/18**

EST. COMPLETION DATE

**TENEX CONST**

CONTRACTOR

**AT&T**

FOR

**3913 BOBBIN**

LOCATION (ADDRESS)

**FROM HANDHOLE @ ROW, TO WEST SIDE OF ADDRESS 3913**

LOCATION (ACTUAL)

**INSTALL SERVICE TO BUILDING**

TYPE OF WORK

THIS CARD MUST BE DISPLAYED ON THE JOB SITE AT ALL TIMES.