



FOR ADDISON USE ONLY
 Permit Number: W-1453
 Location: 4021 Dome

APPLICATION
Right of Way Work Permit-FRANCHISE

(For Franchise Utility/CTP – Street Cut/Excavation/Lane Closure)

PLEASE PRINT LEGIBLY

Date of Application: 6/22/18
 Facility Owner Company: AT+T Company Phone #: 800-924-9420
 Utility/CTP Representative: Ramon Aziz Cell Phone #: 214-538-5536
 Utility/CTP Representative E-mail: _____
 General Contractor: Tenex Construction Company Phone #: 972-913-8883
 Site Supervisor Name: Rocky Stockman 24-hour Phone #: 214-202-9093
 Contractor E-mail: _____ Site Foreman E-mail: Rocky@tenexconstruction.com
 Work Site Address and Location: 4021 Dome Dr

Purpose and general description of work: Placement of Phone Service Drop
 Proposed Start Work Date: 6/25/18 Estimated Completion Date: 7/6/18

Pavement Cut? Yes No Directional Bore/Boring? Yes No Excavation? Yes No
 Lane Closure? Yes No Other: _____

Kim Hines Applicant's Printed Name Kim Hines Signature Office Manager Position with Company
 Applicant's E-mail: kim@tenexconstruction.com Applicant's Phone #: 972-913-8883
Rocky Stockman Direct Supervisor's Name 214-202-9093 Phone Number Tenex Construction Company Name

Supervisor's E-mail: _____

FOR ADDISON USE ONLY

Received By: Nicole S Entered? Yes Received Date: 6-22-18
 Approved By: Dave Wilde Inspector: JE Issue Date: 6/26/18
 Plans Submitted? Yes No N/A Traffic Control Plan submitted? Yes No N/A Expiration Date: 7/4/18
 Insurance Provided? Yes No On File Performance/Maintenance Bond? Yes No On File N/A
 Fee Paid: NA Receipt #: CTP Processed By: Nicole S
 Picked Up By: Rocky Company: Tenex Date & Time: 6/26/18

TOWN OF ADDISON INFRASTRUCTURE AND DEVELOPMENT SERVICES DEPARTMENT 3:12PM
 ATTN.: RIGHT OF WAY PERMIT - DAVE WILDE 972-450-2847
 16801 WESTGROVE RD. ADDISON, TX 75001-9010
 PHONE: 972-450-2871 FAX: 972-450-2837



FOR ADDISON USE ONLY
 Permit Number: W-1453
 Location: 4021 Dome

APPLICATION
Right of Way Work Permit -FRANCHISE
 (For Franchise Utility/CTP - Street Cut/Excavation/Lane Closure)

Sub-Contractor List

PLEASE PRINT LEGIBLY

General Contractor's Name: Tenex Construction General Contractor's Phone #: 972-913-8883

Sub-Contractor #1 Company Name: Magdeleno Almarez Address: _____

Print Sub-Contractor's Name: Magdeleno Almarez Sub-Contractor Phone #: 972-872-5271

Sub-Contractor's E-mail: _____

Print Site Supervisor's Name: Rocky Stockman Supervisor's Phone #: 214-202-9093

Site Supervisor's E-mail: _____

Insurance Provided? | Yes | No On File

Sub-Contractor #2 Company Name: Ascension Rodriguez Address: _____

Print Sub-Contractor's Name: Ascension Rodriguez Sub-Contractor Phone #: 972-394-0971

Sub-Contractor's E-mail: _____

Print Supervisor's Name: Rocky Stockman Supervisor's Phone #: 214-202-9093

Site Supervisor's E-mail: _____

Insurance Provided? | Yes | No On File

Sub-Contractor #3 Company Name: Tomacito Espinal Address: _____


Print Sub-Contractor's Name: Tomacito Espinal Sub-Contractor Phone #: 1-214-218-5271

Sub-Contractor's E-mail: _____

Print Supervisor's Name: Rocky Stockman Supervisor's Phone #: 214-202-9093


Site Supervisor's E-mail: _____

Insurance Provided? | Yes | No | On File

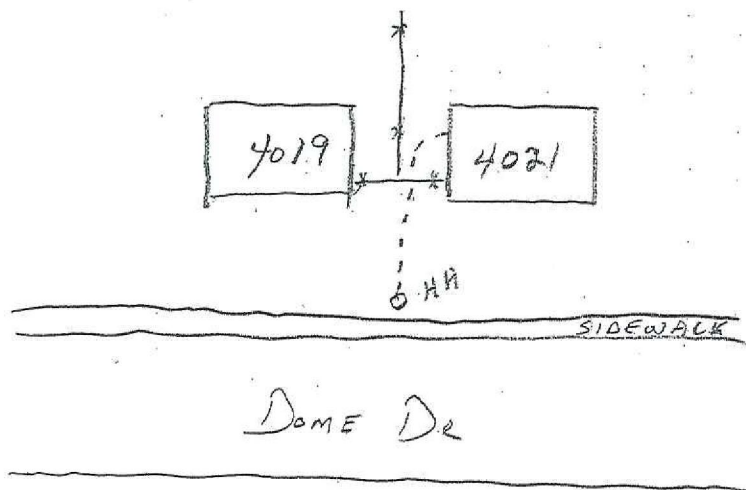

AT&T / TENEX CONST
WO 9769049
4021 DOME DR
ADDISON

RIGHT OF WAY, EXCAVATION &
LANE CLOSURE PERMIT

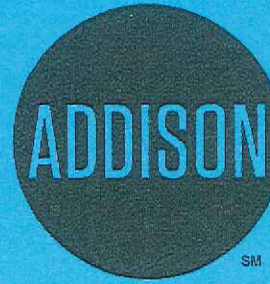

INFRASTRUCTURE &
DEVELOPMENT SERVICES

16801 WESTGROVE DRIVE
ADDISON, TEXAS 75001
972.450.2871

W-1453

PERMIT NUMBER

6/26/18

START DATE

7/06/18

EST. COMPLETION DATE

TENEX CONST

CONTRACTOR

AT&T

FOR

4021 DOME

LOCATION (ADDRESS)

FROM HANDHOLE @ ROW, TO WEST SIDE OF ADDRESS 4021

LOCATION (ACTUAL)

INSTALL SERVICE TO BUILDING

TYPE OF WORK

THIS CARD MUST BE DISPLAYED ON THE JOB SITE AT ALL TIMES.