



FOR ADDISON USE ONLY
 Permit Number: W-1460
 Location: 14540 MIDWAY

APPLICATION
Right of Way Work Permit-FRANCHISE

(For Franchise Utility/CTP – Street Cut/Excavation/Lane Closure)

PLEASE PRINT LEGIBLY

Date of Application: 6-26
 Facility Owner Company: Spectrum Company Phone #: _____
 Utility/CTP Representative: Stephen Cross Cell Phone #: 469-416-7677
 Utility/CTP Representative E-mail: Stephen.Cross@charter.com
 General Contractor: GTI Company Phone #: 910-329-9933
 Site Supervisor Name: Mike Hulvey 24-hour Phone #: 469-853-5420
 Contractor E-mail: mike@gardner100 Site Foreman E-mail: SAME
 Work Site Address and Location: Clampitt Paper Co. 14540 Midway Rd.
 Purpose and general description of work: 5 spans overlap, existing conduit in Farmers Branch
 Proposed Start Work Date: 7-7-18 Estimated Completion Date: 8-7-18
 Pavement Cut? Yes No Directional Bore/Boring? Yes No Excavation? Yes No
 Lane Closure? Yes No Other: _____
 Applicant's Printed Name: Mike Hulvey Signature: Mike Hulvey Position with Company: Supervisor
 Applicant's E-mail: SAME Applicant's Phone #: SAME
 Direct Supervisor's Name: Stephen Cross Phone Number: SAME Company Name: Spectrum
 Supervisor's E-mail: SAME

FOR ADDISON USE ONLY

Received By: Nicole S Entered? Yes No Received Date: 6/26/18
 Approved By: Dave Wilde Inspector: DWJSE Issue Date: 7/3/18
 Plans Submitted? Yes No N/A Traffic Control Plan submitted? Yes No N/A Expiration Date: 7/18/18
 Insurance Provided? Yes No On File Performance/Maintenance Bond? Yes No On File N/A
 Fee Paid: NA Receipt #: CTP Processed By: Nicole S
 Picked Up By: Mike Company: GTI Date & Time: 7/5/18 11:14AM

TOWN OF ADDISON INFRASTRUCTURE AND DEVELOPMENT SERVICES DEPARTMENT
 ATTN.: RIGHT OF WAY PERMIT - DAVE WILDE 972-450-2847
 16801 WESTGROVE RD. ADDISON, TX 75001-9010
 PHONE: 972-450-2871 FAX: 972-450-2837



| | |
|----------------------|---------------------|
| FOR ADDISON USE ONLY | |
| Permit Number: | <u>W-1460</u> |
| Location: | <u>14540 MIDWAY</u> |

APPLICATION
Right of Way Work Permit -FRANCHISE
 (For Franchise Utility/CTP - Street Cut/Excavation/Lane Closure)

Sub-Contractor List

PLEASE PRINT LEGIBLY

General Contractor's Name: G-T-I General Contractor's Phone #: 972-329-9933

Sub-Contractor #1 Company Name: Ventura Address: _____
 Print Sub-Contractor's Name: Simon Ventura Sub-Contractor Phone #: 214-991-5948
 Sub-Contractor's E-mail: _____

Print Site Supervisor's Name: _____ Supervisor's Phone #: _____
 Site Supervisor's E-mail: _____
 Insurance Provided? Yes No On File

Sub-Contractor #2 Company Name: _____ Address: _____

Print Sub-Contractor's Name: _____ Sub-Contractor Phone #: _____
 Sub-Contractor's E-mail: _____
 Print Supervisor's Name: _____ Supervisor's Phone #: _____
 Site Supervisor's E-mail: _____
 Insurance Provided? Yes No On File

Sub-Contractor #3 Company Name: _____ Address: _____

Print Sub-Contractor's Name: _____ Sub-Contractor Phone #: _____
 Sub-Contractor's E-mail: _____
 Print Supervisor's Name: _____ Supervisor's Phone #: _____
 Site Supervisor's E-mail: _____
 Insurance Provided? Yes No On File

RIGHT OF WAY, EXCAVATION &
LANE CLOSURE PERMIT



INFRASTRUCTURE &
DEVELOPMENT SERVICES

16801 WESTGROVE DRIVE
ADDISON, TEXAS 75001
972.450.2871

W-1460

PERMIT NUMBER

7/07/18

START DATE

8/07/18

EST. COMPLETION DATE

GTI

CONTRACTOR

SPECTRUM

FOR

14540 MIDWAY

LOCATION (ADDRESS)

RIGHT NB LANE OF MIDWAY FROM ADDRESS TO BELT LIN

LOCATION (ACTUAL)

5 SPANS OF OVERLASH TO EXISTING CONDUIT


TYPE OF WORK

THIS CARD MUST BE DISPLAYED ON THE JOB SITE AT ALL TIMES.

Spectrum

CLAMPITT PAPER COMPANY
14540 MIDWAY RD
FARMERS BRANCH, TEXAS

4
Addison
VICINITY MAP

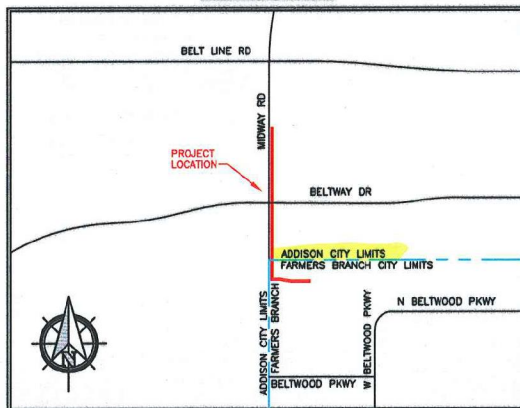

GENERAL PROJECT NOTES


1. ALL CONSTRUCTION WORK WITHIN THE PUBLIC RIGHT-OF-WAY SHALL BE DONE IN ACCORDANCE WITH THE ORDINANCES AND REGULATIONS OF THE MUNICIPALITY IN WHICH THE WORK IS TO BE PERFORMED.
2. EXISTING UTILITY LOCATIONS SHOWN ARE TAKEN FROM AVAILABLE RECORDS AND MAY NOT BE ALL INCLUSIVE. UTILITY LOCATIONS ARE GENERALLY SCHEMATIC IN NATURE AND MAY NOT ACCURATELY REFLECT THE SIZE AND LOCATION OF EACH PARTICULAR UTILITY. THE CONSTRUCTION CONTRACTOR SHALL ASSUME RESPONSIBILITY FOR ACTUAL LINE LOCATES IN THE FIELD AND THE PROTECTION OF ALL EXISTING FACILITIES WHETHER SHOWN OR NOT. THE CONSTRUCTION CONTRACTOR SHALL ALSO ASSUME RESPONSIBILITY FOR REPAIRS TO ANY EXISTING FACILITY DAMAGED AS A DIRECT RESULT OF THE CONSTRUCTION ACTIVITIES WHETHER THE FACILITY IS SHOWN ON THE DRAWINGS OR NOT.
3. THE CONSTRUCTION CONTRACTOR SHALL BE RESPONSIBLE FOR CONTACTING ALL DEPARTMENTS WITHIN THE MUNICIPALITY AND THE UTILITY COMPANIES AT LEAST TWO WORKING DAYS PRIOR TO THE COMMENCEMENT OF WORK.

CALL BEFORE YOU DIG
811
IT'S THE LAW


4. IT SHALL BE THE RESPONSIBILITY OF THE CONSTRUCTION CONTRACTOR TO: A) PREVENT DAMAGE TO PRIVATE AND PUBLIC PROPERTY. B) RESTORE ALL AREAS EFFECTED BY THE CONSTRUCTION TO ORIGINAL OR BETTER CONDITION.
5. BARRICADING AND TRAFFIC CONTROL SHALL BE THE RESPONSIBILITY OF THE CONSTRUCTION CONTRACTOR AND SHALL CONFORM TO THE "TEXAS MANUAL ON UNIFORM TRAFFIC CONTROL DEVICES". TRAFFIC FLOW AND ACCESS SHALL BE MAINTAINED DURING ALL PHASES OF CONSTRUCTION. THE CONSTRUCTION CONTRACTOR IS RESPONSIBLE FOR PROVIDING TRAFFIC SAFETY MEASURES FOR WORK ON THE PROJECT. THE WORK SITE SHALL BE SUITABLY LIT AND BARRICADED AT NIGHT.
6. THE CONSTRUCTION CONTRACTOR SHALL ABIDE BY ALL APPLICABLE FEDERAL, STATE AND LOCAL LAWS GOVERNING EXCAVATION. THE CONSTRUCTION CONTRACTOR SHALL PROVIDE ALL TRENCH SAFETY SYSTEMS THAT COMPLY WITH ALL LAWS GOVERNING EXCAVATION. THE CONSTRUCTION CONTRACTOR SHALL BE SOLELY RESPONSIBLE FOR ALL ASPECTS OF WORK RELATED TO EXCAVATION.
7. ALL CONCRETE USED IN ANY ROADWAY SHALL BE IN COMPLIANCE WITH THE SPECIFIED CLASSES OF CONCRETE IN THE STANDARD SPECIFICATIONS 5.8 "PORTLAND CEMENT CONCRETE PAVEMENT" AND 7.4.5 "QUALITY OF CONCRETE" AS AMENDED BY THE ADDENDUM TO THE NORTH CENTRAL TEXAS STANDARD SPECIFICATIONS FOR PUBLIC WORKS CONSTRUCTION - 2004. ALL OTHER CONCRETE SHALL BE CLASS A CONCRETE.
8. ALL REINFORCING STEEL AND DOWEL BARS IN PAVEMENT SHALL BE SUPPORTED AND MAINTAINED AT THE CORRECT CLEARANCES BY THE USE OF BAR CHAINS OR OTHER APPROVED SUPPORT.
9. ALL CONDUIT MUST BE PLACED WITH A MINIMUM 42" OF COVER, UNLESS OTHERWISE SPECIFIED.
10. ALL BACKFILLING WILL BE MECHANICALLY TAMPED IN LIFTS TO A DENSITY OF 95% PROCTOR. THE REQUIRED DENSITY WILL BE OBTAINED BY USING TAMPERS, RAMMERS OR ROLLING EQUIPMENT. LIFTS MAY VARY ACCORDING TO THE TYPE OF EQUIPMENT USED TO OBTAIN THE REQUIRED DENSITY. SAND AND DEBRIS FREE MATERIAL WILL BE USED FOR BACKFILL.

DFWT CONTACT: DAVID HATTON 972.670.2113



PREPARED BY: DFW TELECOM, INC.

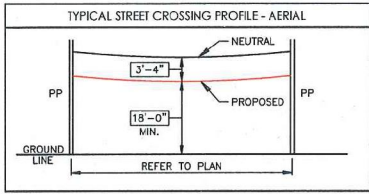

TYPICAL UTILITY CROSSING

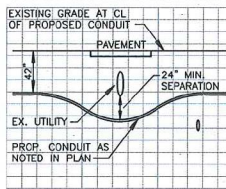

TRENCH DETAIL

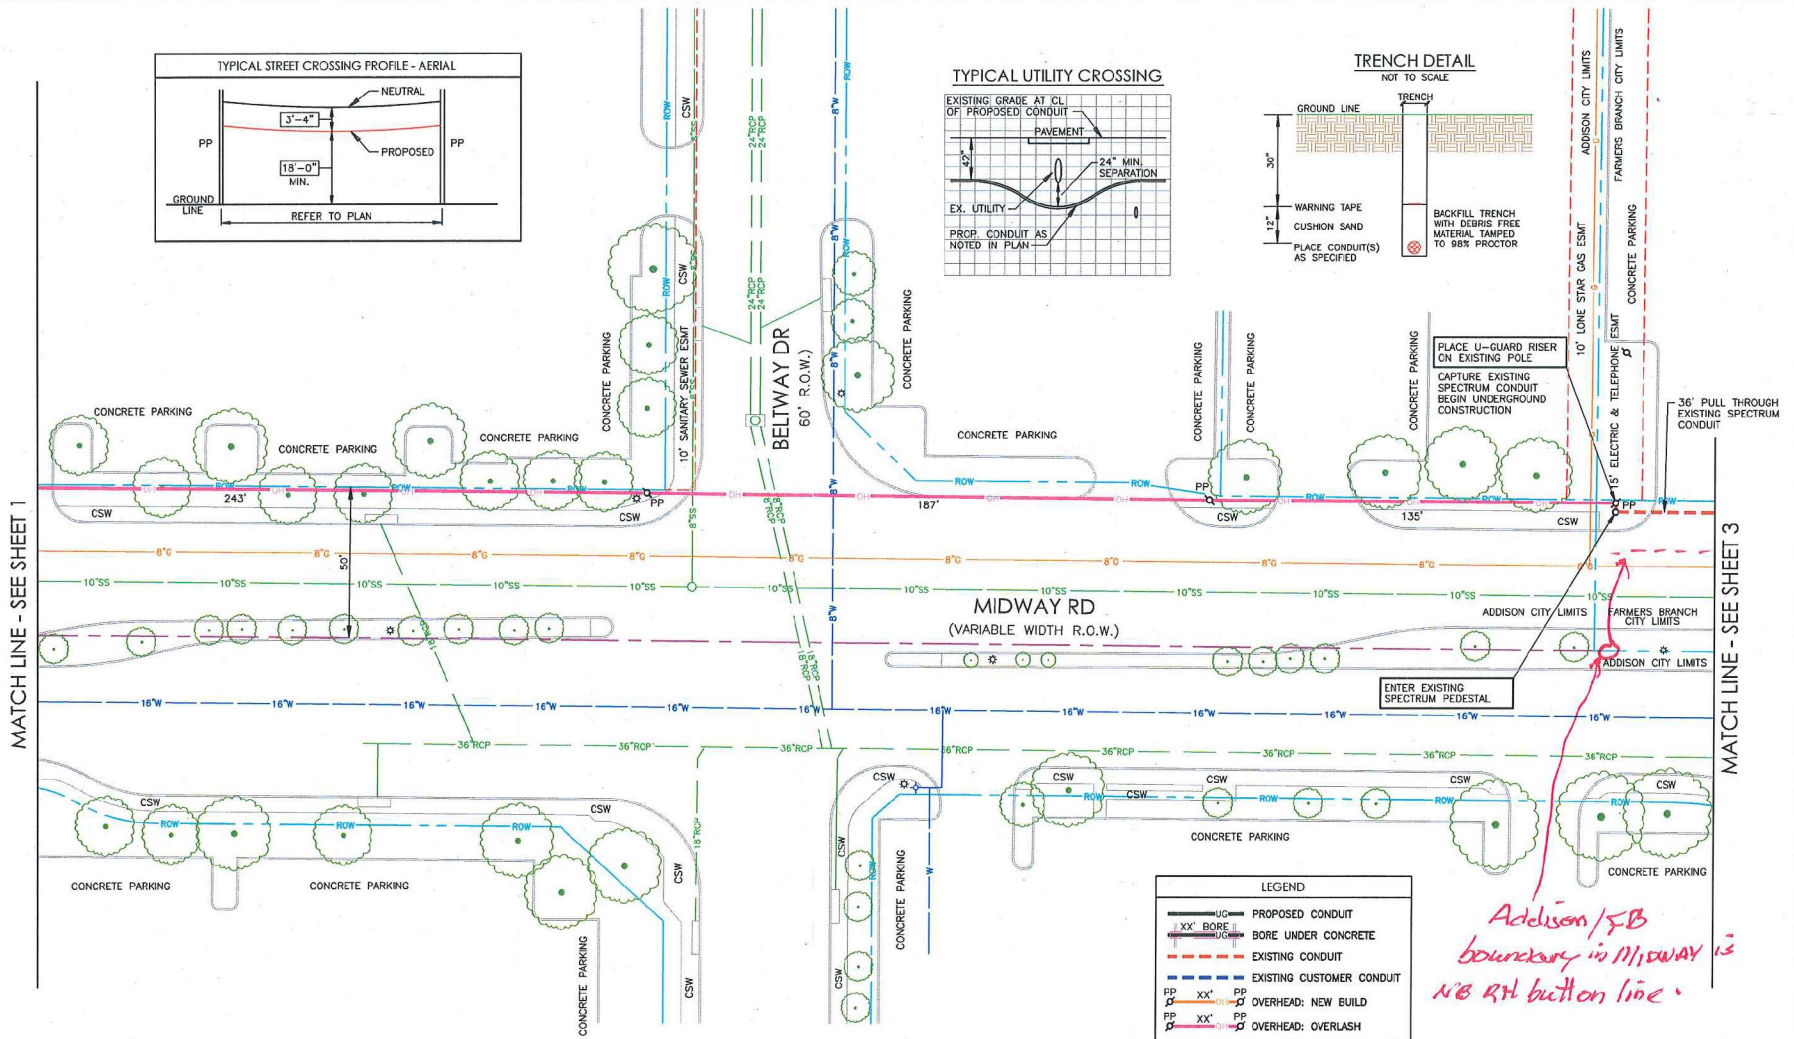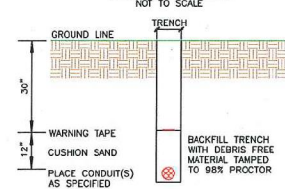

LEGEND

- UG PROPOSED CONDUIT
- XX' BORE UNDER CONCRETE
- EXISTING CONDUIT
- EXISTING CUSTOMER CONDUIT
- PP XX' OVERHEAD: NEW BUILD
- PP XX' OVERHEAD: OVERLASH

Addison/FB boundary is Midway rd NB RT button line

MATCH LINE - SEE SHEET 1

MATCH LINE - SEE SHEET 3

PREPARED BY:


 DFW CONTACT:
 DAVID HATTON 972.670.2113

| ESTIMATED SHEET TOTALS | | | |
|-------------------------------|----------|-------------------------|----------|
| DESCRIPTION | QUANTITY | DESCRIPTION | QUANTITY |
| TRENCH & PLACE CONDUIT | | PLACE FLUSH MOUNT VAULT | |
| BORE & PLACE CONDUIT | | PLACE PEDESTAL | |
| BORE & PLACE STEEL CASING | | PLACE FLUSH DROP BUCKET | |
| PULL THROUGH EXISTING CONDUIT | 36' | PLACE POWER SUPPLY | |
| R & R CONCRETE SIDEWALK (SF) | | PLACE WALL BOX & RISER | |
| R & R CONCRETE PAVEMENT (SF) | | PLACE U-GUARD RISER | 1 |
| OVERHEAD: OVERLASH | 565' | OVERHEAD: NEW BUILD | |





PROJECT: CLAMPITT PAPER COMPANY
 ADDRESS: 14540 MIDWAY RD
 CITY, STATE: FARMERS BRANCH, TEXAS


| | | | |
|------------------------------|----------------------------|-----------------------------|---------------------|
| HORIZONTAL SCALE 1" = 40' | VERTICAL SCALE 1" = 10' | JOB NUMBER: PID - 642235 | DATE: 06-22-2018 |
|------------------------------|----------------------------|-----------------------------|---------------------|

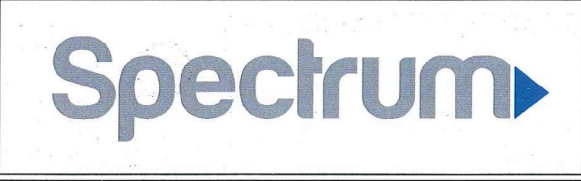


MATCH LINE - SEE SHEET 2

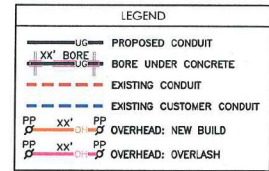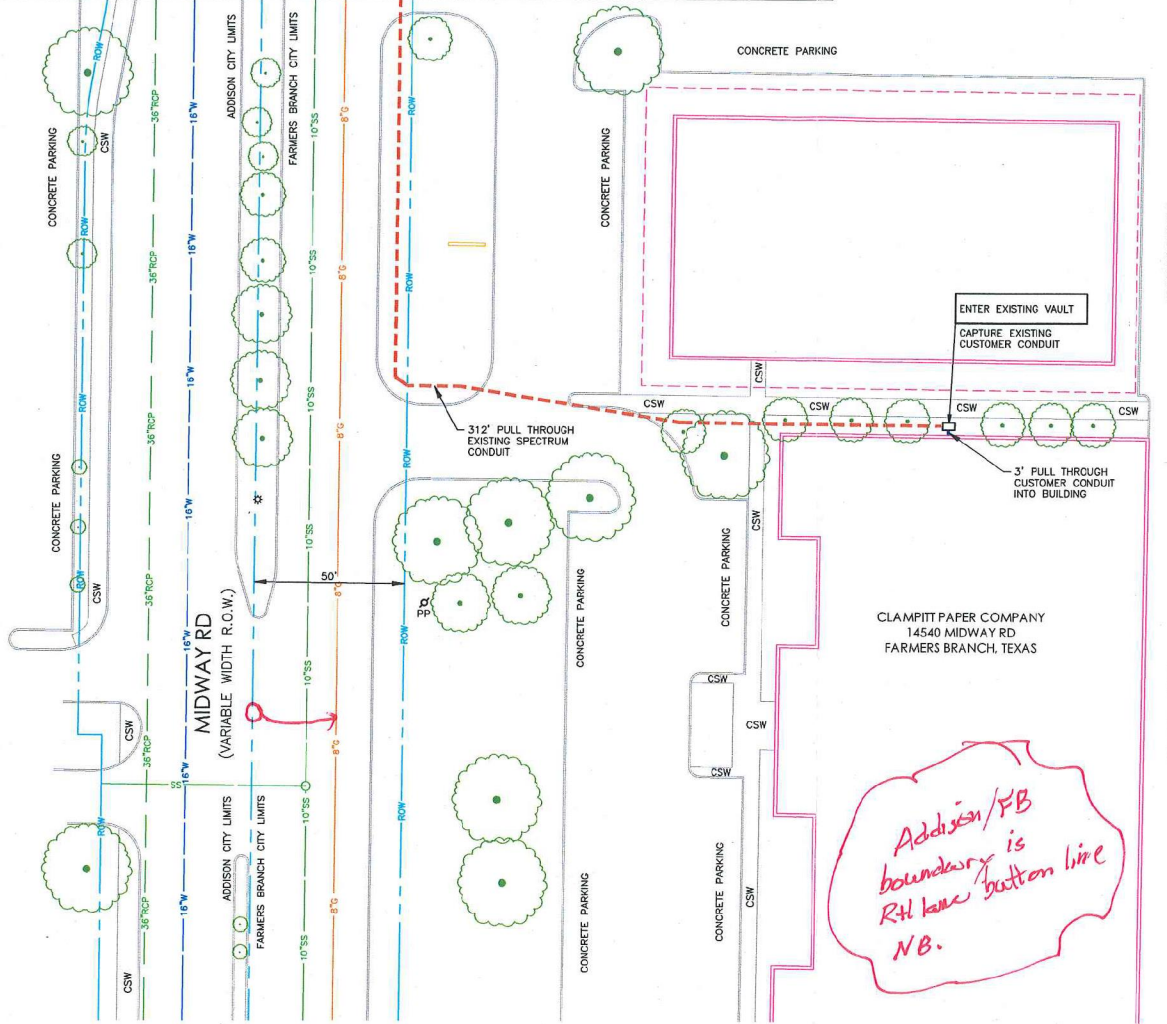


TYPICAL UTILITY CROSSING

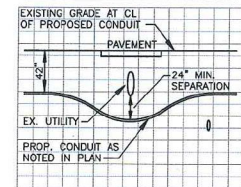

TRENCH DETAIL
NOT TO SCALE

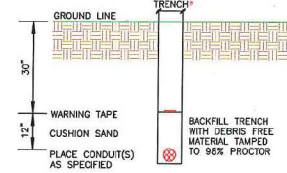

TYPICAL STREET CROSSING PROFILE - AERIAL

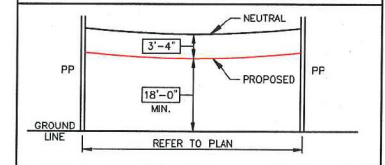

PREPARED BY:



DFWT CONTACT:
DAVID HATION 972.670.2113

ESTIMATED SHEET TOTALS

| DESCRIPTION | QUANTITY | DESCRIPTION | QUANTITY |
|-------------------------------|----------|-------------------------|----------|
| TRENCH & PLACE CONDUIT | | PLACE FLUSH MOUNT VAULT | |
| BORE & PLACE CONDUIT | | PLACE PEDESTAL | |
| BORE & PLACE STEEL CASING | | PLACE FLUSH DROP BUCKET | |
| PULL THROUGH EXISTING CONDUIT | 315' | PLACE POWER SUPPLY | |
| R & R CONCRETE SIDEWALK (SF) | | PLACE WALL BOX & RISER | |
| R & R CONCRETE PAVEMENT (SF) | | PLACE U-GUARD RISER | |
| OVERHEAD: OVERLASH | | OVERHEAD: NEW BUILD | |

NORTH



SHEET
3 OF 3

PROJECT: CLAMPITT PAPER COMPANY

ADDRESS: 14540 MIDWAY RD
CITY, STATE: FARMERS BRANCH, TEXAS

HORIZONTAL SCALE
1" = 40'

VERTICAL SCALE
1" = 10'

JOB NUMBER:
PID - 642235

DATE:
06-22-2018

Spectrum