



FOR ADDISON USE ONLY
 Permit Number: W-1459
 Location: 3905 River Ln

APPLICATION
Right of Way Work Permit-FRANCHISE

(For Franchise Utility/CTP - Street Cut/Excavation/Lane Closure)

PLEASE PRINT LEGIBLY

Date of Application: 6.27.18
 Facility Owner Company: AT&T Company Phone #: _____
 Utility/CTP Representative: Ronald Leeper Cell Phone #: 214-500-7662
 Utility/CTP Representative E-mail: rl658@att.com
 General Contractor: The Wilkins Group Company Phone # 972-479-1090
 Site Supervisor Name: Mike Williams 24-hour Phone # 910-286-3928
 Contractor E-mail: andrea@wilkins.com Site Foreman E-mail: MIKEN@WILKINS.COM
 Work Site Address and Location: 3905 RIVER LN ADDISON, TX 75240

Purpose and general description of work: dig up to repair ATT damaged cable bore from 3905 to 3901 Rive
 Proposed Start Work Date: 6/28/18 7/3/18 Estimated Completion Date: 7/6/18
 Pavement Cut? Yes No but possible Directional Bore/Boring? Yes No Excavation? Yes No locate damaged cable
 Lane Closure? Yes No Other: _____

Applicant's Printed Name: Andrea Bird Signature: [Signature] Position with Company: project manager
 Applicant's E-mail: andrea@wilkins.com Applicant's Phone #: 972-479-1090
 Direct Supervisor's Name: Trena McKinzie Phone Number: 972-479-1090 Company Name: The Wilkins Group
 Supervisor's E-mail: trena@wilkins.com

FOR ADDISON USE ONLY

Received By: DW via Email Entered? Yes Received Date: 6/27/18 10:52 AM
 Approved By: [Signature] Inspector: DW/JS Issue Date: 7/3/18
 Plans Submitted? Yes No N/A Traffic Control Plan submitted? Yes No N/A Expiration Date: 7/18/18
 Insurance Provided? Yes No On File Performance/Maintenance Bond? Yes No On File N/A
 Fee Paid: N/A Receipt #: CTP Processed By: [Signature]
 Picked Up By: benjamin Company: Wilkins Group Date & Time: 7/17/18 3:44 PM

TOWN OF ADDISON INFRASTRUCTURE AND DEVELOPMENT SERVICES DEPARTMENT
 ATTN.: RIGHT OF WAY PERMIT - DAVE WILDE 972-450-2847
 16801 WESTGROVE RD. ADDISON, TX 75001-9010
 PHONE: 972-450-2871 FAX: 972-450-2837

**RIGHT OF WAY, EXCAVATION &
LANE CLOSURE PERMIT**



**INFRASTRUCTURE &
DEVELOPMENT SERVICES**

16801 WESTGROVE DRIVE
ADDISON, TEXAS 75001
972.450.2871

W-1459

PERMIT NUMBER

6/28/18

START DATE

7/06/18

EST. COMPLETION DATE

THE WILKINS GROUP

CONTRACTOR

AT&T

FOR

3905 RIVE LN

LOCATION (ADDRESS)

ROW IN FRONT OF ADDRESSES

LOCATION (ACTUAL)

REPLACE DAMAGED CABLE

TYPE OF WORK

THIS CARD MUST BE DISPLAYED ON THE JOB SITE AT ALL TIMES.

Ticket Start Dt: 06/25/18 07:34:42 Dig Priority Cd: Routine

Phone Nbr: Circuit Nbr :
Request ID: 9786960 Request Type: DIG
Customer Name:UNAVAILABLE CBR Phone: 0000000000
Street Addr: 3905 RIVE LN
City/Township:CITY OF ADDISON State: TX Zip: 75240
Terminal Addr:3905 RIVE LN
Request Dt: 06/19/18 Promised Dt: 06/29/18
Wire Center: 972239 ADDISON FRC:
Subdistrict: DLSNTH Bid Area:CDL01 Center: NET Cust Type: A
County: DALLAS Township:
Subdivision: Section: Lot: 3905 RIVE

LN

Crossroad: AZURE LN
Job Types 1:NO DISPATCH 2:X 3:X
4:X 5:X 6:X
7: 8: 9:
10:

Remarks: IN FRONT OF 3905 RIVE LN NEED SPLICE PIT/,LOOKING FOR 25 PR CABLE/,FROM THERE WILL NEED TO BORE 55 FT TO 3901 RIVE LN/,ORG PAINT MARKINGS ON GRD/.ANY QUESTIONS PKEASE CALL ME RON/@214/-500/-7662/,THANKS/,I WILL BE MOVING THE ENC SPLICE FROM

Tech Id: rl6158 RONALD LEEPER 2145007662
Field Mng: rb8328 RONNIE BANNISTER 2148864413
Area Mng: cg8685 CARLA HUSEMAN 8176946172

***** Estimated Work Required Information *****

Table with 5 columns: Held Order? N, Emergency? N, Permit? N, Temporary Wire? N, Article, Article Description, Conditions, Wire Center, Qty. Rows include PB (Pneumatic bore) and SP (SPLICE PIT EACH).

Photo Title



📍 location unknown

Michael Williams 06/27/18 09:24 AM

This is the location for the splice pit

Photo Title




📍 32.946508, -96.847080

Michael Williams 06/27/18 09:26 AM

Will need to make a boy at this location

Photo Title

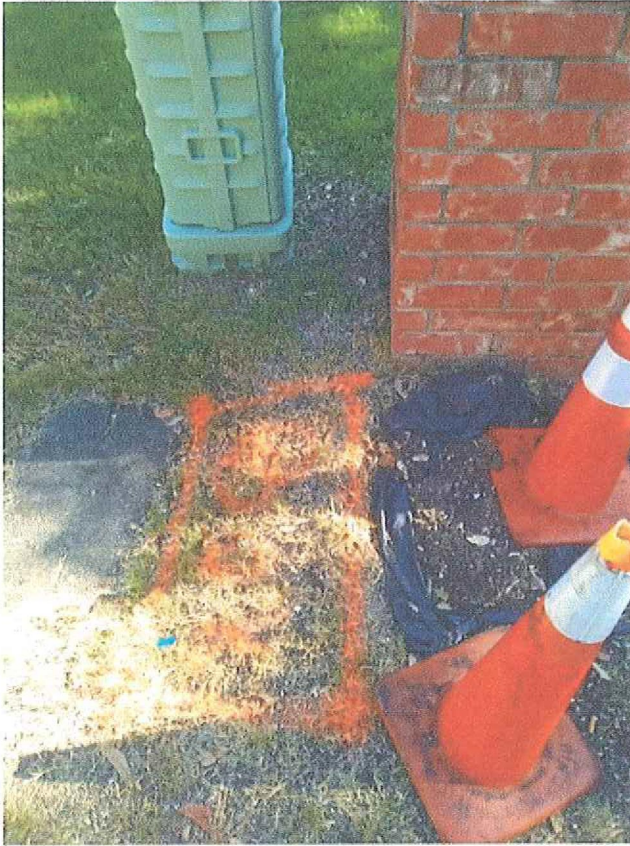

📍 location unknown

Michael Williams 06/27/18 09:28 AM

ped will be set here