



FOR ADDISON USE ONLY
 Permit Number: W-1498
 Location: 3912 Azure Ln.

APPLICATION
Right of Way Work Permit-FRANCHISE

(For Franchise Utility/CTP – Street Cut/Excavation/Lane Closure)

PLEASE PRINT LEGIBLY

Date of Application: 8/1/18
 Facility Owner Company: AT&T Company Phone #: 800-924-9420
 Utility/CTP Representative: Ramon Aziz Cell Phone #: 214-538-5536
 Utility/CTP Representative E-mail: _____
 General Contractor: Tenex Construction Company Phone # 972-913-8883
 Site Supervisor Name: Rocky Stockman 24-hour Phone # 214-202-9093
 Contractor E-mail: _____ Site Foreman E-mail: Rocky@tenexconstruction.com
 Work Site Address and Location: 3912 AZURE LN
 Purpose and general description of work: Placement of Phone Service Drop
 Proposed Start Work Date: 8/3/18 Estimated Completion Date: 8/17/18
 Pavement Cut? Yes No Directional Bore/Boring? Yes No Excavation? Yes No
 Lane Closure? Yes No Other: _____
Kim Hines Kim Hines Office Manager
 Applicant's Printed Name Signature Position with Company
 Applicant's E-mail: Kim@tenexconstruction.com Applicant's Phone #: 972-913-8883
Rocky Stockman 214-202-9093 Tenex Construction
 Direct Supervisor's Name Phone Number Company Name
 Supervisor's E-mail: _____

FOR ADDISON USE ONLY

Received By: [Signature] Entered? Yes Received Date: 8-1-18
 Approved By: [Signature] Inspector: JF Issue Date: 8/3/18
 Plans Submitted? Yes No N/A Traffic Control Plan submitted? Yes No N/A Expiration Date: 8/17/18
 Insurance Provided? Yes No On File Performance/Maintenance Bond? Yes No On File N/A
 Fee Paid: NA Receipt #: CTP Processed By: [Signature]
 Picked Up By: Rocky Company: Tenex Date & Time: 12:04PM

TOWN OF ADDISON INFRASTRUCTURE AND DEVELOPMENT SERVICES DEPARTMENT
 ATTN.: RIGHT OF WAY PERMIT - DAVE WILDE 972-450-2847
 16801 WESTGROVE RD. ADDISON, TX 75001-9010
 PHONE: 972-450-2871 FAX: 972-450-2837



FOR ADDISON USE ONLY
 Permit Number: W-1498
 Location: 3912 Azure Ln

APPLICATION
Right of Way Work Permit -FRANCHISE
 (For Franchise Utility/CTP - Street Cut/Excavation/Lane Closure)

Sub-Contractor List

PLEASE PRINT LEGIBLY

General Contractor's Name: Tenex Construction General Contractor's Phone #: 972-913-8883

Sub-Contractor #1 Company Name: Magdeleno Almaraz Address: _____

Print Sub-Contractor's Name: Magdeleno Almaraz Sub-Contractor Phone #: 972-872-5271

Sub-Contractor's E-mail: _____

Print Site Supervisor's Name: Rocky Stockman Supervisor's Phone #: 214-202-9093

Site Supervisor's E-mail: _____

Insurance Provided? | Yes | No | On File

Sub-Contractor #2 Company Name: Ascension Rodriguez Address: _____

Print Sub-Contractor's Name: Ascension Rodriguez Sub-Contractor Phone #: 972-394-0971

Sub-Contractor's E-mail: _____

Print Supervisor's Name: Rocky Stockman Supervisor's Phone #: 214-202-9093

Site Supervisor's E-mail: _____

Insurance Provided? | Yes | No | On File

Sub-Contractor #3 Company Name: Tomacito Espinal Address: _____

Print Sub-Contractor's Name: Tomacito Espinal Sub-Contractor Phone #: 1-214-218-5271


Sub-Contractor's E-mail: _____

Print Supervisor's Name: Rocky Stockman Supervisor's Phone #: 214-202-9093

Site Supervisor's E-mail: _____

Insurance Provided? | Yes | No | On File

AT-T / TENEX CONST
WO 9936408
3912 AZURE LN
ADDISON

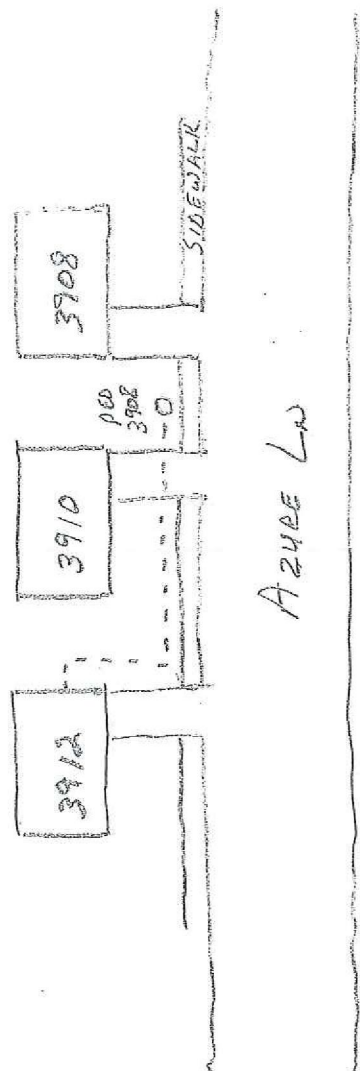

RIGHT OF WAY, EXCAVATION &
LANE CLOSURE PERMIT

W-1498

PERMIT NUMBER

8/03/18

START DATE

8/17/18

EST. COMPLETION DATE

TENEX CONST

CONTRACTOR

3912 AZURE LN

FOR

AT&T


LOCATION (ADDRESS)

FROM PEDESTAL AT 3908 ACROSS DRIVE TO WEST SIDE OF HOUSE

LOCATION (ACTUAL)

INSTALL SERVICE DROP TO ADDRESS

TYPE OF WORK

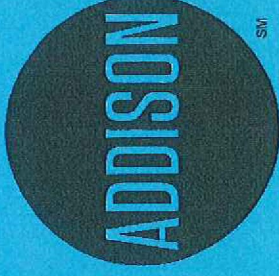

**INFRASTRUCTURE &
DEVELOPMENT SERVICES**

16801 WESTGROVE DRIVE
ADDISON, TEXAS 75001
972.450.2871